



Selwyn District Council

Darfield Water Treatment Facility

Notice of Requirement

August 2020

Form 20

NOTICE OF TERRITORIAL AUTHORITY'S REQUIREMENTS FOR DESIGNATION OR ALTERATION OF DESIGNATION

Section 168A Resource Management Act 1991

To: Selwyn District Council
2 Norman Kirk Drive
Rolleston 7643

Attention: The Chief Executive

Selwyn District Council (SDC) gives notice of its requirement for a designation for a public work.

The site to which the requirement applies is located at 160 Bangor Road in Selwyn District, and is legally described as Section 1 SO Plan 438579. A copy of the Certificate of Title is attached as **Appendix A**.

A description of the site and surrounds is contained in Section 3.

The nature of the proposed work is:

To designate land used as an existing water treatment facility. The designation will cover the existing water reservoir, pump station and control buildings as well as the proposed new water treatment plant building, and land for future expansion. The nature of the proposed work is outlined further in Section 2.

The effects that the public work will have on the environment, and the ways in which any adverse effects will be mitigated, are described in Section 6.

Alternative sites, routes, and methods have been considered to the extent described in Section 5.

The public work and designation are reasonably necessary for achieving the objectives of the territorial authority for the reasons as set out in Section 4.

The following resource consents are likely to be required for the proposed activity.

Canterbury Land and Water Regional Plan 2017 (LWRP)

- A discharge permit to discharge operational stormwater and operational water to land, under Rules 5.97 and 5.100 of the LWRP; and
- A discharge permit to discharge construction-phase stormwater to land under Rule 5.94B of the LWRP.

Resource consent under the rules listed above (if required) will be submitted to Environment Canterbury before construction of the Water Treatment Plant commences.

SDC attaches all relevant information required to be included in this notice by the district plan, regional plan, or any regulations made under the Resource Management Act 1991 (RMA):



Signed on behalf of Selwyn District Council

Amy Callaghan

Name

Dated: 24/08/2020

ADDRESS FOR SERVICE of requiring authority during processing:

Selwyn District Council
C/- Sarah White
GHD Limited
PO Box 13-468
Christchurch 8141

Phone: (03) 363 0825

Email: Sarah.White@ghd.com

ADDRESS FOR SERVICE of requiring authority for compliance and monitoring:

Selwyn District Council
2 Norman Kirk Drive
Rolleston 7643

Attention: Julien Gutknecht

Table of contents

1.	Introduction	1
1.1	Context.....	1
2.	Site description.....	3
3.	Nature of proposed work.....	1
3.1	Height, shape, bulk and location of the works	1
3.2	Vehicular access, circulation and parking	1
3.3	Landscaping.....	1
3.4	Finished contour	2
3.5	Physical works	2
4.	Necessity of works and designation.....	4
5.	Consideration of alternatives	5
6.	Assessment of environmental effects	6
6.1	Positive effects	6
6.2	Construction effects	6
6.3	Operational effects.....	6
6.4	Summary of effects	7
7.	Relevant plan provisions	1
7.1	Canterbury Regional Policy Statement.....	1
7.2	Selwyn District Plan	1
8.	Part 2 RMA – Purpose and Principles	3
9.	Conclusion	4

Table index

Table 1. Assessment against the relevant objectives and policies of the Selwyn District Plan	2
--	---

Figure index

Figure 1. Location of the site to be designated at 160 Bangor Road.....	3
Figure 2. Proposed extent of the designation (shown in red) and existing infrastructure	1
Figure 3. Community Drinking Water Protection Zone Overlays (Source: Canterbury Maps).....	2

Appendices

Appendix A – Certificate of title

Appendix B – Site photos

Appendix C – As built plans of existing infrastructure

Appendix D – Landscaping Plans

Appendix E – Objectives and Policies of the Canterbury Regional Policy Statement

1. Introduction

1.1 Context

SDC seeks to designate land required for a new water treatment plant and existing water reservoir, pump station and control buildings (which are currently not designated).

Part 8 of the RMA relates to designations and heritage orders. Sections 166 to 176A under Part 8 set out the provisions for preparing, assessing and confirming designations, and submitting an Outline Plan of Works (OPW).

Pursuant to Section 166 of the RMA, SDC is a requiring authority and has statutory and financial responsibility for the operation, maintenance and enhancement of the supply of freshwater to the Selwyn District.

Section 168 and 168A

Section 168(2) states that a requiring authority for the purposes approved under Section 167 of the RMA, may at any time give notice of its requirement for a designation. Section 168A applies if a territorial authority decides to issue a notice of requirement for a designation for a public work within its district and for which it has financial responsibility. This Notice of Requirement (NOR) is a new requirement by SDC under Section 168A of the RMA.

Section 168A(3) of the RMA prescribes what the territorial authority must have regard to when considering an NOR.

In accordance with this section, a territorial authority must, subject to Part 2 of the RMA, consider the effects on the environment of allowing the requirement. The effects on the environment allowing this requirement are considered in Section 6 of this report; Part 2 matters are considered in Section 9.

Section 168A(3)(a)-(d) sets out the particular matters that a territorial authority must have regard to when considering the effects on the environment of allowing the requirement:

- a) An assessment of the proposal against the relevant planning provisions is provided in Section 8 of this report;
- b) A consideration of alternatives is given in Section 5;
- c) The necessity of the proposed works is discussed in Section 4; and
- d) Other matters, including other planning and policy documents not listed in s168A(a), that are relevant to for the territorial authority to considered in making a decision on the requirement are addressed in Section 8.3.

These matters provide a comprehensive assessment of the proposal in terms of its necessity and effects on the environment, and in respect of statutory requirements and national, regional and district planning documents.

Having regard to these matters, the territorial authority may, under Section 168A(4), recommend to the requiring authority that it:

- a) Confirm the requirement;
- b) Modify the requirement;
- c) Impose conditions; or
- d) Withdrawal the requirement.

Section 176A

Section 176A(2) states that an OPW need not be submitted to a territorial authority if the details of the proposed public work, project or work, as referred to in subsection (3), are incorporated into the designation. This NOR incorporates the details required under subsection (3), and therefore a separate OPW is not required.

2. Site description

The site to be designated is located at 160 Bangor Road in Selwyn District, and is legally described as Section 1 SO Plan 438579 (Figure 1). The site is owned by SDC. The site is zoned Living 2A deferred under the Selwyn District Plan and is not subject to any overlays. The site is not listed on Environment Canterbury's Listed Land Use Register (LLUR) as being contaminated or potentially contaminated. There are no archaeological sites shown on ArchSite within close proximity to the subject site.



Figure 1. Location of the site to be designated at 160 Bangor Road

There is an existing water facility located in the north-western corner of the site which contains a reservoir, pump station, control building, generator and two water supply bores (Figure 2). The site is currently accessed off West Coast Road. The new designation will cover this existing infrastructure, as well as additional vacant land, which will be used for the construction of a water treatment plant and future expansion works. The extent of the proposed designation is shown in Figure 2. Photos of the site are included in **Appendix B**.

The surrounding environment consists of rural-residential land uses. The nearest dwelling is located approximately 225 m west of the site at 5/1800 Clintons Road and is screened from the site via a mature shelterbelt. There is a drain located approximately 130 m east of the site.

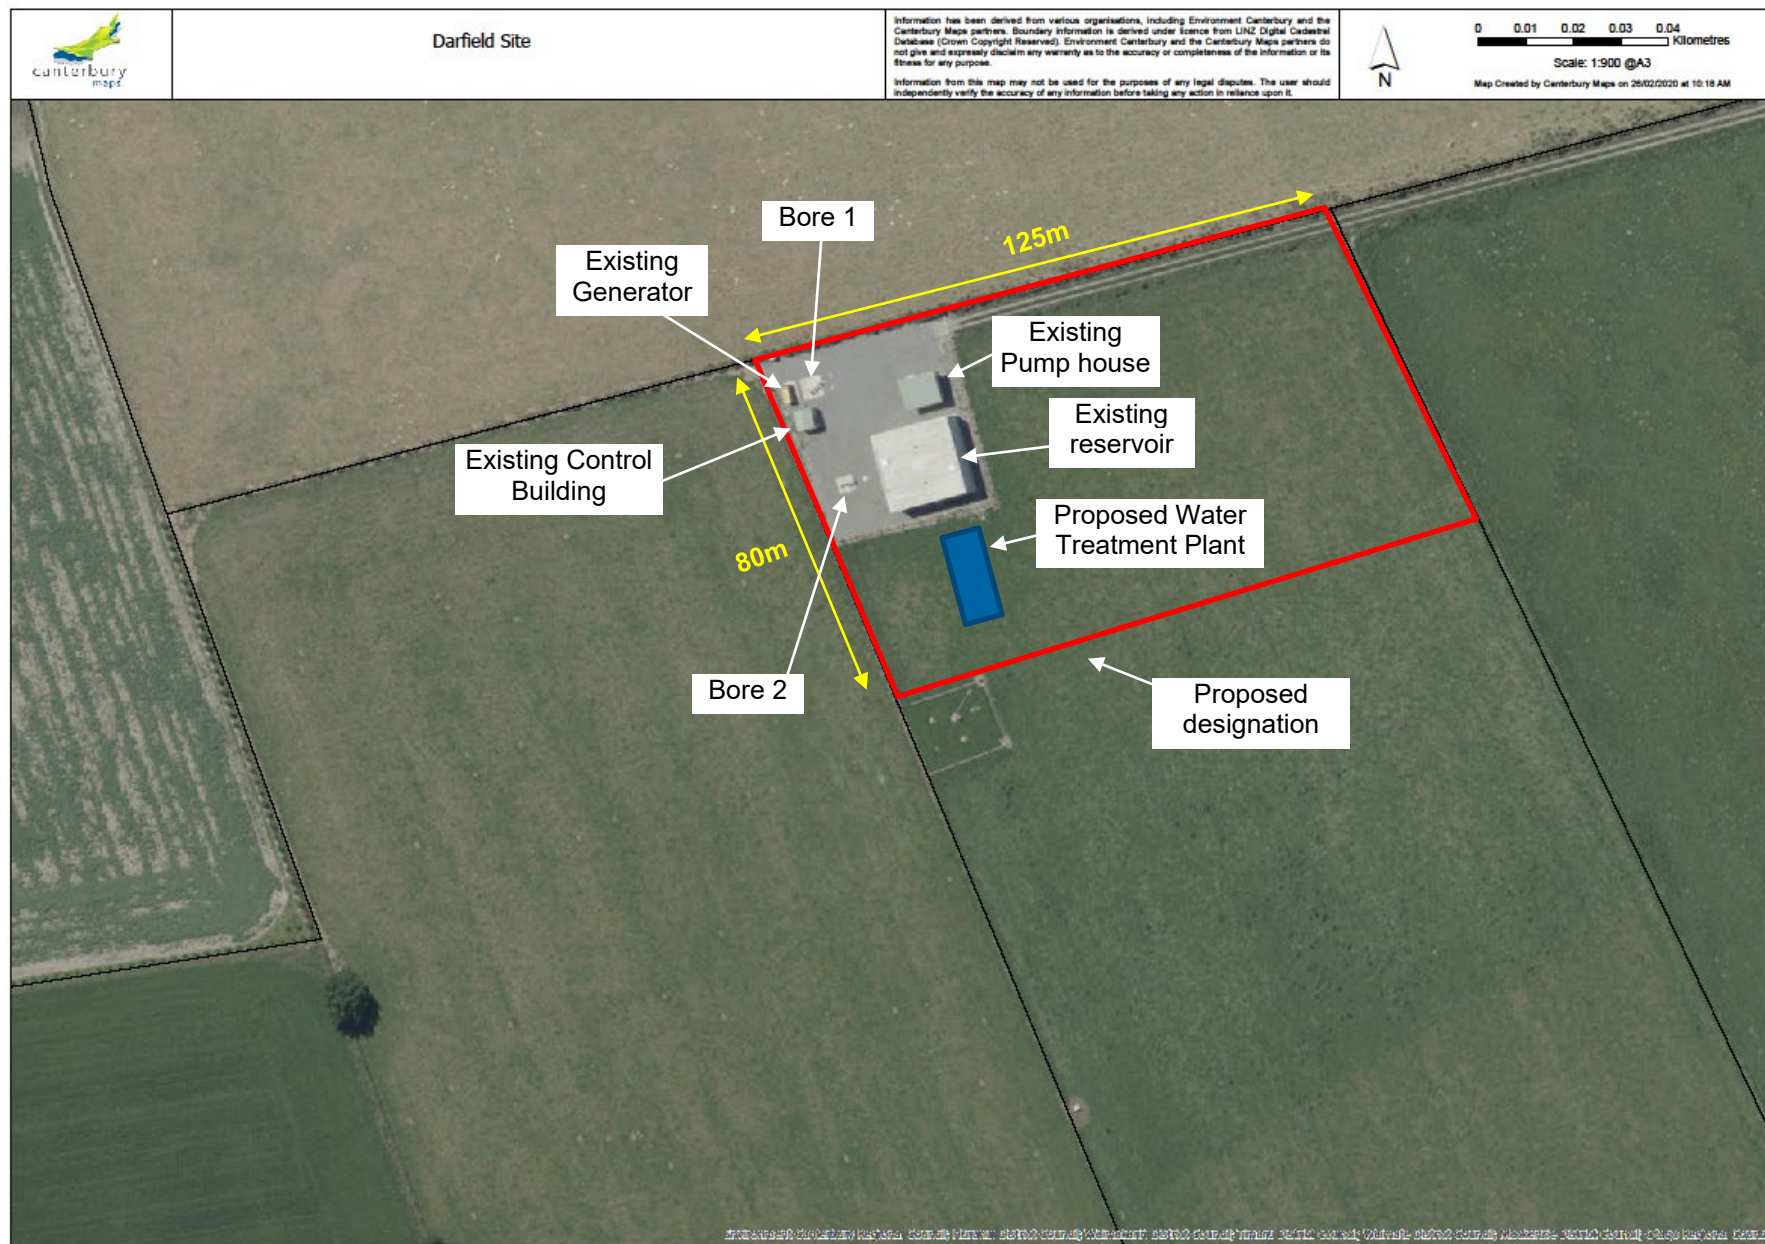


Figure 2. Proposed extent of the designation (shown in red) and existing infrastructure

3. Nature of proposed work

In 2011, a bore was commissioned on the subject site to provide drinking water to the Township of Darfield and surrounding rural areas. In 2014, a second bore, 1,000 m³ reservoir and associated pumping station infrastructure were also commissioned on the site. Following changes to the Drinking-water Standards for New Zealand (DWSNZ), SDC passed a resolution to treat all drinking water supplies with UV treatment. The proposed treatment plant will sit directly adjacent to the reservoir, with connecting pipework to the two bores.

This NOR seeks to enable the construction of a new water treatment plant, and the ongoing operation and maintenance of all infrastructure on the site. Further details on the proposal are provided below.

3.1 Height, shape, bulk and location of the works

The location of each piece of infrastructure on the site is shown in Figure 2. The as-built plans for the existing infrastructure and proposed plans for the new water treatment plant are included in **Appendix C**. The height and bulk of this infrastructure is as follows:

- *Reservoir*: There is an existing aboveground covered reservoir located on site. The reservoir has a capacity of 1 ML, an area of 16.5 m x 16.5 m, and is 5 m in height.
- *Pump house*: The pump house contains the reticulation pumps and associated equipment. The pump house has an area of approximately 5 m x 6.25 m and is 4.45 m in height.
- *Control building*: The control building has an area of approximately 3.5 m x 4 m and is approximately 2.5 m in height.
- *Generator*: The generator is located next to the control building and is present on site for emergencies only. The generator has an area of approximately 3.8 m x 1.4 m, and is approximately 1.5 m in height.
- *Bores*: There are two aboveground bore wellheads located on site, one directly to the east of the generator, and one to the west of the reservoir.
- *Water treatment plant*: The location of the proposed water treatment plant on site is shown in Figure 2. The proposed building will have a minimum internal height of 2.4 m and an area of approximately 15 m x 6 m.

3.2 Vehicular access, circulation and parking

The site is currently accessed via an 835 m long gravel driveway off West Coast Road. There is a locked gate located at the end of the driveway at the entry to the site. There is sufficient room at the front of the site to allow for parking and safe manoeuvring on site. No changes are proposed to the existing access, parking or onsite circulation as part of the construction of the new water treatment facility.

3.3 Landscaping

Planting will be provided around the boundary of the designated site as shown in the planting plan attached as **Appendix D**. Two stages of planting are proposed; the first is planting around the existing infrastructure and proposed water treatments plant, which will later be extended around the whole designated site in a second stage of planting if more development occurs on site.

Careful consideration has been given to the species selected to ensure that they are suitable for this specific location.

3.4 Finished contour

The site has a generally flat contour and is relatively level. No changes are proposed to existing ground levels as part of the construction of the water treatment plant.

3.5 Physical works

As the majority of the infrastructure is already present on site, the only physical works required are those to construct the new water treatment plant.

3.5.1 Earthworks

Minor earthworks will be required to construct the water treatment plant, namely for the building foundations, buried pipe and cable services and a soak pit. Approximately 280m³ of earthworks will be required to a maximum depth of 1.5m.

The site is located over an unconfined or semiconfined aquifer, and within two Community Drinking Water Protection Zones (Figure 3).

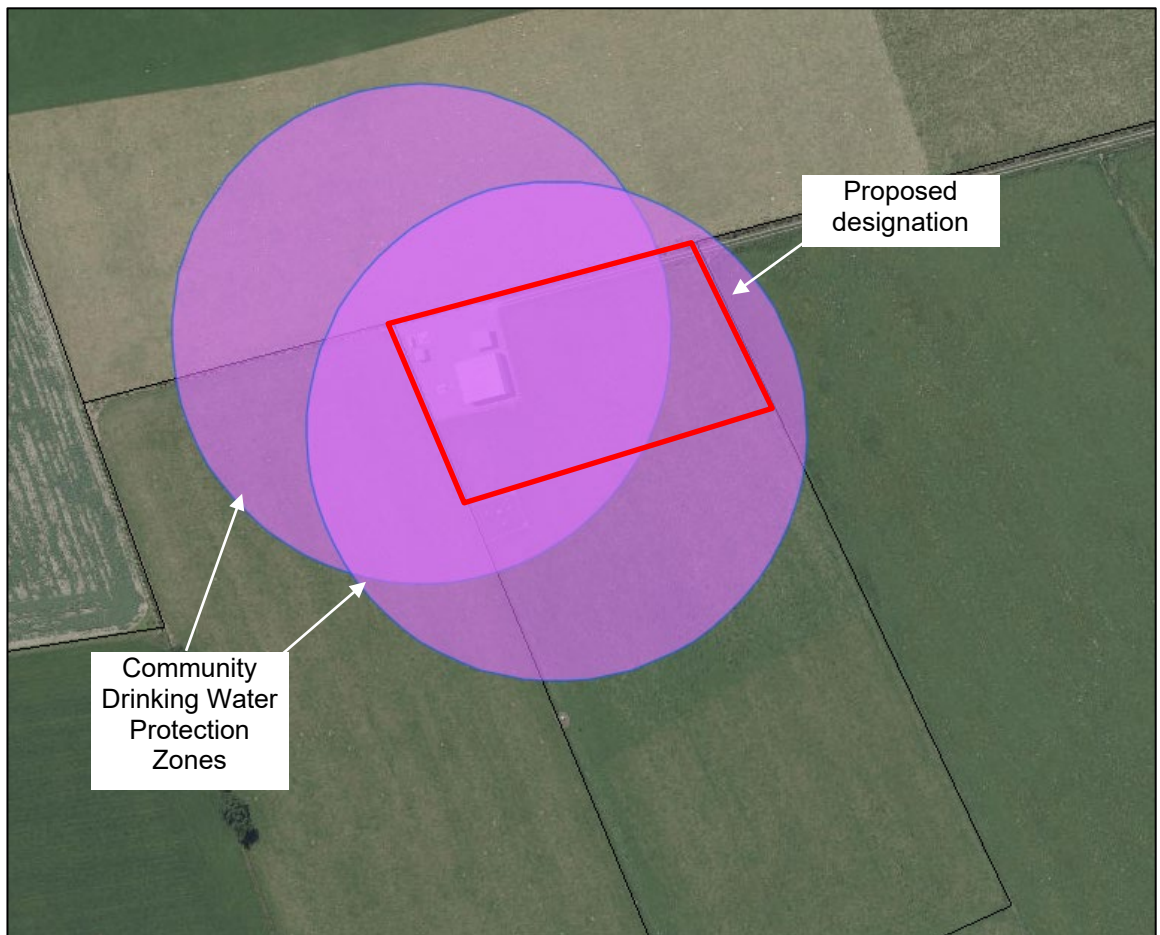


Figure 3. Community Drinking Water Protection Zone Overlays (Source: Canterbury Maps)

The necessary resource consents will be obtained from Environment Canterbury for the earthworks required over an unconfined or semiconfined aquifer, and within a Community Drinking Water Protection Zone. Full details on the construction works will be provided in the resource consent application to Environment Canterbury.

3.5.2 Construction programme

Construction of the new water treatment plant is expected to commence as soon as the NOR is approved and will take approximately 3-4 months to complete.

4. Necessity of works and designation

Section 168A(3)(c) states that the territorial authority must have regard to whether the work and designation are reasonable necessary for achieving the objectives of the requiring authority for which the designation is sought.

As outlined in Section 3 of this report, the proposed water treatment plant and other existing infrastructure is required to provide drinking water to the Township of Darfield and surrounding rural areas. Following changes to the Drinking-water Standards for New Zealand (DWSNZ), SDC passed a resolution to treat all drinking water supplies with UV treatment, and therefore the new water treatment plant is required to action this resolution, and provide safe drinking water.

As such, SDC seeks to designate land under this NOR to enable the construction of a new water treatment plant, and the ongoing operation and maintenance of all infrastructure on the site.

5. Consideration of alternatives

Section 168A(3)(b) of the RMA states that the territorial authority must have regard to whether adequate consideration has been given to alternative sites, routes, or methods of undertaking the work if:

- i. the requiring authority does not have an interest in the land sufficient for undertaking the work; or
- ii. if it is likely that the work will have significant adverse effect on the environment.

As provided by the assessment of effects (Section 6 of this report), the proposal will not have any significant adverse effects on the environment. In addition, SDC, as requiring authority, has full interest in all of the land required for undertaking the work.

Due to the location of the existing infrastructure on this site, the construction of the new water treatment plant on the same site is the most cost efficient option, and consideration of alternative sites was not deemed necessary.

6. Assessment of environmental effects

This section provides an assessment of the actual and potential effects of the proposed works on the environment, and identifies the ways in which these effects can be avoided, remedied or mitigated.

6.1 Positive effects

The designation will provide long-term certainty for SDC and the community in the protection of a drinking water supply to the Darfield Township. The treatment facility will enable the water supply to meet the water quality standards required under the DWSNZ, allowing the community to provide for their social, economic and cultural wellbeing, and health and safety.

6.2 Construction effects

6.2.1 Dust

The Contractor will be required to have in place suitable dust controls during construction, so that there is no discharge of dust beyond the site. Controls may include wetting down exposed soils, covering stockpiled soils, removing excavated soil from the site if it is not to be reused, and staging earthworks so that the area of soil exposed is minimised. Using controls during excavation will manage dust from excavations, so that the effects from dust on the surrounding environment are less than minor.

6.2.2 Sedimentation

The Contractor will be required to have in place erosion and sediment controls throughout construction. An Erosion and Sediment Control Plan (ESCP) will be produced in accordance with Environment Canterbury's Erosion and Sediment Control Toolbox. As the site is flat, the site (or adjacent sites) will not be susceptible to erosion, and suitable controls will be implemented so that no sediment-laden water is discharged beyond the boundary of the site, and the effects on the surrounding environment are less than minor.

6.2.3 Construction traffic

Traffic associated with the construction of the water treatment plant will be temporary in duration. All construction traffic will access the site using the existing access of West Coast Road (SH73). Construction of the water treatment plant is scheduled to take approximately 3-4 months to complete and construction traffic will be limited to the hours of 7am and 6pm Monday-Saturday. It is expected that there will be approximately 10-20 vehicle movements to and from the site per day. Due to the location of the site off a State Highway, which has an existing high traffic volume, and temporary duration, the effects of the additional traffic movements to and from the site during the construction works will be less than minor.

6.2.4 Construction noise

All construction noise will comply with the relevant standards set out in NZS 6803:1999.

6.3 Operational effects

6.3.1 Visual amenity

The site is located within a rural residential environment and well setback from all adjoining public roads. The nearest dwelling is located approximately 225 m west of the site at 5/1800 Clintons Road and is screened from the site via a mature shelterbelt.

There is existing infrastructure already on site in the form of a reservoir, pump house, control building, generator and two bores; therefore, the construction of the additional water treatment plant building will not add significantly to the overall bulk of built form on site.

Landscaping is proposed along the boundaries of the site, which will further screen the buildings from surrounding properties and West Coast Road.

Overall, given the rural location of the site and proximity to surrounding dwelling and roads, and the landscaping proposed, it is considered that the effects of the proposal on visual amenity will be less than minor.

6.3.2 Noise

The main sources of operational noise at the site are the existing 250 kVA generator and pumping equipment. The generator is used as a backup during emergencies and therefore its use is infrequent and only for short durations. All of the existing pumping equipment is located inside a pump house building.

The nearest dwelling is located approximately 225 m west of the site at 5/1800 Clintons Road and is screened from the site via a mature shelterbelt. Additionally, the site is setback approximately 835 m from West Coast Road.

Therefore, due to the location of the site away from dwellings and road it is considered any noise effects will be less than minor.

6.3.3 Effects on the surrounding traffic network

Access to the site is provided via a single vehicle entry/exit point from West Coast Road. There is currently sufficient space for construction and maintenance vehicles to manoeuvre on site, and exit the site forward facing onto West Coast Road. Once construction of the water treatment plant is complete and the site is operational, there will be no changes to the existing volume of vehicle movements to and from the site each week for routine maintenance inspections. As a result, the effects on the existing transport network from the ongoing operation of the pump station will be negligible.

6.4 Summary of effects

In summary, the designation will provide long-term certainty for SDC and the community in the protection of a drinking water supply to the Darfield Township. This will allow the community to provide for their social, economic and cultural wellbeing, and health and safety, by providing a secure drinking water supply.

Construction effects will be managed through the implementation of an ESCP and through compliance with the relevant construction noise standards. The rural location and proposed landscaping will help mitigate the visual effects of the proposal, whilst also noting that the majority of the overall bulk of built form is already existing on site. Due to the location of the site away from residential dwellings and public roads, the effects of noise created from the facility can be adequately managed to an extent that they will be less than minor. The additional water treatment plant will not result in any changes to the existing volume of vehicle movements to and from the site each week for routine maintenance inspections. Overall, the effects of the proposal are considered to be less than minor.

7. Relevant plan provisions

Section 168A(3)(a) state that the territorial authority must have regard to the relevant provisions of any national or coastal policy statement, regional policy statement or plan, and district plan.

Section 168A(3)(d) states that the territorial authority must have regard to any other matters reasonably necessary in order to make a decision; this includes other planning documents not considered in subsection (a).

This section of the report provides an assessment of the proposed work against the relevant planning documents.

7.1 Canterbury Regional Policy Statement

This NOR is consistent with the purpose of the Canterbury Regional Policy Statement (RPS). In particular, the NOR is consistent with the following objectives and policies:

- e) Objective 5.2.1: Location, design and function of development (Entire Region);
- f) Objective 5.2.2: Integration of land-use and regionally significant infrastructure;
- g) Policy 5.3.2: Development conditions (Wider Region);
- h) Policy 5.3.5: Servicing development for potable water, and sewage and stormwater disposal (Wider Region);
- i) Policy 5.3.6: Sewerage, stormwater and potable water infrastructure (Wide Region); and
- j) Policy 5.3.9: Regionally significant infrastructure (Wider Region).

The objectives and policies from the RPS are set out in full in **Appendix E** of this NOR. Of most relevance to this NOR to designate the water treatment facility is Objective 5.2.2 and Policies 5.2.2 and 5.3.6.

Objective 5.2.2 and Policy 5.3.2 recognise the importance of providing for infrastructure that is regionally significant, and the importance of avoiding, remedying or mitigating adverse effects from the development and operation of regionally significant infrastructure. As discussed in Section 6, the adverse effects from the water treatment facility will be managed to provide for the social, economic and cultural well-being and health and safety of people and communities. Regionally significant infrastructure includes “community potable water systems”.

Policy 5.3.6 seeks to enable the development of infrastructure required to manage sewerage, stormwater and potable water, provided that any adverse effects are avoided, mitigated or appropriately controlled. Section 6 has illustrated that the effects of the proposal will be less than minor, noting that the majority of the required infrastructure is already on site, and therefore minimal construction work is required.

7.2 Selwyn District Plan

The NOR is consistent with the objectives and policies of the Selwyn District Plan (the District Plan), in particular, those which are related to the provision of utilities, including water supply. Table 1 provides an assessment against the relevant objectives and policies of the District Plan.

Table 1. Assessment against the relevant objectives and policies of the Selwyn District Plan

Objective	Policy	Assessment against the Notice of Requirement
<p>Objective B2.2.1</p> <p>Utilities are recognised as essential tools for people’s economic and social well-being, and to mitigate effects of other activities, on the environment.</p>	<p>Policy B2.2.2</p> <p>Ensure provision is made for the ongoing maintenance and repair of utilities which are not vested in the Council, and that the users of these utilities are informed of any responsibility they have for ongoing maintenance or repair.</p>	<p>The proposal will allow the community to provide for their social, economic and cultural wellbeing, and health and safety, by providing a secure drinking water supply.</p> <p>As outlined in Section 3, the majority of the required infrastructure already exists on site, and therefore the new water treatment facility will not contribute significantly to the overall bulk of built form on the site. Additionally, due to the location of the existing infrastructure on the site, the construction of the new water treatment plant on the same site is the most cost efficient and appropriate option to meet operational requirements.</p> <p>As outlined in Section 6 the effects of the proposal will be less than minor. SDC will continue to be responsible for the ongoing maintenance and repair of the infrastructure.</p>
<p>Objective B2.2.2</p> <p>The provision of utilities where any adverse effects on the environment and on people’s health, safety and wellbeing is managed having regard to the scale, appearance, location and operational requirements of utilities.</p>		

8. Part 2 RMA – Purpose and Principles

Part 2 of the RMA sets out the purpose and principles of the Act. The purpose of the Act in accordance with Section 5, is to promote the sustainable management of natural and physical resources. The designation will provide long-term certainty for SDC and the community in the protection of a drinking water supply to the Darfield Township. The treatment facility will enable the water supply to meet the water quality standards required under the DWSNZ, allowing the community to provide for their social, economic and cultural wellbeing, and health and safety, whilst providing a safe and reliable drinking water supply. Adverse effects on the environment will be avoided, remedied or mitigated to an extent that they will be less than minor.

Section 6 of the RMA sets out matters of national importance to be recognised and provided for. There are no Section 6 matter relevant to this proposal.

Other matters to have particular regard to are set out in Section 7 of the Act. Of relevance to this proposal is 7(b) *‘the efficient use and development of natural and physical resources’*. The proposal is considered an efficient use of a physical resource as it builds on the existing infrastructure that already exists on site. The designation will provide long-term security for this infrastructure, allowing the community to provide for their social, economic and cultural wellbeing.

Section 8 of the RMA requires all persons exercising functions and powers under the RMA to taken into account the principles of the Treaty of Waitangi. It is considered that the proposal will have no known resource management issues of relevance to tangata whenua. The proposal is not affected by any objectives of Maori in RMA plans; the proposal does not affect s.6(e) matters; the effects of the proposal are less than minor; there are no issues regarding the exercise of kaitiakitanga; and there are no effects on matters of cultural, spiritual or historical importance.

Overall, the proposal is considered to be consistent with the purpose and principles of the RMA.

9. Conclusion

SDC is seeking to designate land required for the construction of a new water treatment plant, and the ongoing operation and maintenance of all infrastructure on the site at 160 Bangor Road in the Selwyn District, through a NOR under Section 168A of the RMA.

Section 168A(3) of the RMA prescribes what a territorial authority must consider when looking at a NOR.

The Assessment of Effects in Section 6 above has considered the potential for adverse effects on the environment including:

- Construction effects;
- Visual amenity;
- Noise; and
- Effects on the transport network.

It is considered that the proposal is consistent with Part 2 of the RMA.

There are four other particular matters that a territorial authority must have regard to when considering the effects on the environment of allowing the requirement.

SDC own the land for which the designation is sought and consideration has been given to alternative sites.

Designation is the most appropriate planning method available to SDC because the designation becomes embodied in the District Plan, thereby providing long-term certainty for SDC and the community.

It is considered that the works and designation are necessary for achieving the objectives of the Requiring Authority.

This NOR meets the requirements of the RMA and all relevant planning documents. Any environmental effects arising from the public works undertaken in accordance with the NOR will be suitably managed.

It is therefore appropriate that the Requirement be confirmed. Additionally, sufficient information has been provided to satisfy the requirements for an OPW under section 176A of the Act and as such, an OPW approval can be granted concurrently.

Appendices

Appendix A – Certificate of title

Terranet document ordering service

Certificate of Title with diagram: 548759

Billing Code: 12522757 - SDC NORS

CoreLogic Reference: 2870440/1

Processed: 24 August 2020

Sourced from Terranet, a CoreLogic solution. For any queries about this document or this service please call 0800 355 355 or email documentordering@corelogic.co.nz.



**RECORD OF TITLE
UNDER LAND TRANSFER ACT 2017
FREEHOLD
Search Copy**




R.W. Muir
Registrar-General
of Land


Identifier **548759**
Land Registration District **Canterbury**
Date Issued 07 June 2011


Prior References
CB47A/154

Estate	Fee Simple
Area	4.0010 hectares more or less
Legal Description	Section 1 Survey Office Plan 438579
Purpose	Water supply
Registered Owners	Selwyn District Council

Interests

Subject to a right (in gross) to convey electricity over part marked C on SO 438579 in favour of Orion New Zealand Limited created by Easement Instrument 8781543.7 - 7.6.2011 at 2:37 pm

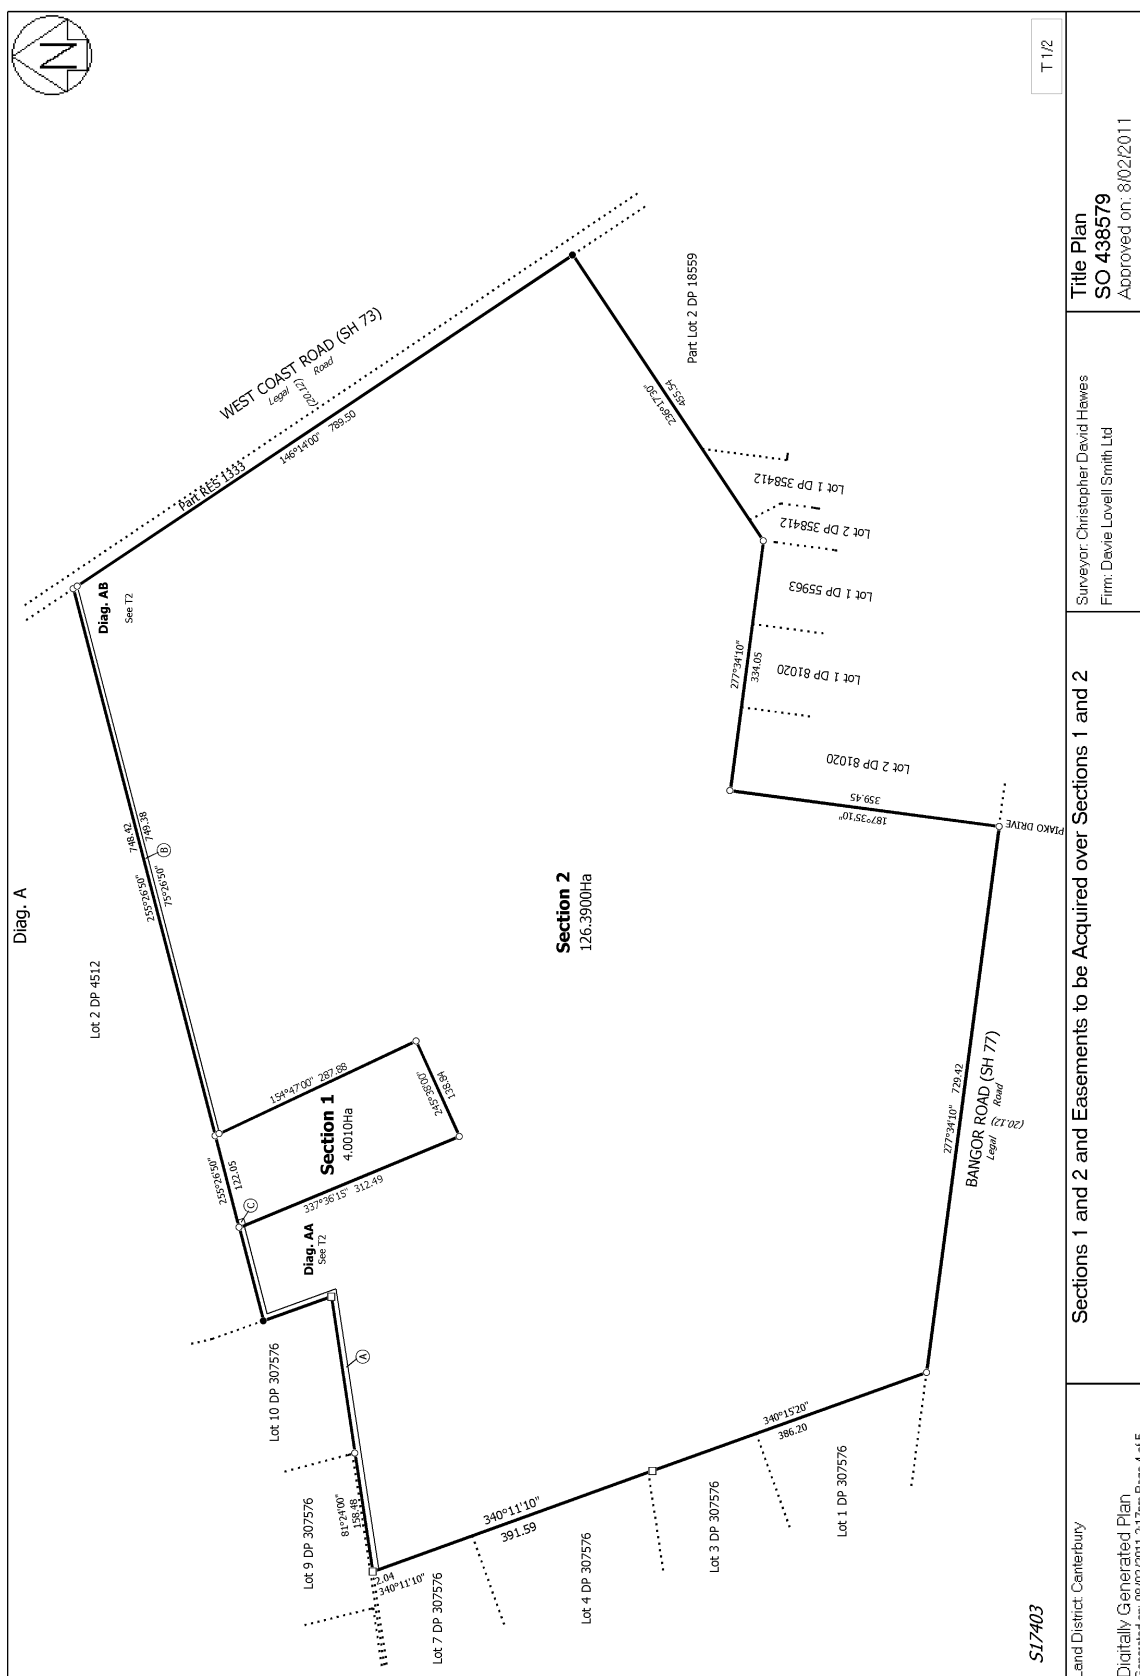

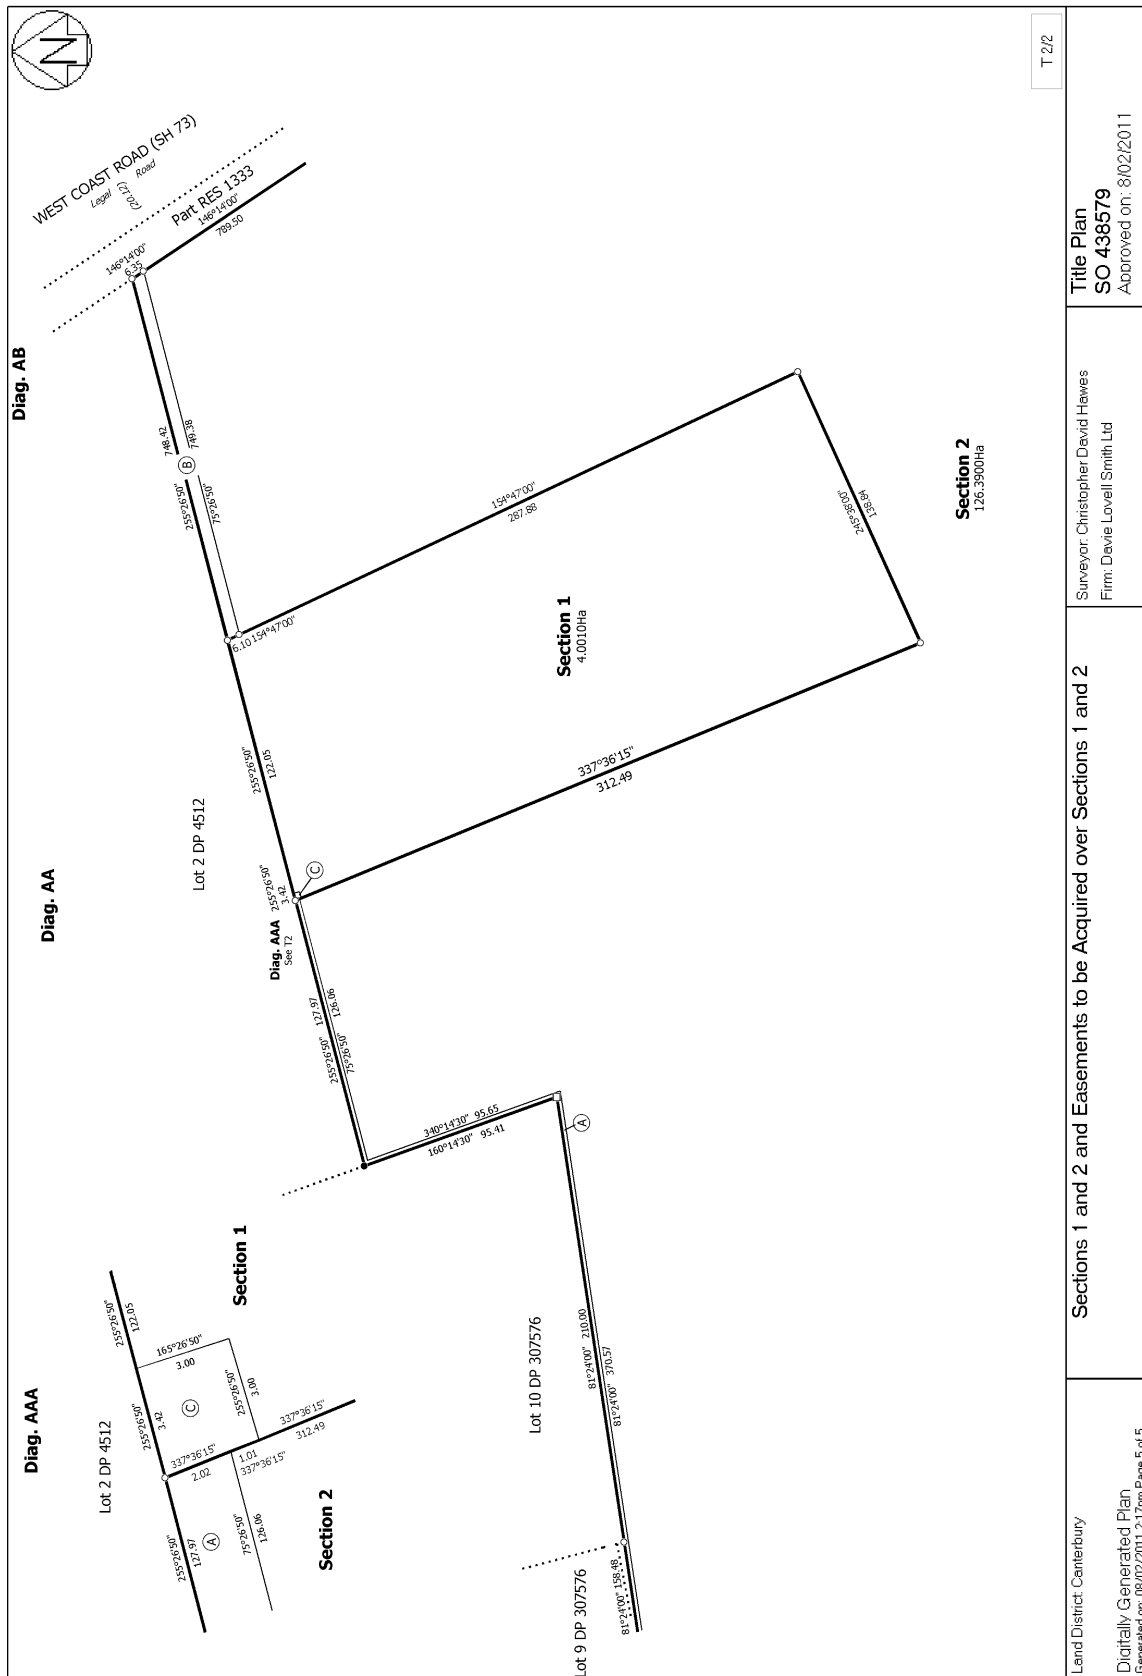

Appendix B – Site photos




Looking west from the site entrance – pump house in the foreground and generator in the background. Behind the site, the existing shelterbelt which runs along the property boundary of 5/1800 Clintons Road.



Looking south west from the site entrance – existing reservoir and pump house.

Appendix C – As built plans of existing infrastructure

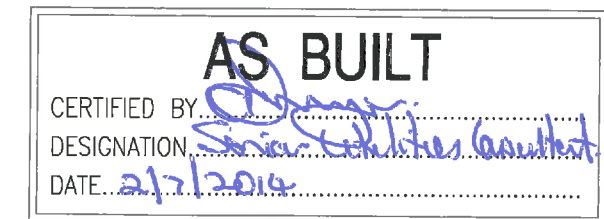


AS BUILT DARFIELD WATER SUPPLY UPGRADE CONTRACT 1133

AS BUILTS

Drawing No: 6/1515/19
Project No: 3C1004.51

Date: JUNE 2014

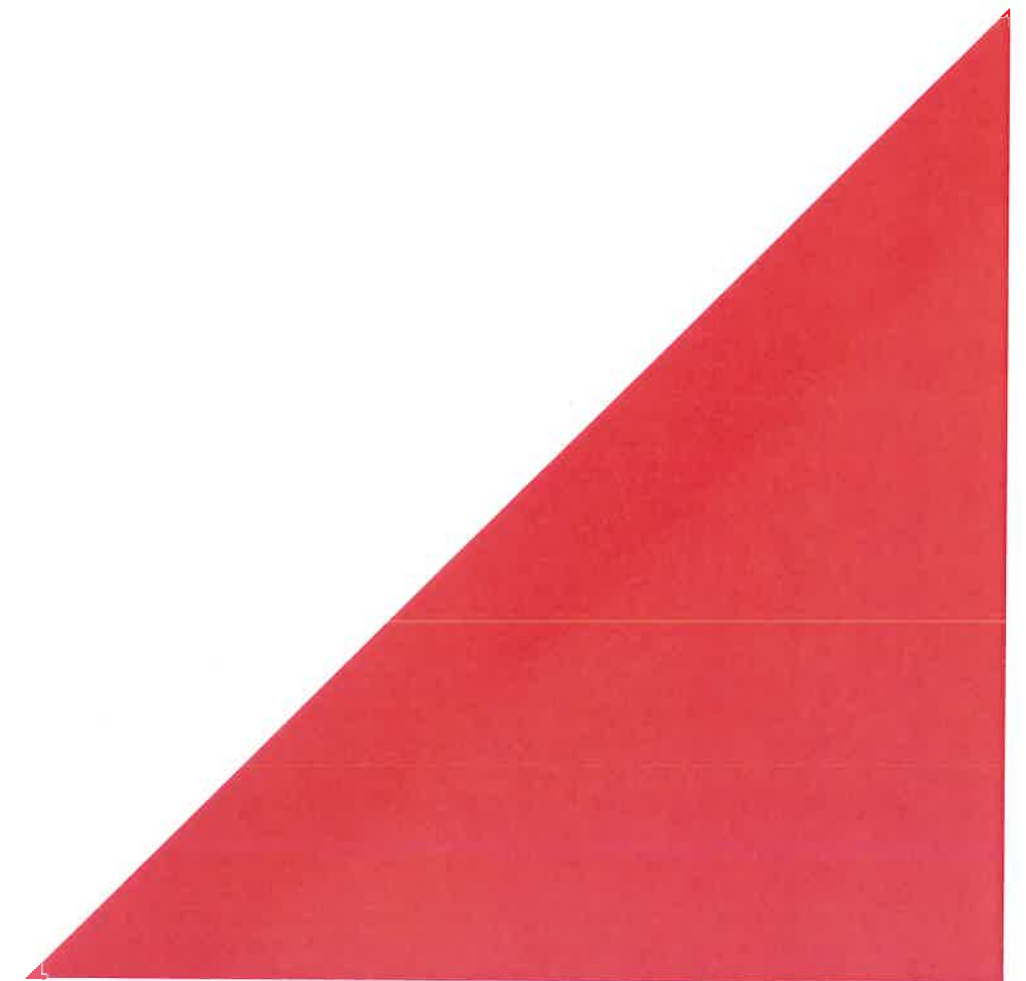



CERTIFIED BY: [Signature]
DESIGNATION: Senior Policy Consultant
DATE: 2/7/2014


[illegible]

AS BUILT

SET OUT POINTS	
POINT	mmE, mmN
1	1525986712, 5185882421
2	1525984480, 5185879459
3	1525989358, 5185872497
4	1525977214, 5185871135
5 (APPROX.)	1525946594, 5185897705
6	1525972779, 5185897805
7	1525988911, 5185896787
8	1525989063, 5185898205
9	1525982777, 5185894552
10	1525981492, 5185899435
11	1525987778, 5185701090
12	1525987294, 5185700963
13 (APPROX.)	1525984343, 5185712152
14	1525976108, 5185895157
15	1525945477, 5185865125
16	1525979818, 5185874163
17	1525989101, 5185714876
A	1525950939, 5185888121
B	1525971412, 5185892194
C	1525976485, 5185876721
D	1525980012, 5185872648

NOTES:

1. CO-ORDINATE SYSTEM = NZTM
2. LEVEL DATUM = LYTTTELTON MSL 1937 (POST-QUAKE)
3. RESERVOIR SETOUTS A-D ARE INSIDE CORNERS OF WALLS FOR 16x16m INTERNAL DIMENSION

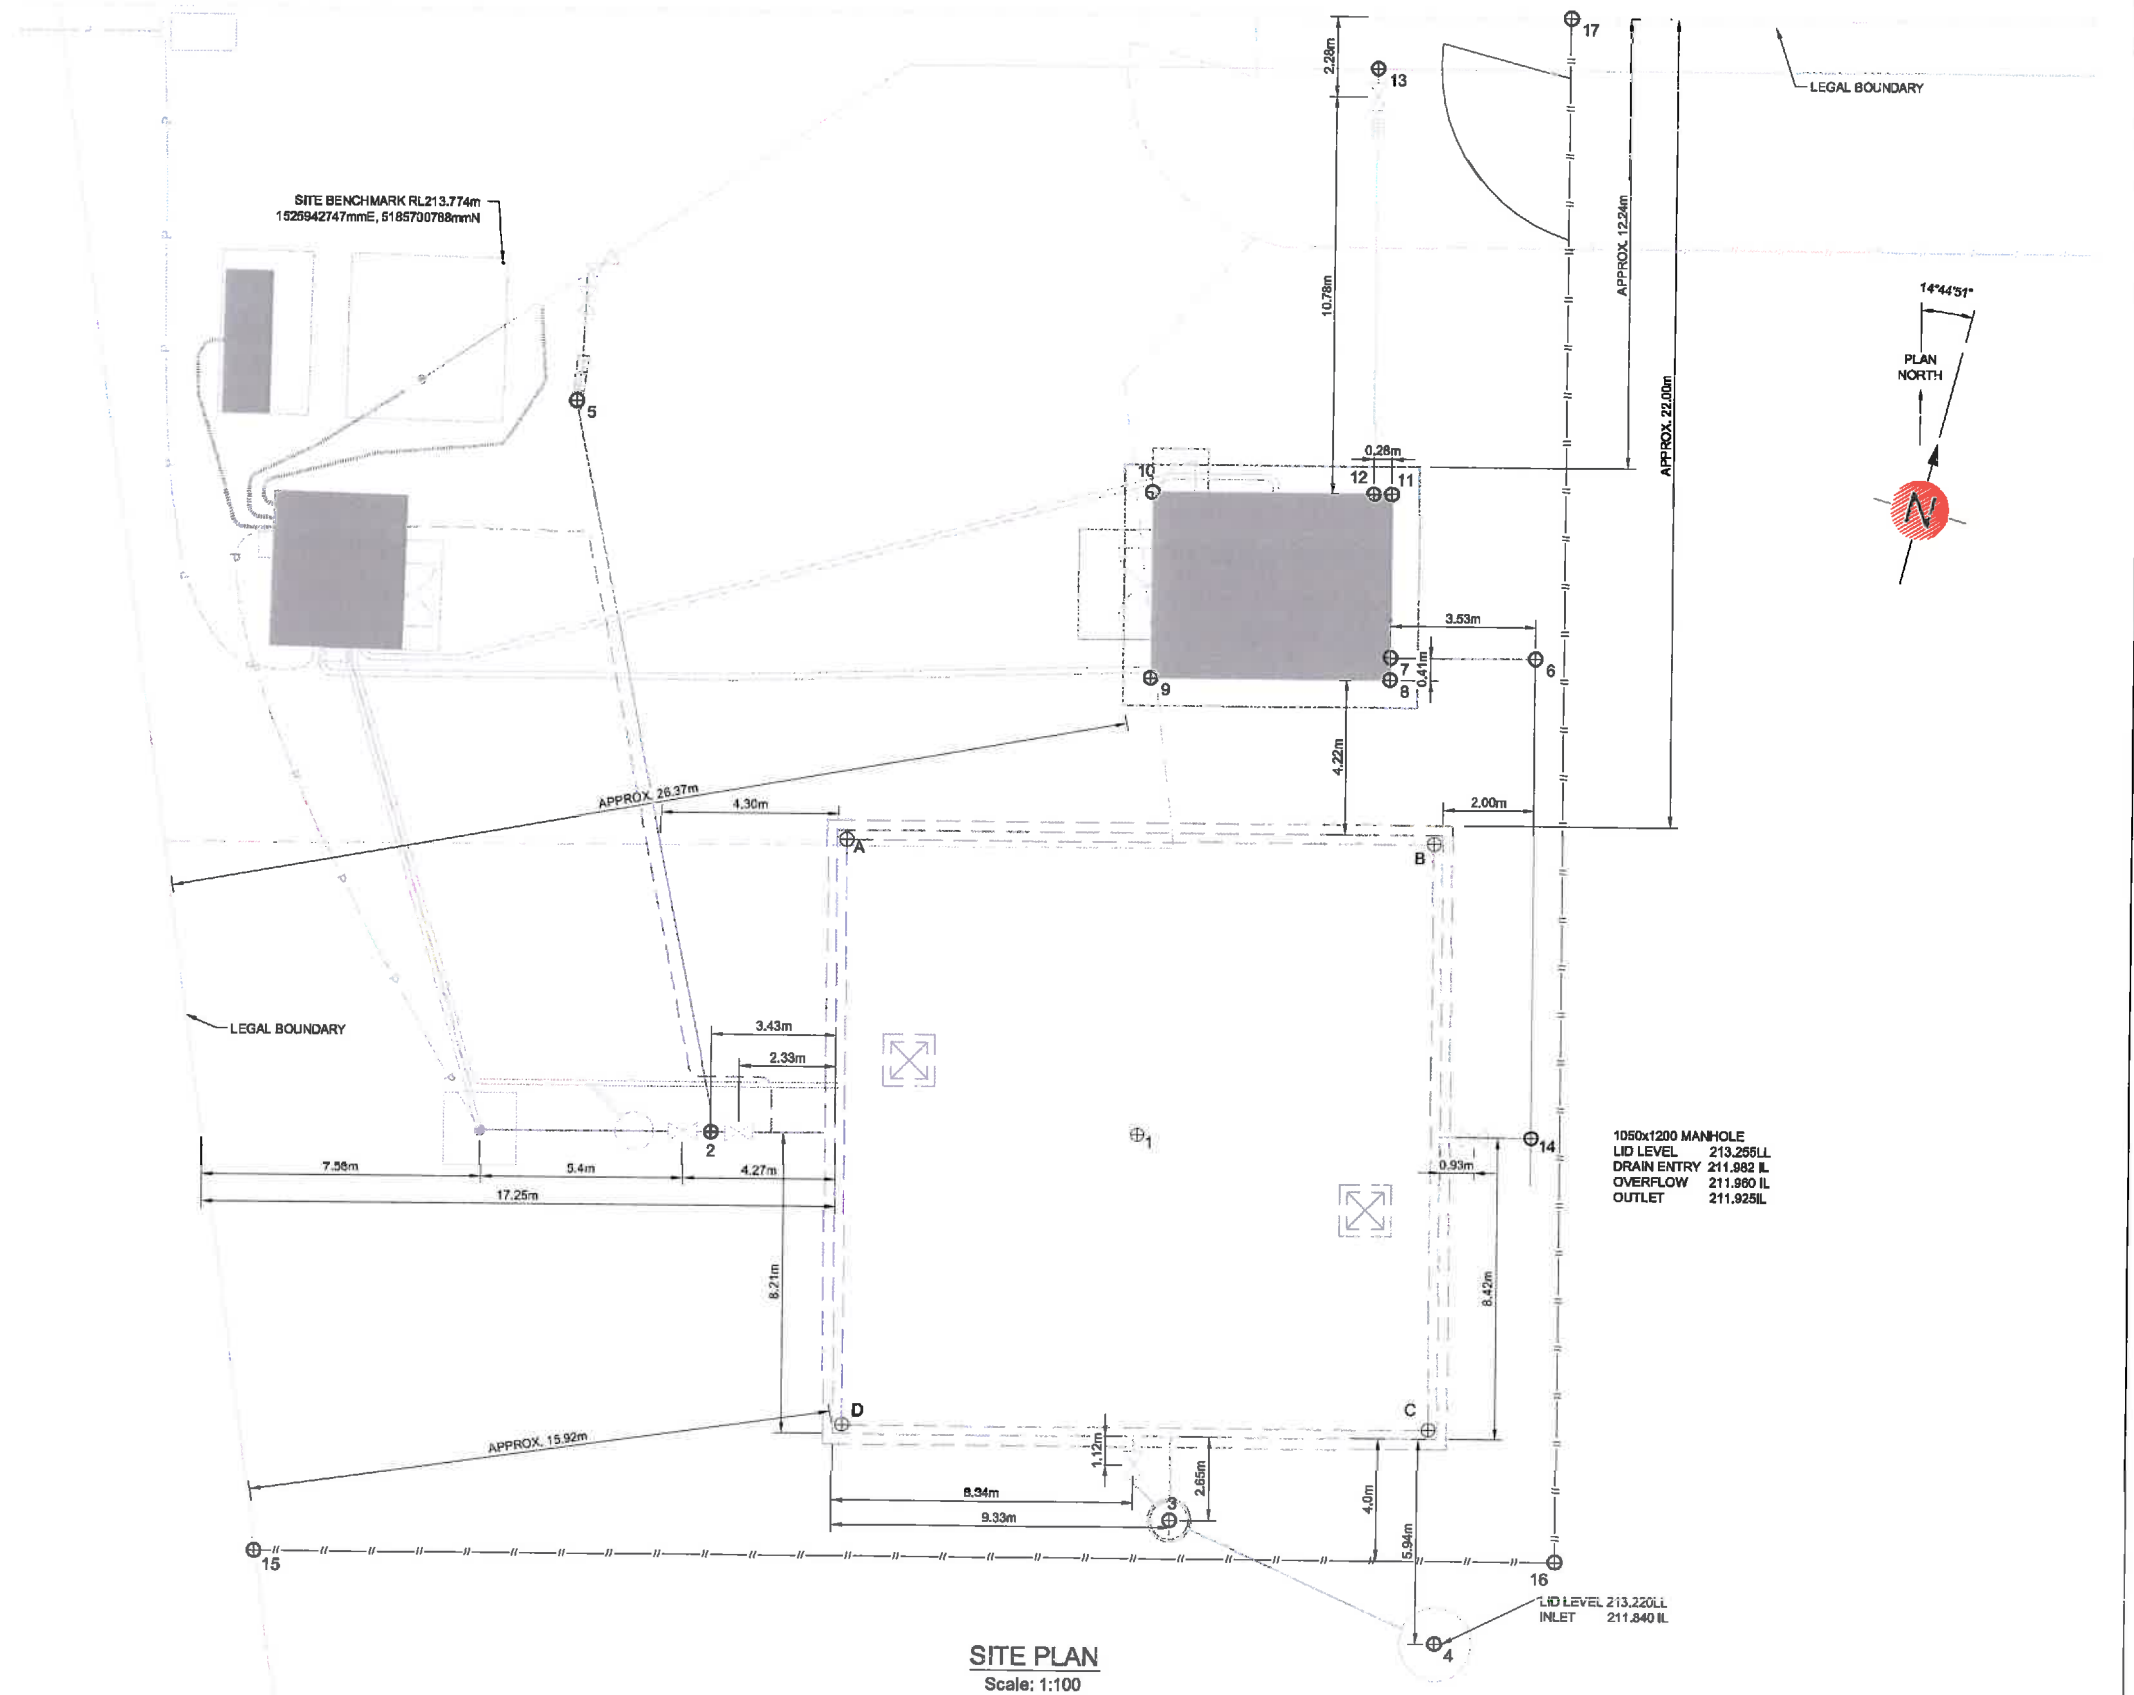

AS BUILT

CERTIFIED BY: *[Signature]*
DESIGNATION: *[Signature]*
DATE: 2/7/2014

Revision	Approved	Approved	Revision Date
RAB	CERTIFIED AS RAB	GB	05/14



Christchurch Environmental
PO Box 1482
Christchurch 8140
New Zealand

Drawn: GB
Designed: GB
Approved: GB
Revision Date: MAY 2014



Project No: 3C1004.51
Scale: AS SHOWN (A1)

SELWYN DISTRICT COUNCIL
DARFIELD WATER SUPPLY UPGRADE
CONTRACT 1133





SITE
SETTING OUT INFORMATION

Sheet No.	Revision
2	RAB


300 mm
200
100
0 10 mm

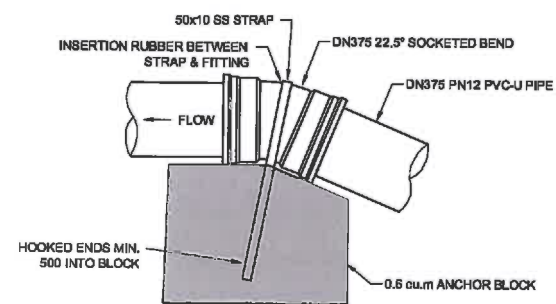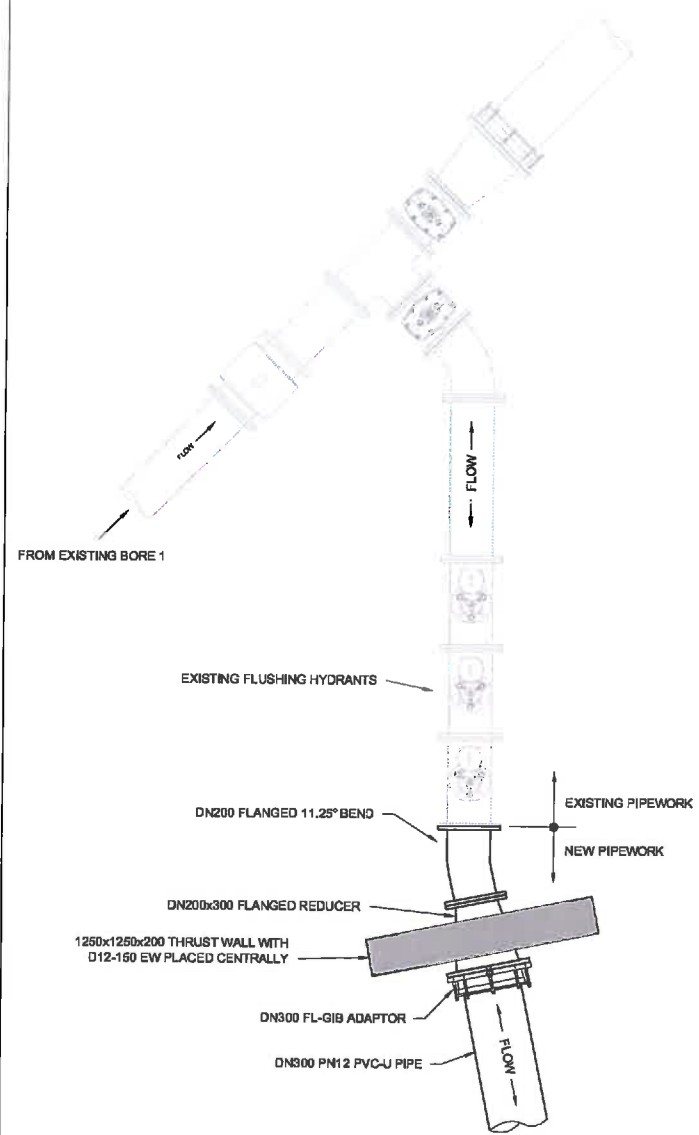

VIEW A
Scale: 1:20

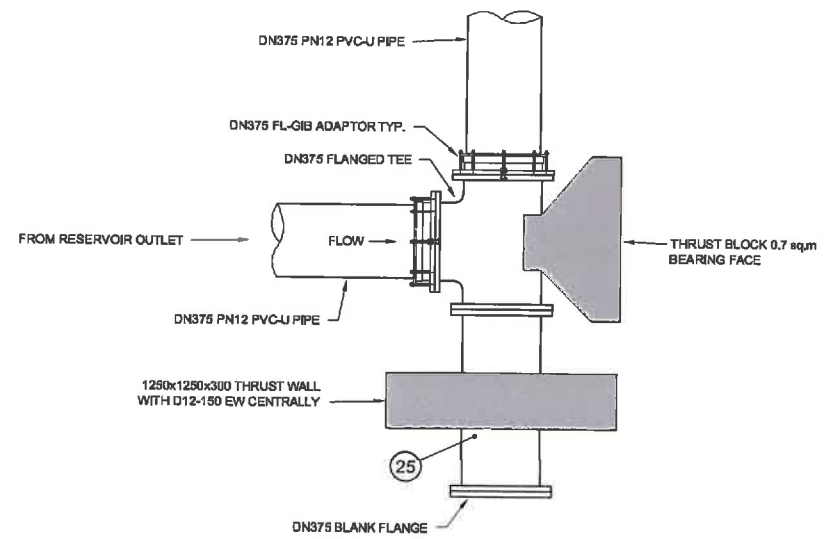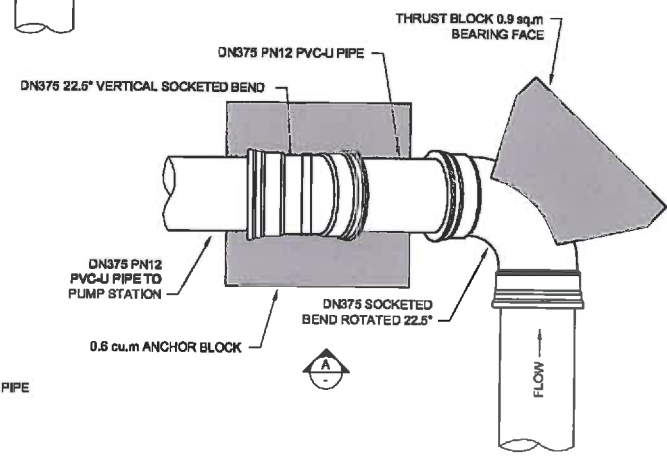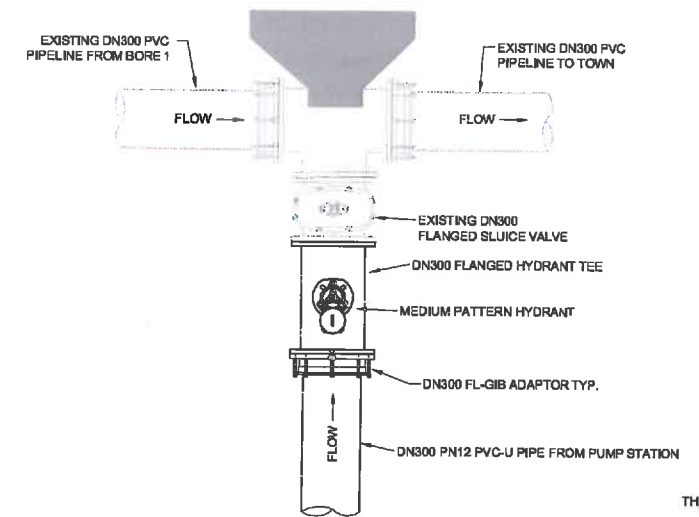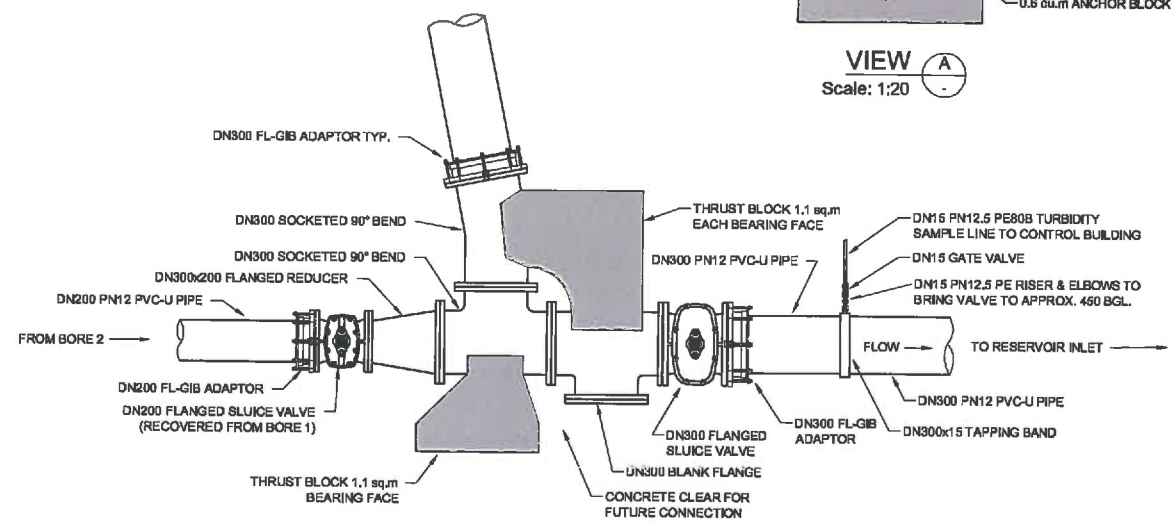

NOTE: NUMBERED ITEMS
REFER TO PIPE SPECIALS

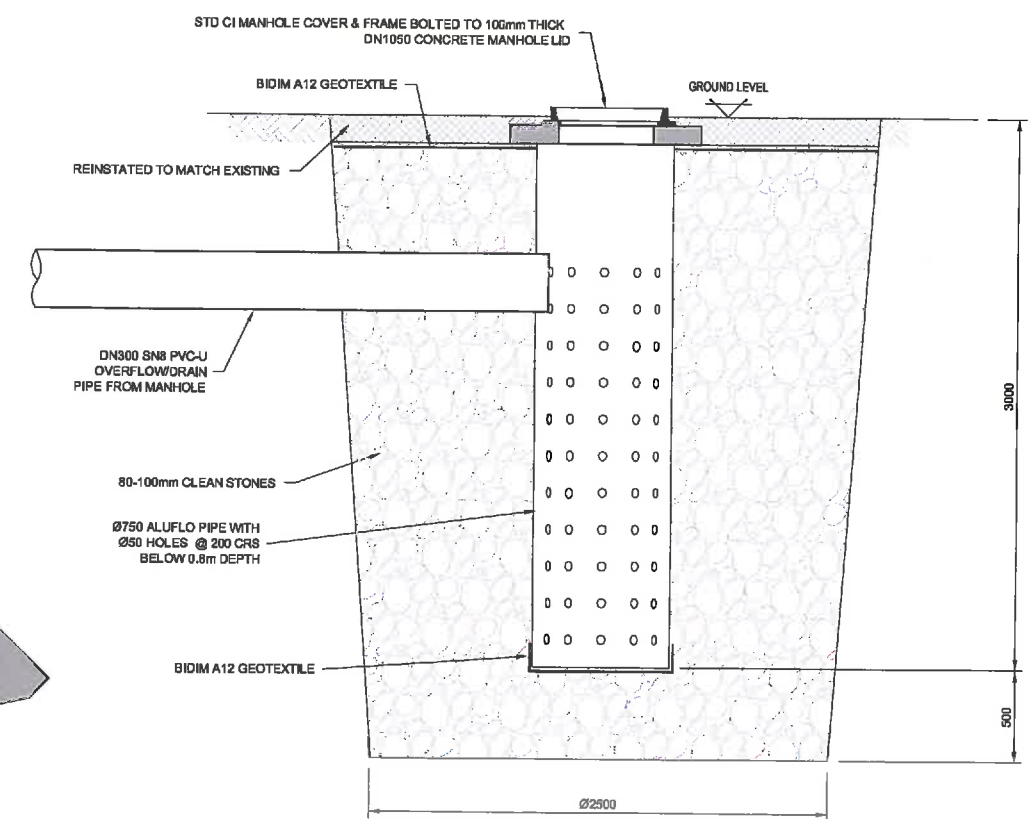

SOAKHOLE ELEVATION
Scale: 1:20

AS BUILT
CERTIFIED BY *[Signature]*
DESIGNATION *Senior Utilities Engineer*
DATE *21/7/2014*

Revision	Amendment	Approved	Revision Date
RAB	CERTIFIED AS RAB		09/14




OPUS
Christchurch Environmental
+64 3 383 5400

PO Box 1482
Christchurch 8140
New Zealand


Drawn	Checked	Approved	Revision Date
GB	GB		MAY 2014

Project No: 3C1004.51
Scale: 1:20 (A1)


Project	SELWYN DISTRICT COUNCIL DARFIELD WATER SUPPLY UPGRADE CONTRACT 1133
Sheet	SITE PIPELINES CONNECTION DETAILS
Drawing No.	6/1515/197605
Sheet No.	10
Revision	RAB

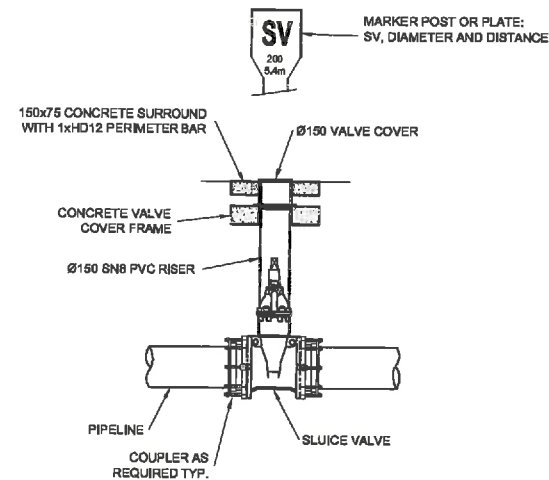


TYPICAL SLUICE VALVE INSTALLATION
NTS

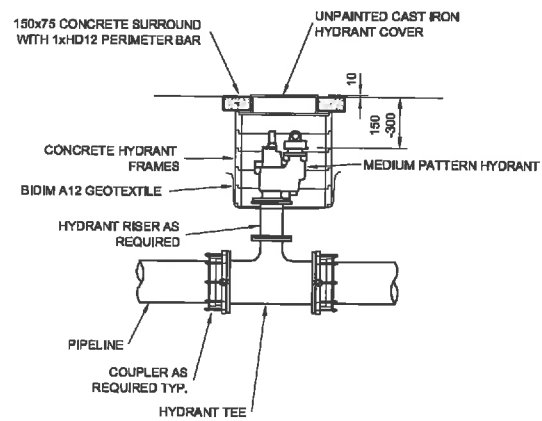

TYPICAL HYDRANT INSTALLATION
NTS

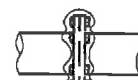

FLANGE JOINT

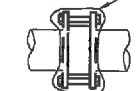


GIBAULT JOINT


NOTE: WRAPPING OF JOINTS IS NOT REQUIRED ONLY IF ALL BURIED COMPONENTS ARE EITHER SS OR NYLONEPOXY COATED

FLANGE AND GIBAULT TOTALLY ENCASED IN PETROLATUM MASTIC, TAPE AND OUTER WRAP

JOINT WRAPPING DETAILS
NTS

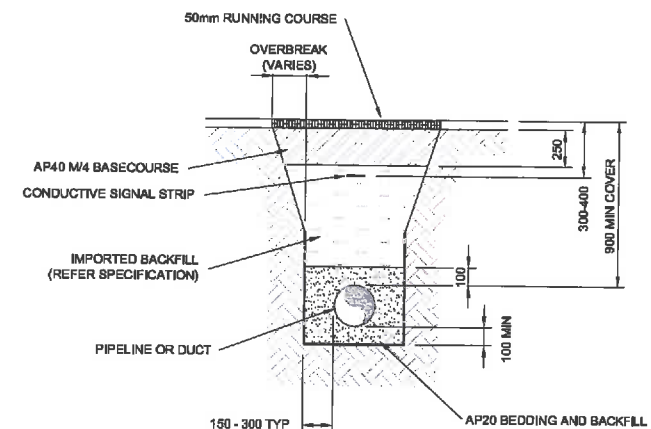


TRENCH DETAILS - METAL AREAS
NTS

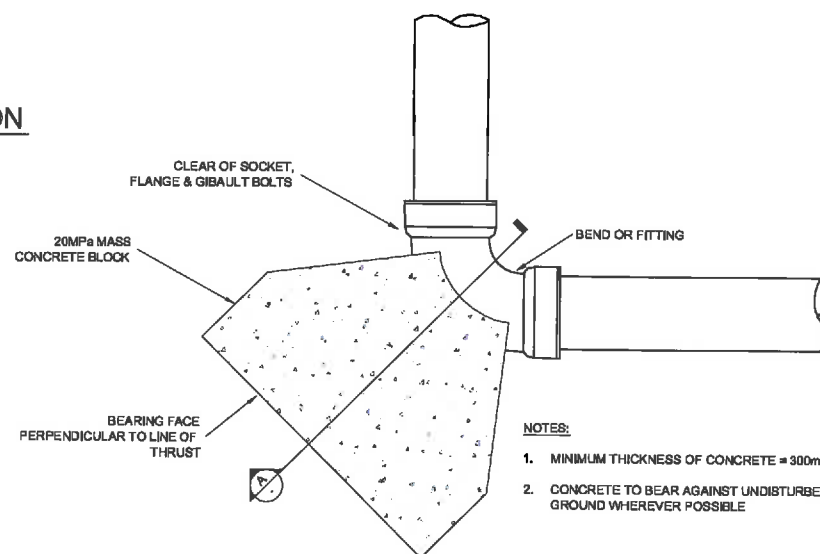

NOTES:

1. MINIMUM THICKNESS OF CONCRETE = 300mm
2. CONCRETE TO BEAR AGAINST UNDISTURBED GROUND WHEREVER POSSIBLE

TYPICAL THRUST BLOCK DETAIL
NTS

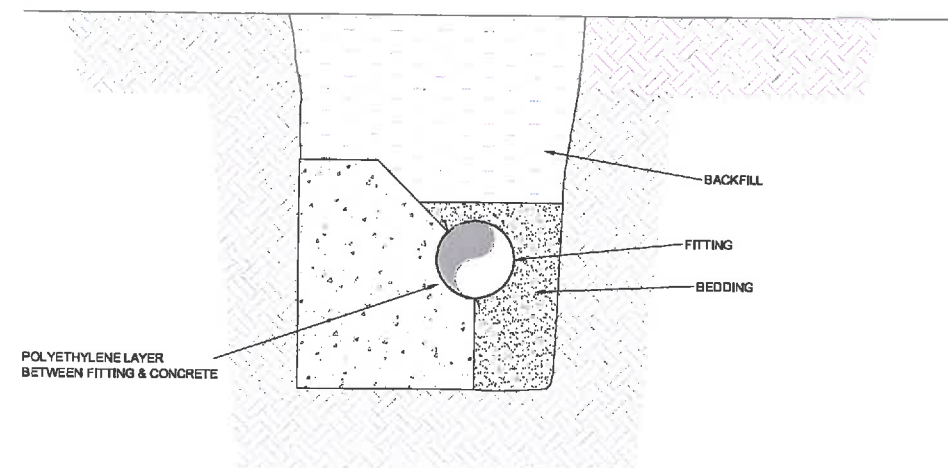

SECTION A-A
Scale: 1:20

AS BUILT

CERTIFIED BY: *[Signature]*
DESIGNATION: *Senior Civil Engineer*
DATE: *21/7/2014*

Revision	Amendment	Approved	Revision Date
RAB	CERTIFIED AS RAB		05/14



Christchurch Environmental
+64 3 383 5400

PO Box 1482
Christchurch 8140
New Zealand

Drawn: GB
Designed: GB
Approved: GB
Revision Date: MAY 2014

Project No: 3C1004.51

Scale: AS SHOWN (A1)









Project: SELWYN DISTRICT COUNCIL
DARFIELD WATER SUPPLY UPGRADE
CONTRACT 1133

Client: SITE PIPELINES
STANDARD DETAILS

Drawing No: 6/1515/19/7605

AS BUILT

Sheet No: 11
Revised: RAB

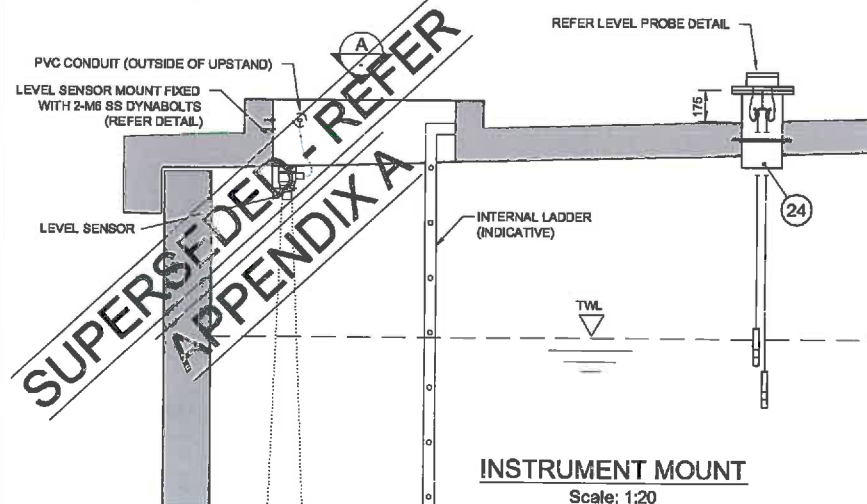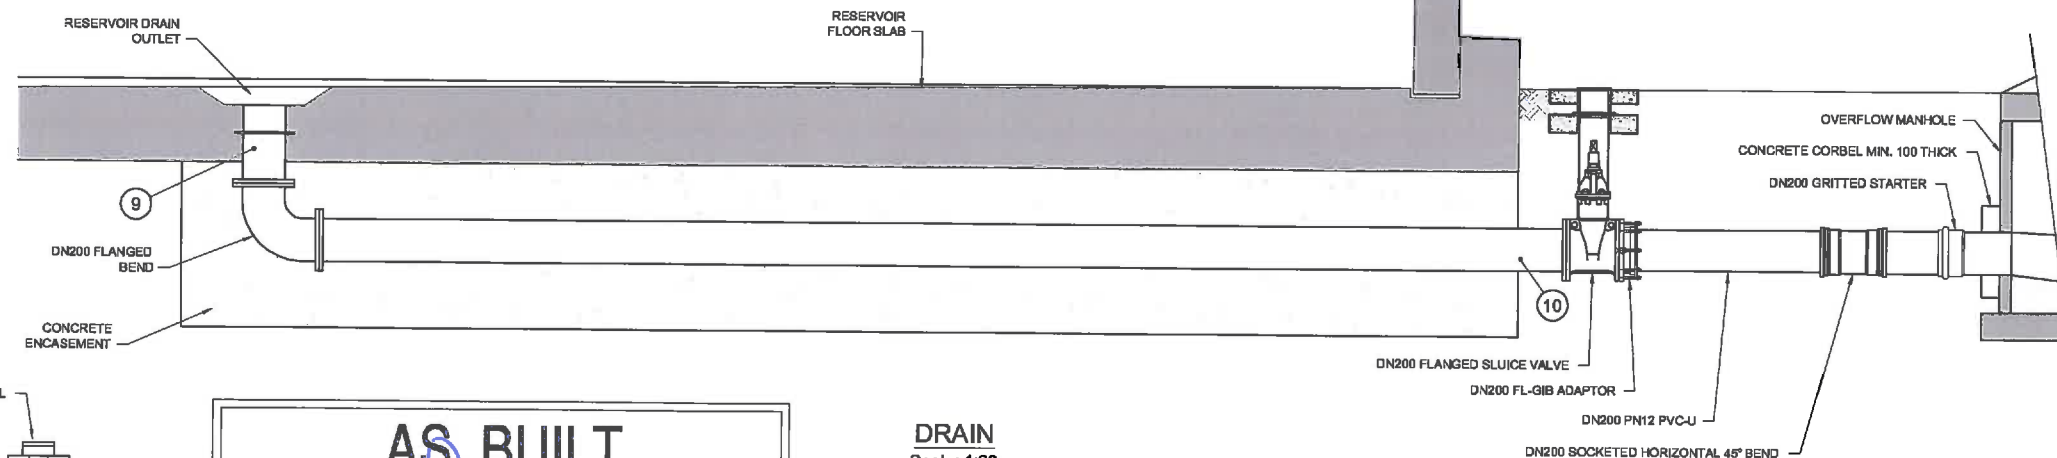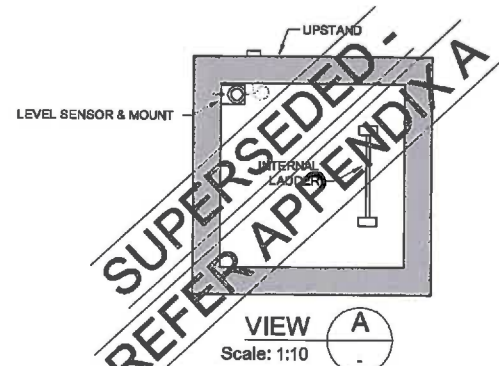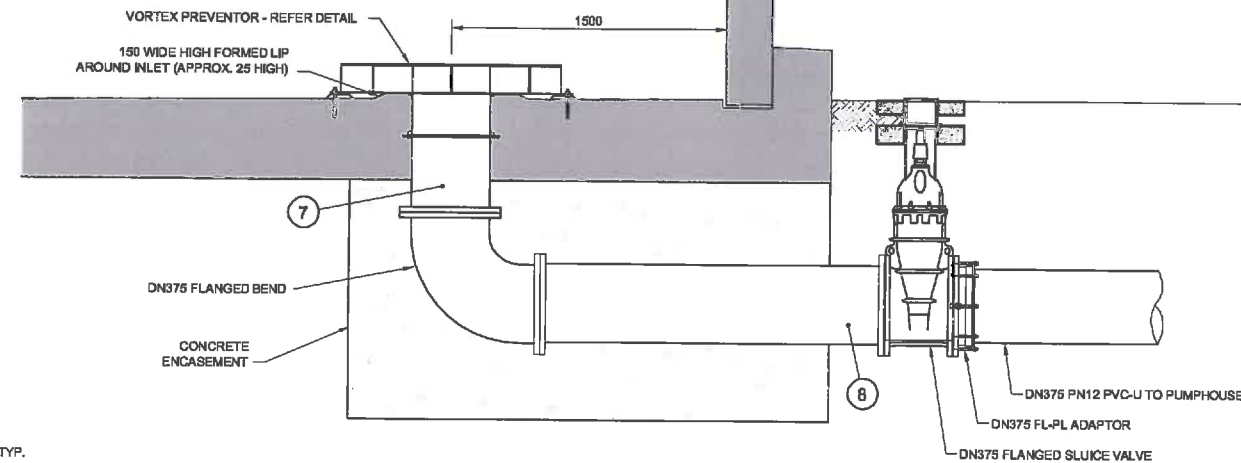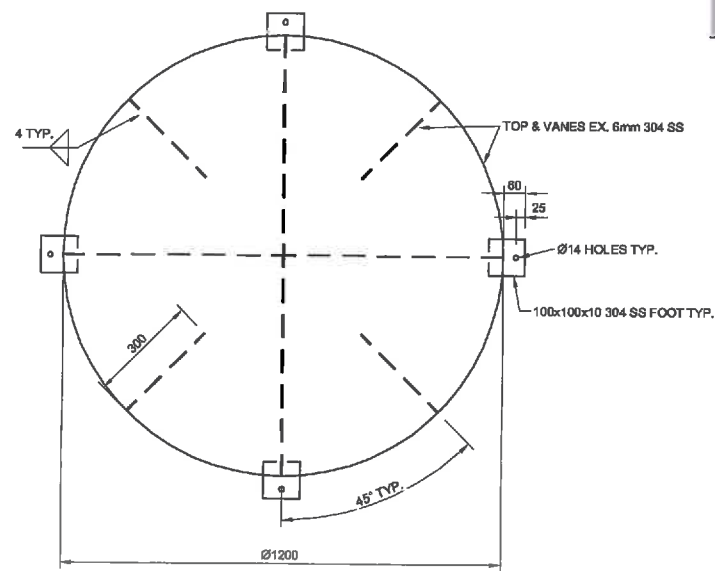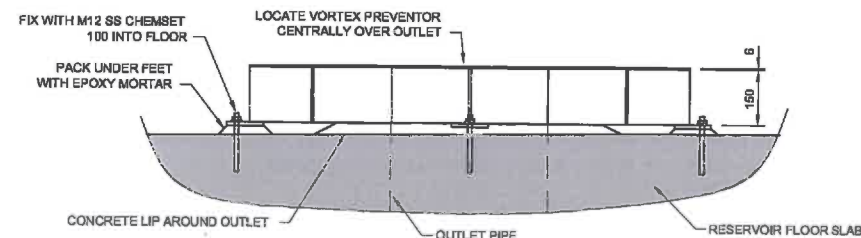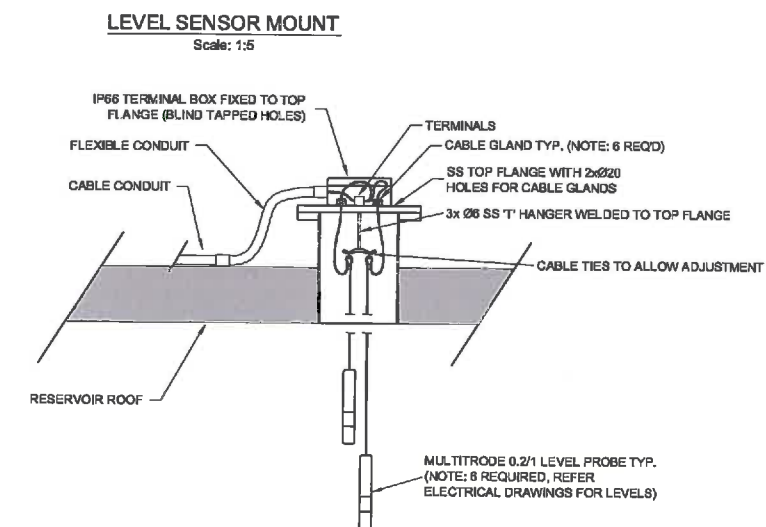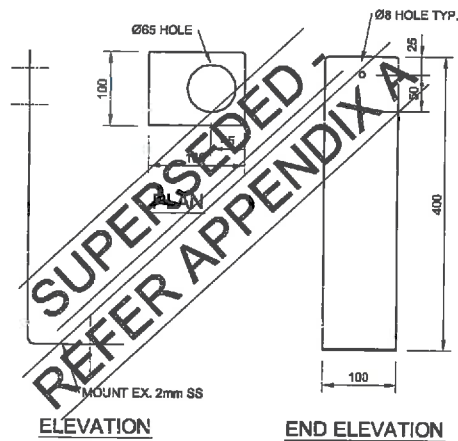

AS BUILT
CERTIFIED BY: *[Signature]*
DESIGNATION: *[Signature]*
DATE: 21/7/2014

Revision	Approved	Revision Date
RAB	CERTIFIED AS RAB	09/14



Christchurch Environmental
+64 3 363 5400

PO Box 1482
Christchurch 8140
New Zealand

SELWYN DISTRICT COUNCIL
DARFIELD WATER SUPPLY UPGRADE
CONTRACT 1133



















RESERVOIR
PIPE CONNECTION DETAILS 2

Drawn: GB
Checked: GB
Approved: MAY 2014

Project No: 3C1004.51
Scale: AS SHOWN (A1)

Sheet No: 13
Revision: RAB

300 mm
200
100
50
0 10 mm

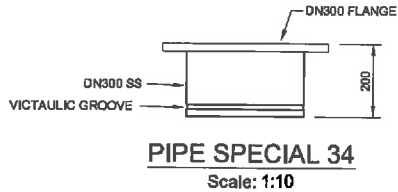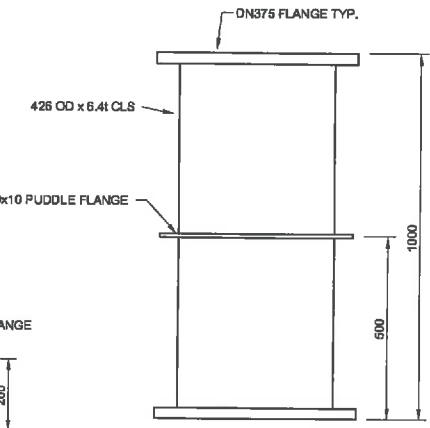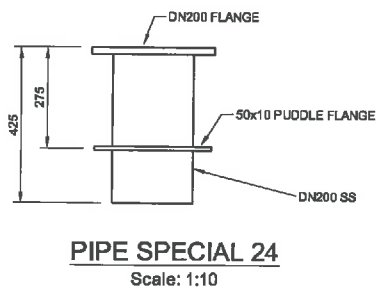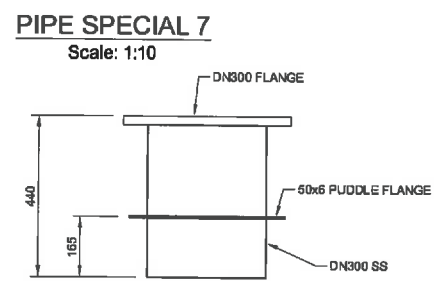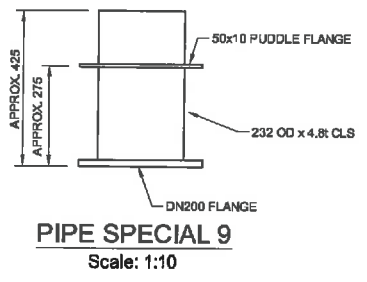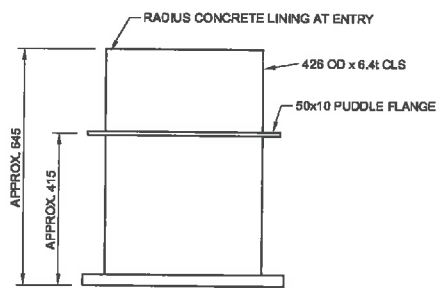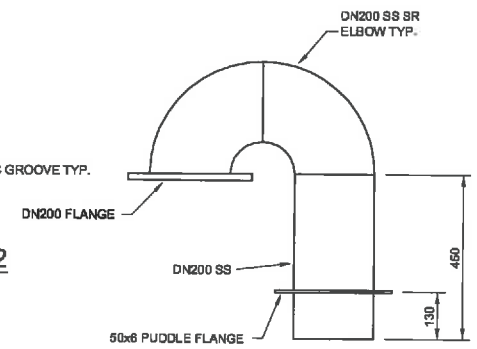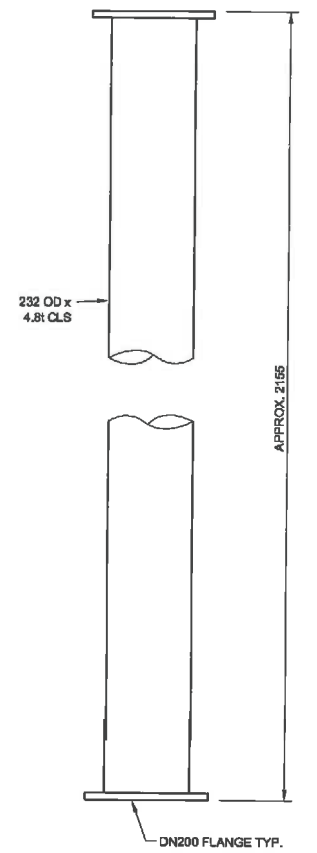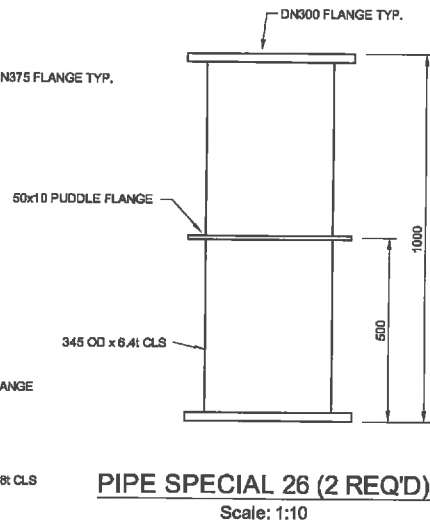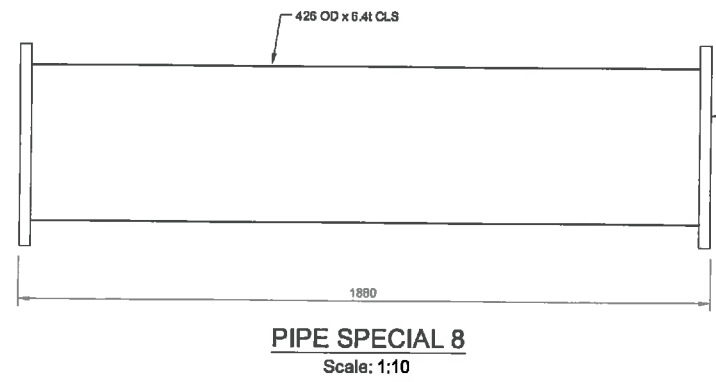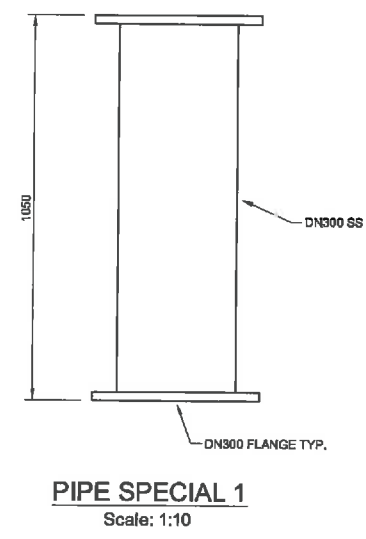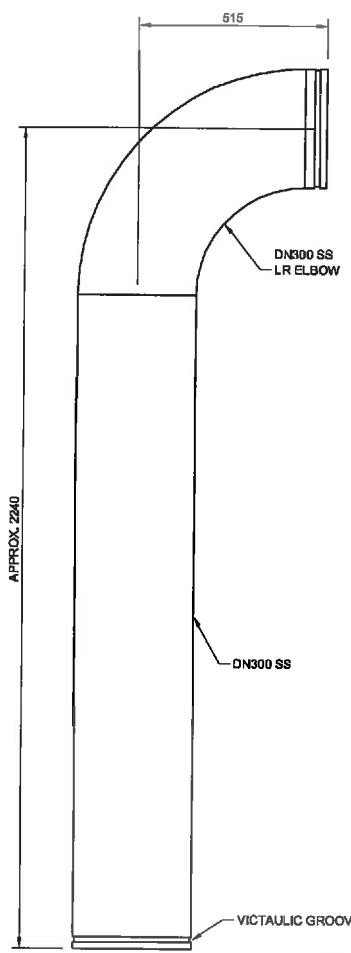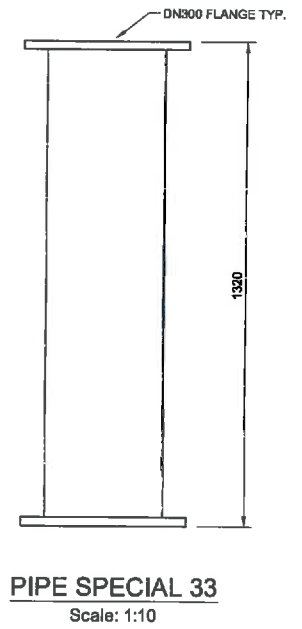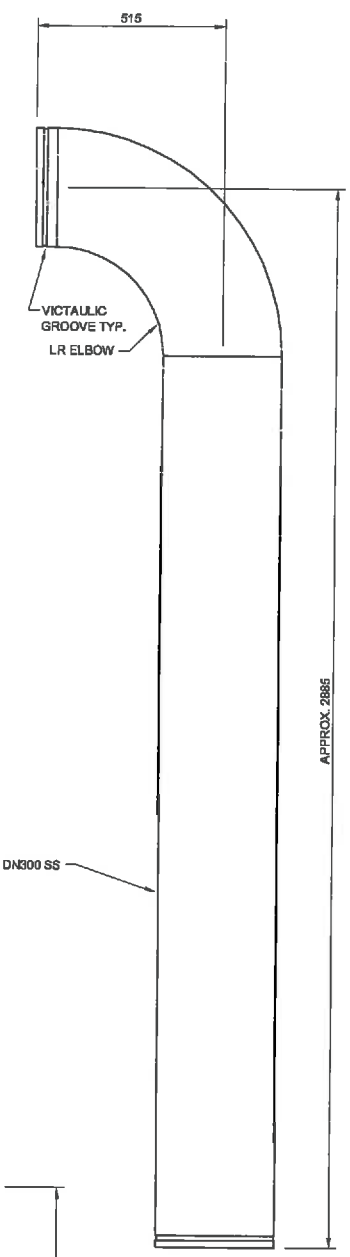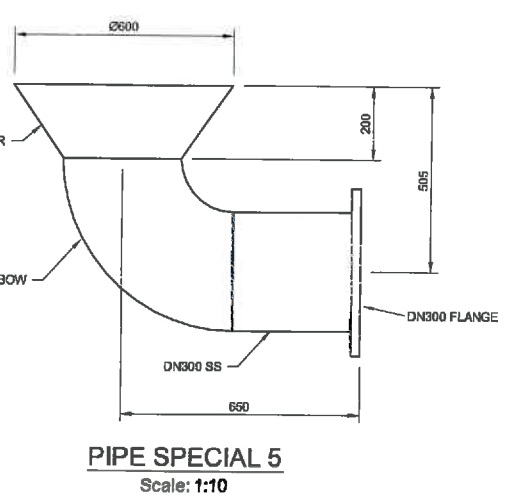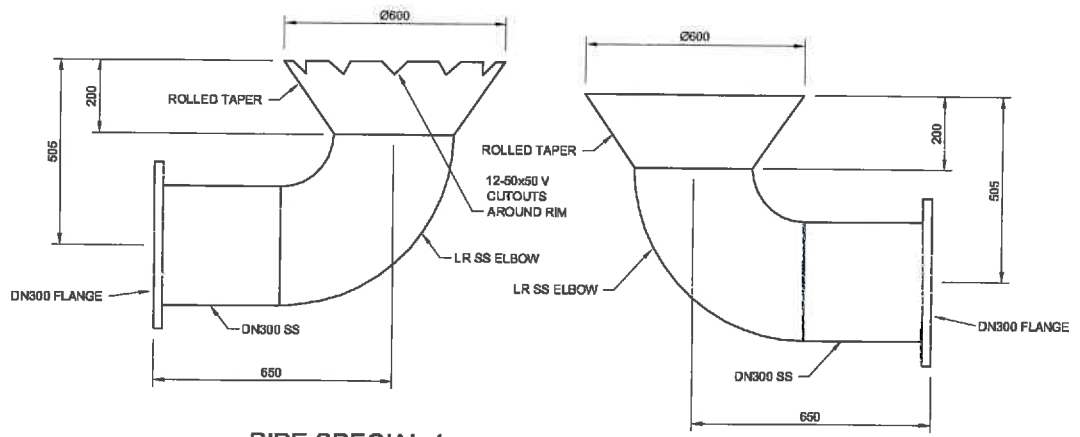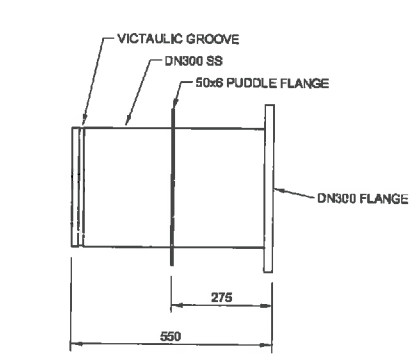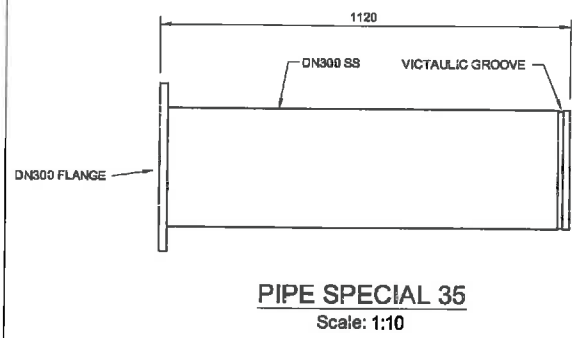


- NOTES:**
1. ALL QUANTITIES 1 UNLESS OTHERWISE STATED
 2. ALL CLS (CONCRETE LINED STEEL) PIPE TO NZS 4442
 3. CLS PIPE TO BE TAPE WRAPPED UNLESS OTHERWISE STATED
 4. ALL 'SS' PIPE TO BE 304 STAINLESS STEEL TO ASTM A312 UNLESS OTHERWISE STATED
 5. ALL FLANGES TO AS4087 MINIMUM RATING PN16
 6. ALL FLANGES TO BE SEAL WELDED
 7. MINIMUM WELD ROOT THICKNESS 4mm OR PIPE WALL THICKNESS
 8. SS WELDS TO BE MADE WITH PIPES PURGED AND FILLED WITH INERT GAS, AND IMMEDIATELY REPASSIVATED AND POLISHED (REFER SPECIFICATION)

AS BUILT
CERTIFIED BY: *[Signature]*
DESIGNATION: *[Signature]*
DATE: 21/7/2014


Revision	Amendment	Approval	Revision Date
RAB	CERTIFIED AS RAB	GB	05/14




Project	SELWYN DISTRICT COUNCIL DARFIELD WATER SUPPLY UPGRADE CONTRACT 1133
Sheet No.	14
Revision	RAB
Project No.	3C1004.51
Scale	AS SHOWN (A1)
Drawing Date	6/15/19/7605

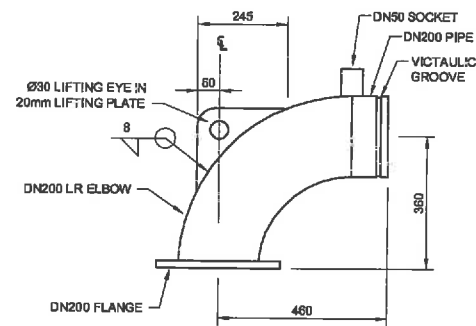


PIPE SPECIAL 29
Scale: 1:10

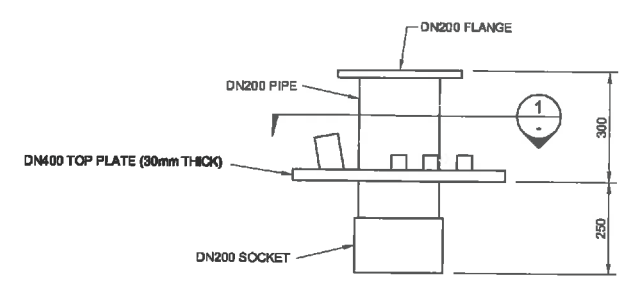


PIPE SPECIAL 28
Scale: 1:10

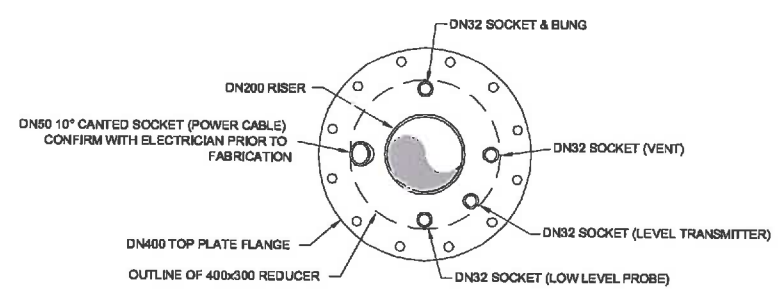


SECTION
Scale: 1:10

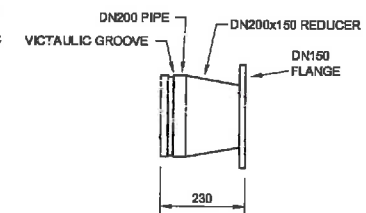

PIPE SPECIAL 30
Scale: 1:10

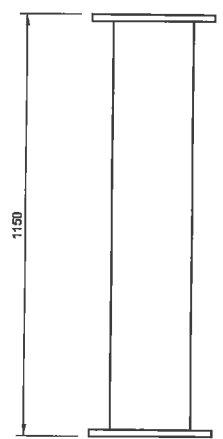


PIPE SPECIAL 32
Scale: 1:10

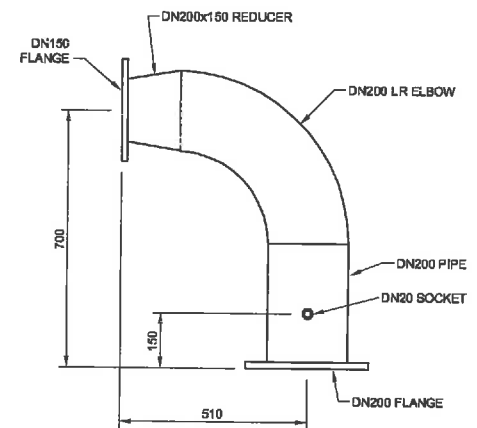


PIPE SPECIAL 31
Scale: 1:10

- NOTES:**
1. ALL QUANTITIES 1 UNLESS OTHERWISE STATED
 2. ALL PIPE TO BE SCH40 CARBON STEEL LINEPIPE UNLESS OTHERWISE STATED
 3. ALL FLANGES TO AS4087 MINIMUM RATING PN16
 4. ALL FLANGES TO BE SEAL WELDED
 5. MINIMUM WELD ROOT THICKNESS 4mm OR PIPE WALL THICKNESS UNLESS NOTED OTHERWISE
 6. ALL PIPE SPECIALS TO BE HOT DIP GALVANISED FOLLOWING FABRICATION

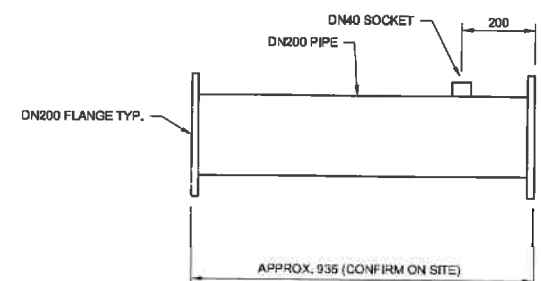

PIPE SPECIAL 27
Scale: 1:10

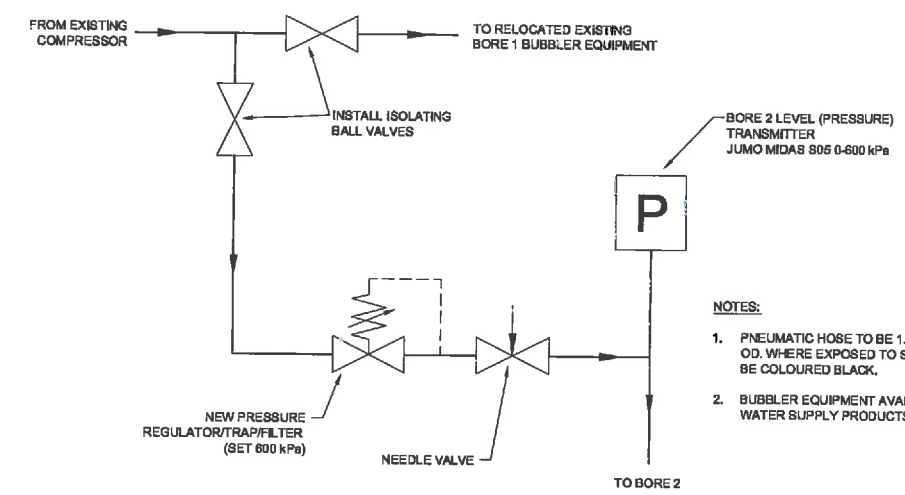

BUBBLER SYSTEM SCHEMATIC
NTS

- NOTES:**
1. PNEUMATIC HOSE TO BE 1.5 MPa 10mm OD. WHERE EXPOSED TO SUNLIGHT TO BE COLOURED BLACK.
 2. BUBBLER EQUIPMENT AVAILABLE FROM WATER SUPPLY PRODUCTS LTD.

AS BUILT

CERTIFIED BY: *[Signature]*

DESIGNATION: *Senior Civil Engineer*

DATE: *21/7/2014*

Revision	Amendment	Approved	Revision Date
RAB	CERTIFIED AS RAB		05/14




OPUS

Christchurch Environmental
+64 3 363 5400


PO Box 1482
Christchurch 8140
New Zealand

Project:	SELWYN DISTRICT COUNCIL DARFIELD WATER SUPPLY UPGRADE CONTRACT 1133
Sheet:	BOREHEAD PIPE SPECIALS
Project No:	3C1004.51
Revision:	AS SHOWN (A1)
Drawing No:	6/1515/19/7605
Sheet No:	21
Revision:	RAB

300 mm
200
100
50
0 10 mm

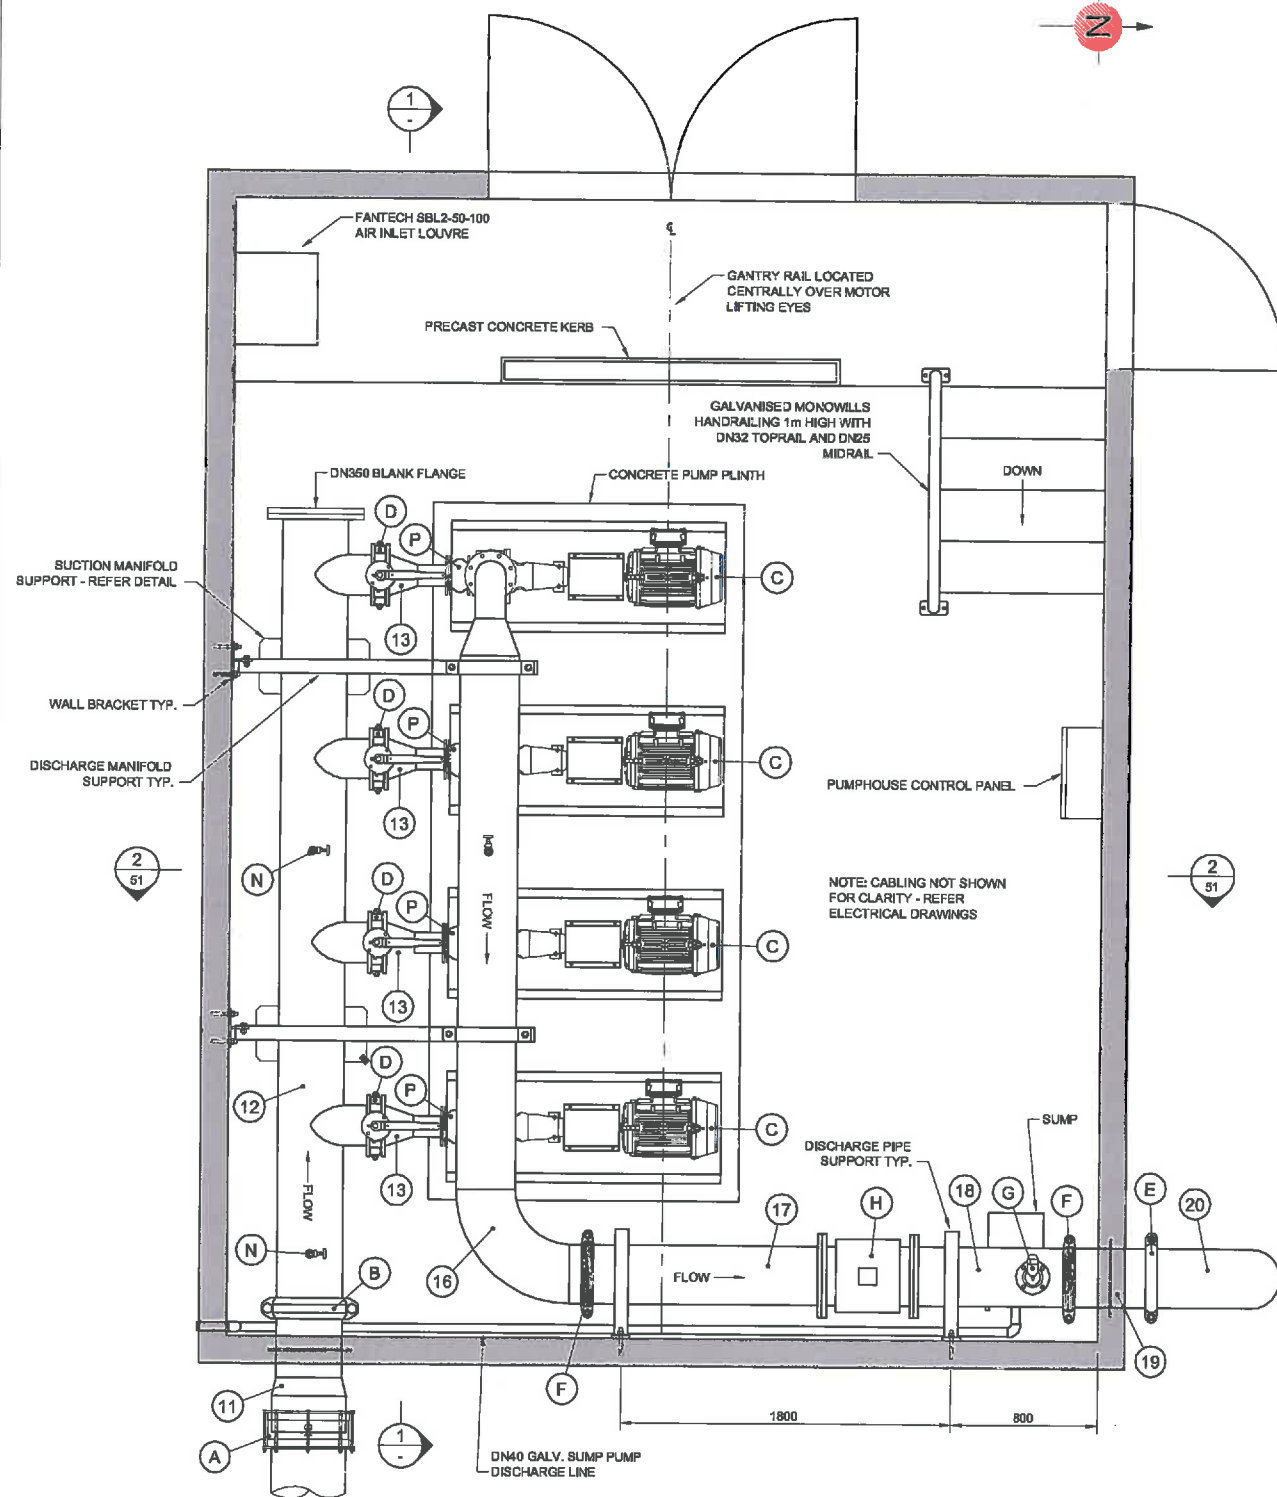

PUMPHOUSE PLAN
Scale: 1:20

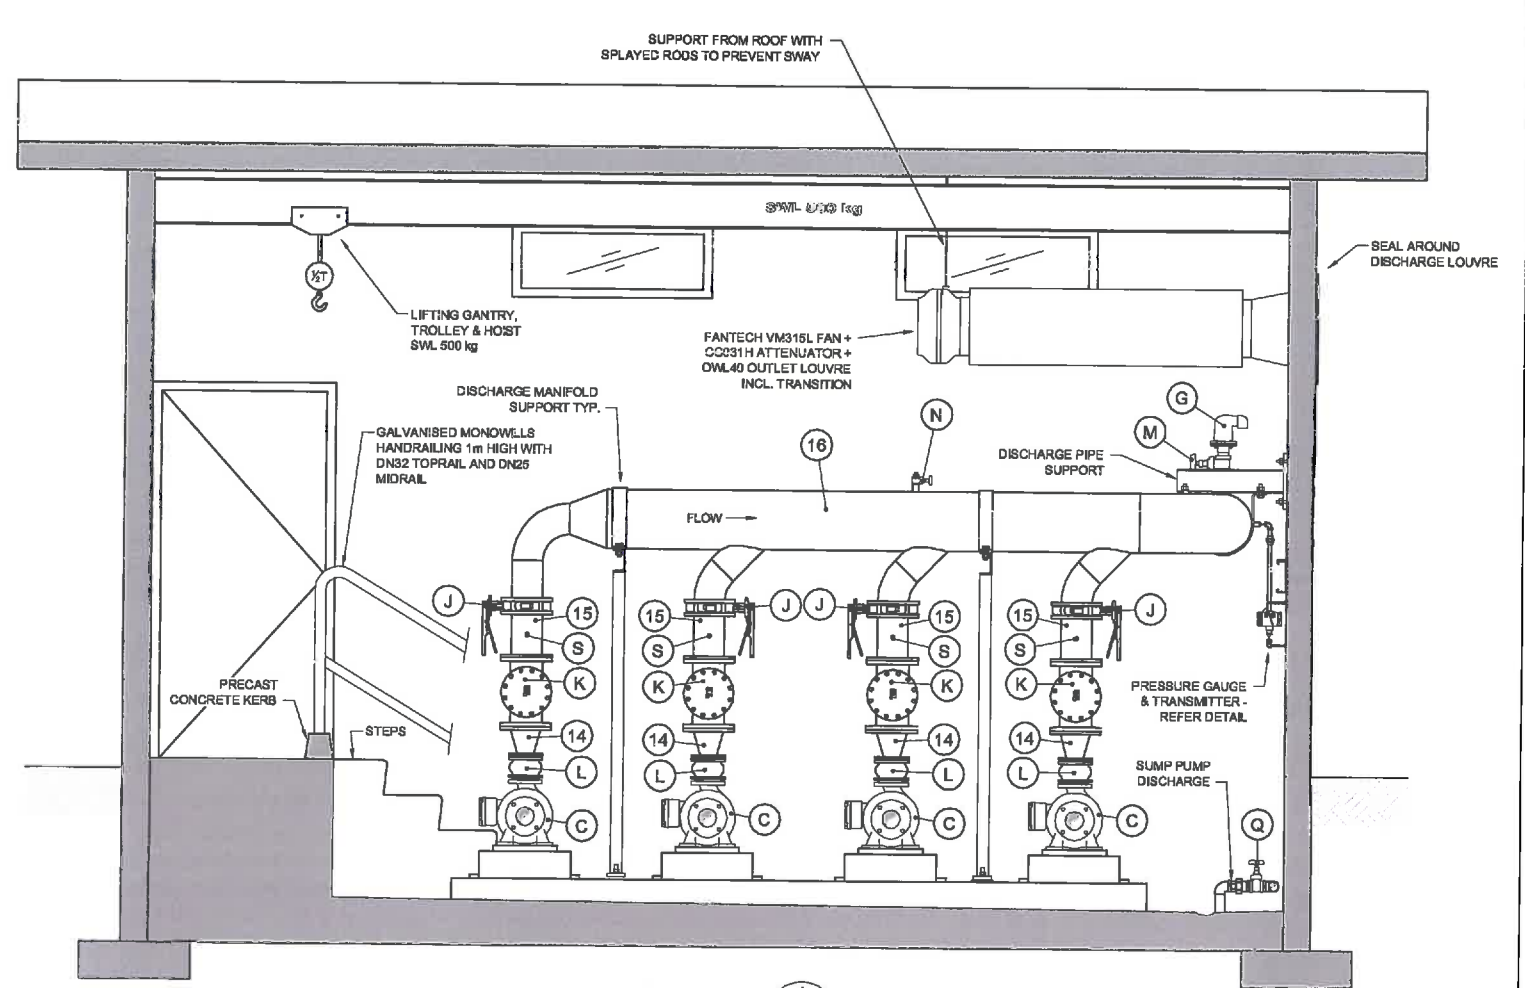

SECTION 1
Scale: 1:20

RETIC PUMPS PIPE & FITTINGS SCHEDULE			
ITEM	DESCRIPTION	MATERIAL	QTY.
A	DN375 MULTIFIT GIBULY	SS/COATED STEEL	1
B	DN350 STYLE W77 VICTAULIC COUPLER	GALV.	1
C	100x80-180 RETICULATION PUMP WITH 18.5 kW WEG V22 MOTOR	N/A	4
D	DN200 KEYSTONE FIG. 812 BFV & LEVER ACTUATOR	DVSS/EPDM	4
E	DN300 STYLE 77 VICTAULIC COUPLER	DVSS/EPDM	2
F	DN300 STYLE 07 (RIGID) COUPLER	DVSS/EPDM	2
G	DN50 ARI D-040-C AIR VALVE	CI/EPOXY	1
H	DN300 KROHNE OPTIFLUX 2000 FLOWMETER	N/A	1
J	DN150 KEYSTONE FIG. 812 BFV WITH LEVER ACTUATOR	DVSS/EPDM	4
K	DN150 VALMATIC SURGEBUSTER CHECK VALVE WITH INDICATOR & LIMIT SWITCH	CI/EPOXY	4
L	DN80 TYCO FSF BELLOWS	EPDM/GALV.	4
M	DN50 GATE VALVE	BRZ/DR BRASS	1
N	DN25 GATE VALVE & PLUG	BRZ/DR BRASS	4
P	DN100 TYCO FSF BELLOWS	EPDM/GALV.	4
Q	DN40 GATE VALVE	BRZ/DR BRASS	1
R	DN80 FLANGE DRILLED DN50 BSP & NIPPLE	SS	1
S	DN15 M&F BALL VALVE	SS	4
T	LOWARA DOC7 SUMP PUMP WITH FLOAT	SS	1
U	DN32x40 REDUCER & DN40 CHECK VALVE	BRZ/DR BRASS	1

AS BUILT


AS BUILT
CERTIFIED BY: *[Signature]*
DESIGNATION: *[Signature]*
DATE: 21/7/2014

Revision	Approved	Approved	Revision Date
RAB	CERTIFIED AS RAB	GB	09/14




Christchurch Environmental
+64 3 353 5400
PO Box 1482
Christchurch 8140
New Zealand


Project
SELWYN DISTRICT COUNCIL
DARFIELD WATER SUPPLY UPGRADE
CONTRACT 1133
Drawing No.
PUMPHOUSE
MECHANICAL DETAILS 1
6/1515/19/7605

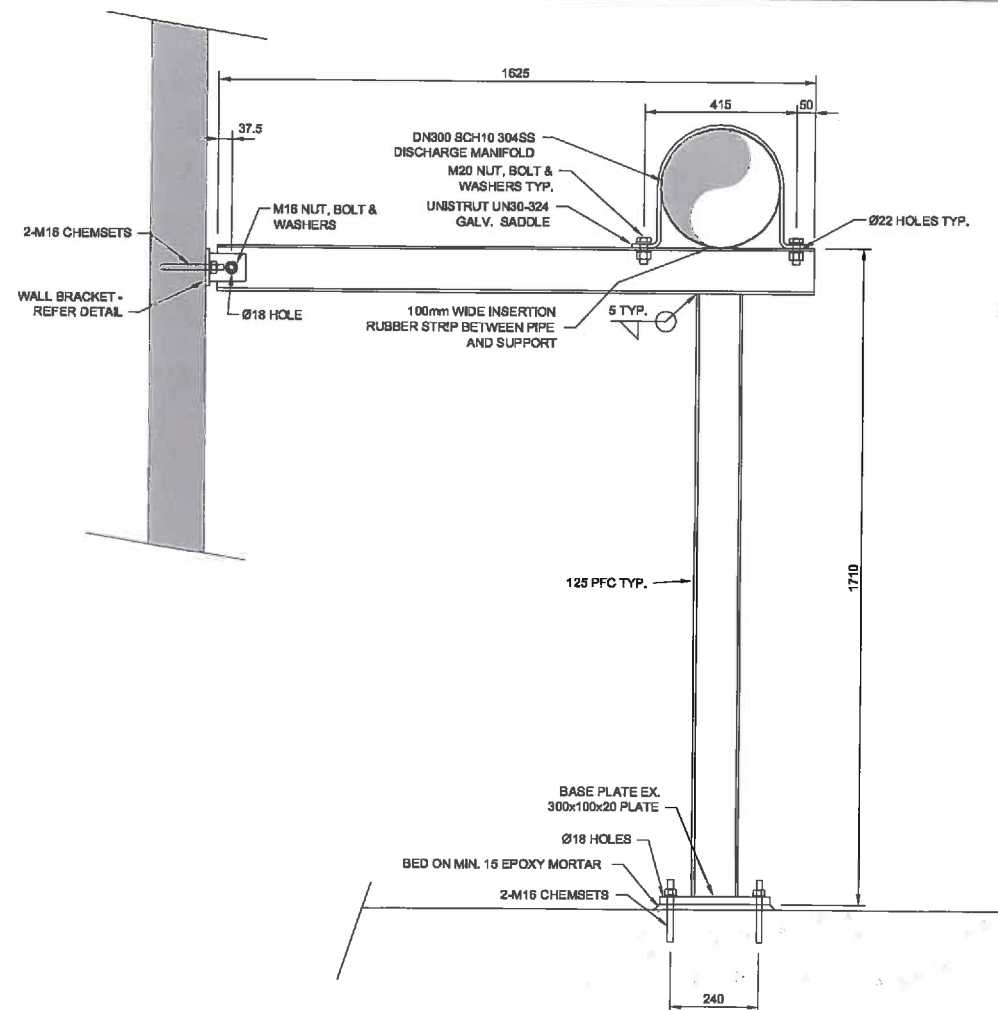


DISCHARGE MANIFOLD SUPPORT DETAIL
(2 REQ'D)
Scale: 1:10

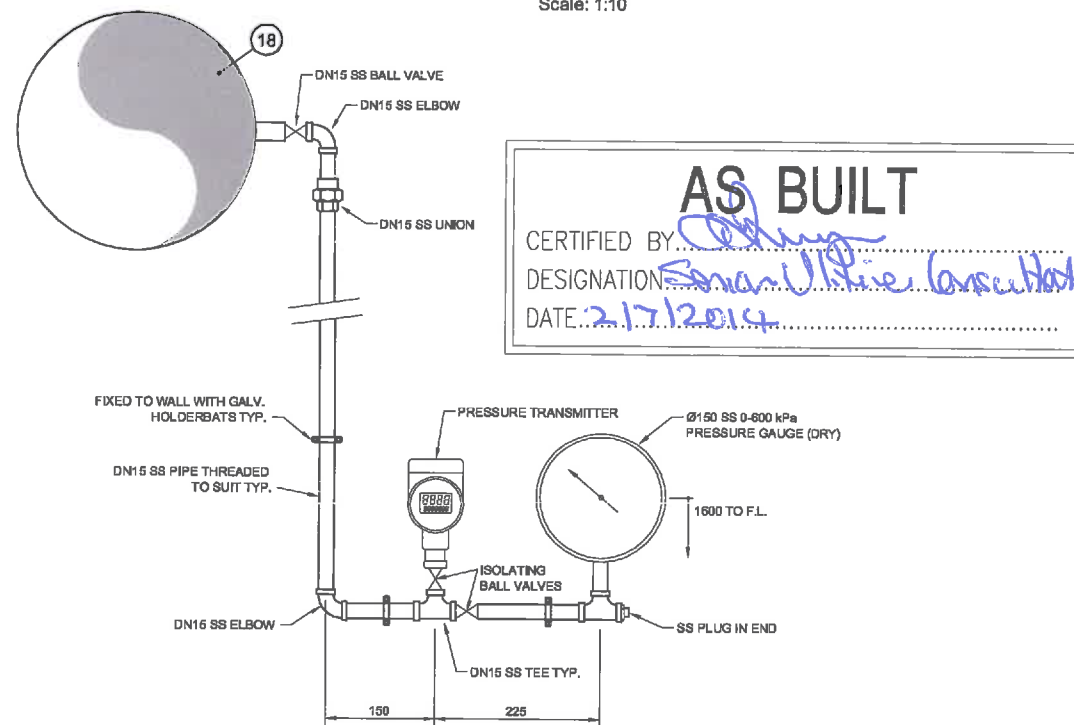


PRESSURE INSTRUMENTATION DETAIL
Scale: 1:5

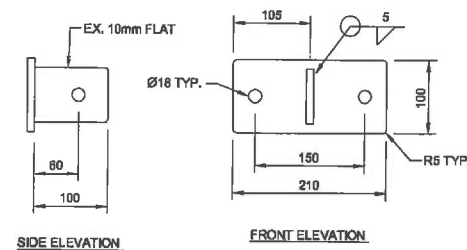

WALL BRACKET DETAILS (2 REQ'D)
Scale: 1:5

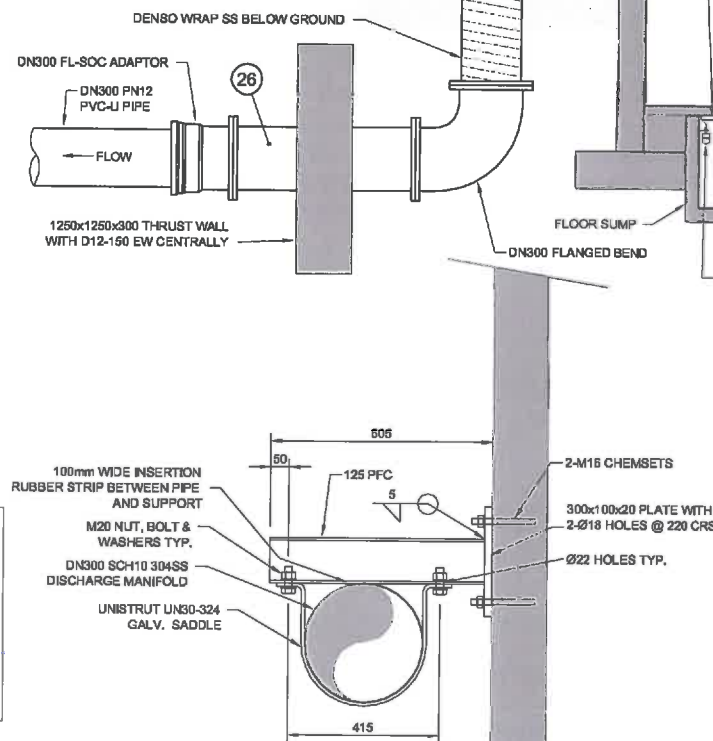

DISCHARGE PIPE SUPPORT DETAIL (2 REQ'D)
Scale: 1:10

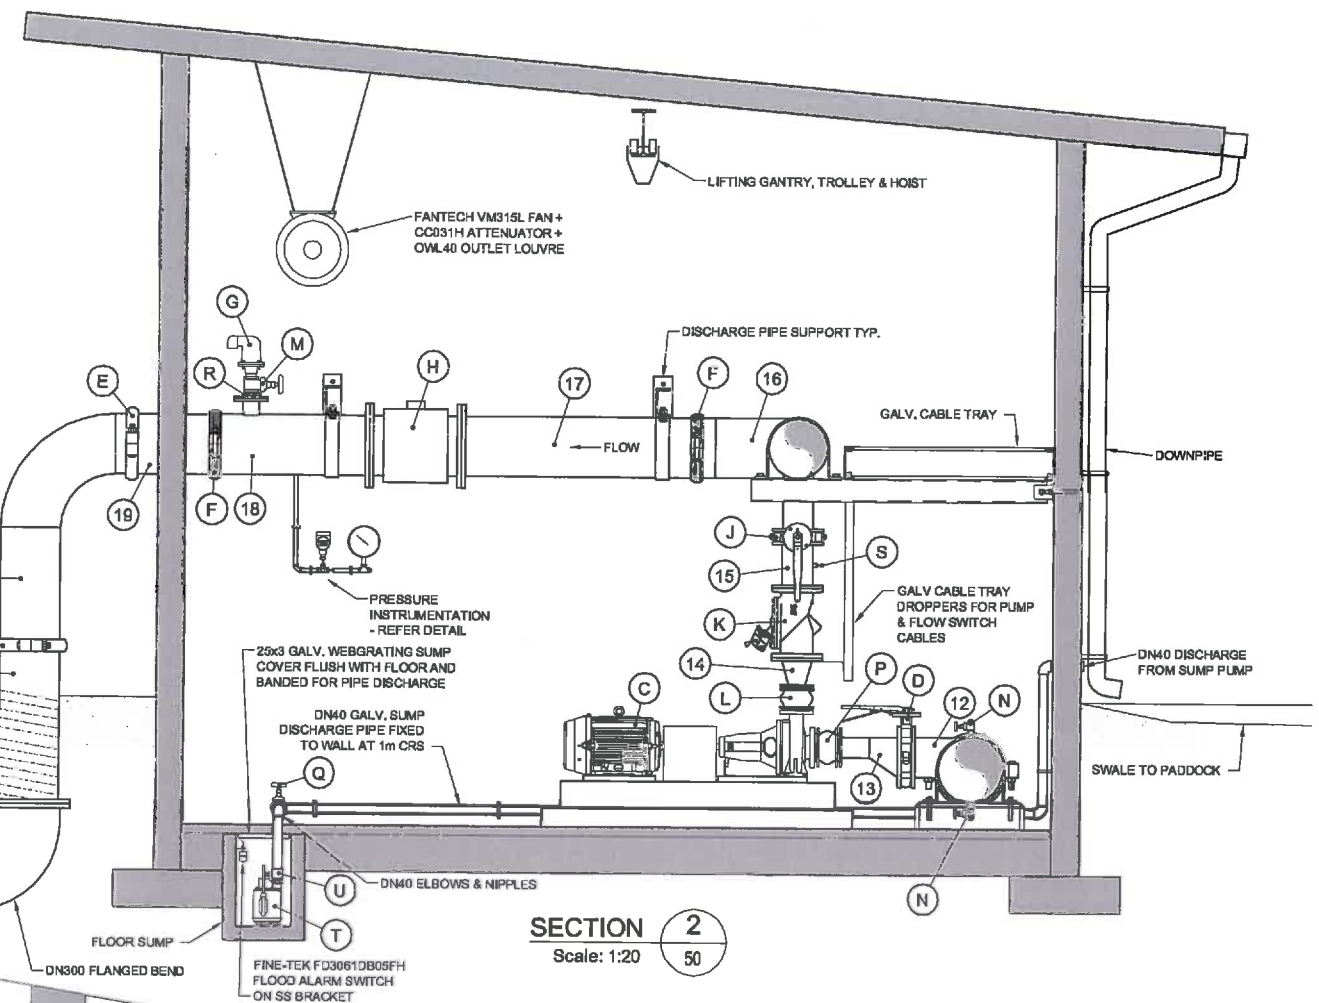

SECTION 2
Scale: 1:20

ITEM	DESCRIPTION	MATERIAL	QTY.
A	DN375 MULTIFIT GIBBULT	SS/COATED STEEL	1
B	DN350 STYLE W77 VICTAULIC COUPLER	GALV.	1
C	100x80-160 RETICULATION PUMP WITH 18.5 KW WEG W22 MOTOR	N/A	4
D	DN200 KEYSTONE FIG. 612 BFV & LEVER ACTUATOR	DV/SS/EPDM	4
E	DN300 STYLE 77 VICTAULIC COUPLER	DV/SS/EPDM	2
F	DN300 STYLE 07 (RIGID) COUPLER	DV/SS/EPDM	2
G	DN80 ARI D-040-C AIR VALVE	C/PEPOXY	1
H	DN300 KROHNE OPTIFLUX 2000 FLOWMETER	N/A	1
J	DN150 KEYSTONE FIG. 612 BFV WITH LEVER ACTUATOR	DV/SS/EPDM	4
K	DN150 VALMATIC SURGE BUSTER CHECK VALVE WITH INDICATOR & LIMIT SWITCH	C/PEPOXY	4
L	DN80 TYCO FSF BELLOWS	EPDM/GALV.	4
M	DN60 GATE VALVE	BRZ./DR BRASS	1
N	DN25 GATE VALVE & PLUG	BRZ./DR BRASS	4
P	DN100 TYCO FSF BELLOWS	EPDM/GALV.	4
Q	DN40 GATE VALVE	BRZ./DR BRASS	1
R	DN80 FLANGE DRILLED DN50 BSP & NIPPLE	SS	1
S	DN15 M&F BALL VALVE	SS	4
T	LOWARA DOCT SUMP PUMP WITH FLOAT	SS	1
U	DN32x40 REDUCER & DN40 CHECK VALVE	BRZ./DR BRASS	1

AS BUILT

Revised	Approved	Approved	Revised Date
RAB	CERTIFIED AS RAB		05/14



Christchurch Environmental
+64 3 383 5400

PO Box 1482
Christchurch 8140
New Zealand

Project:
SELWYN DISTRICT COUNCIL
DARFIELD WATER SUPPLY UPGRADE
CONTRACT 1133


Sheet:
PUMPHOUSE
MECHANICAL DETAILS 2

Drawn: GB
Revised: GB
Approved: GB
Revised Date: MAY 2014


Project No: 3C1004.51
Scale: AS SHOWN (A1)

Drawing No: 6/1515/197605


Sheet No: 51
Revised: RAB

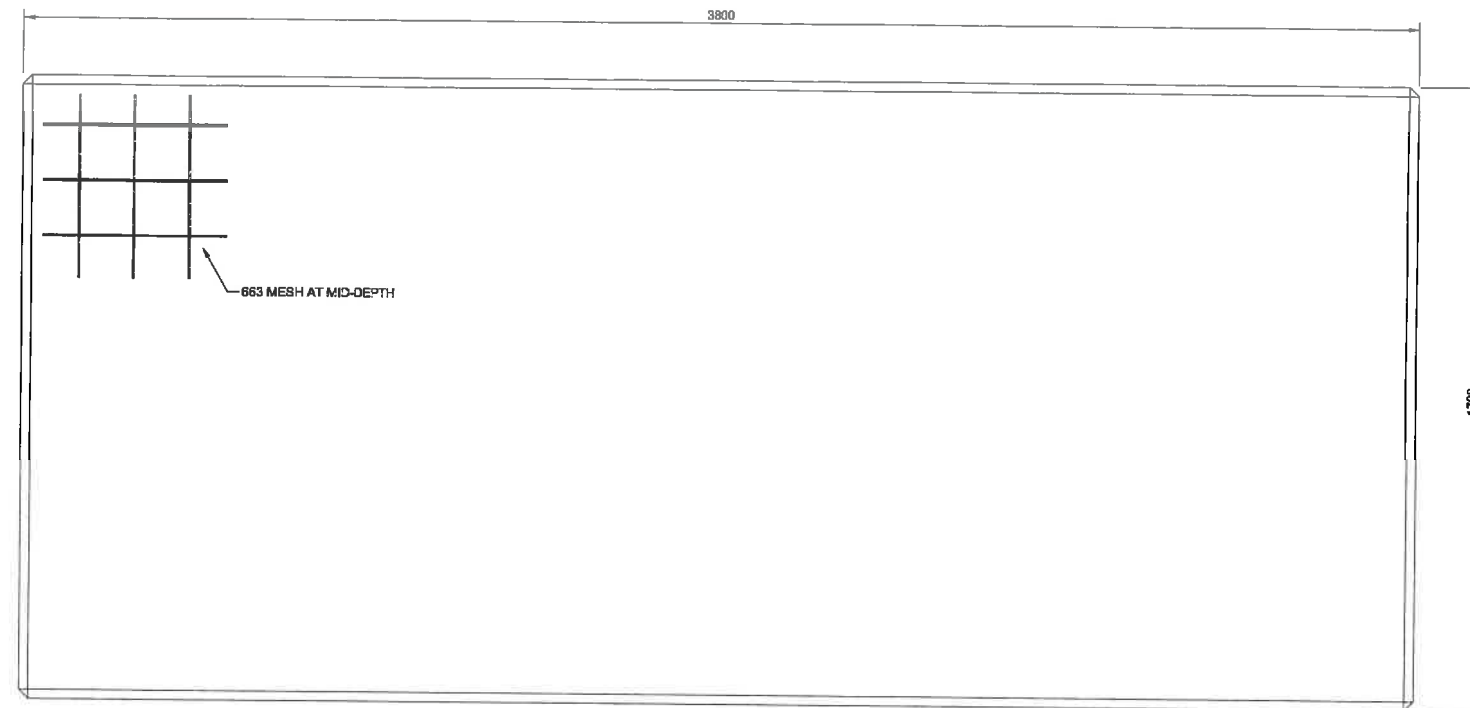


PUMP PLINTH PLAN
Scale: 1:10

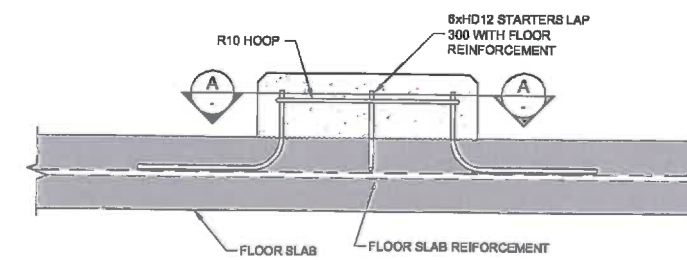


SUCTION PIPE PLINTH REINFORCING
Scale: 1:10

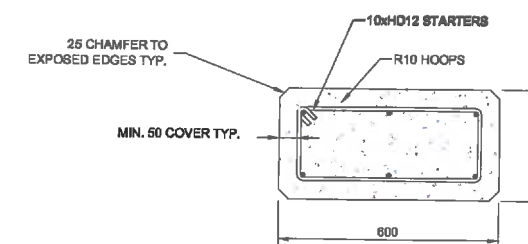


SECTION
Scale: 1:20

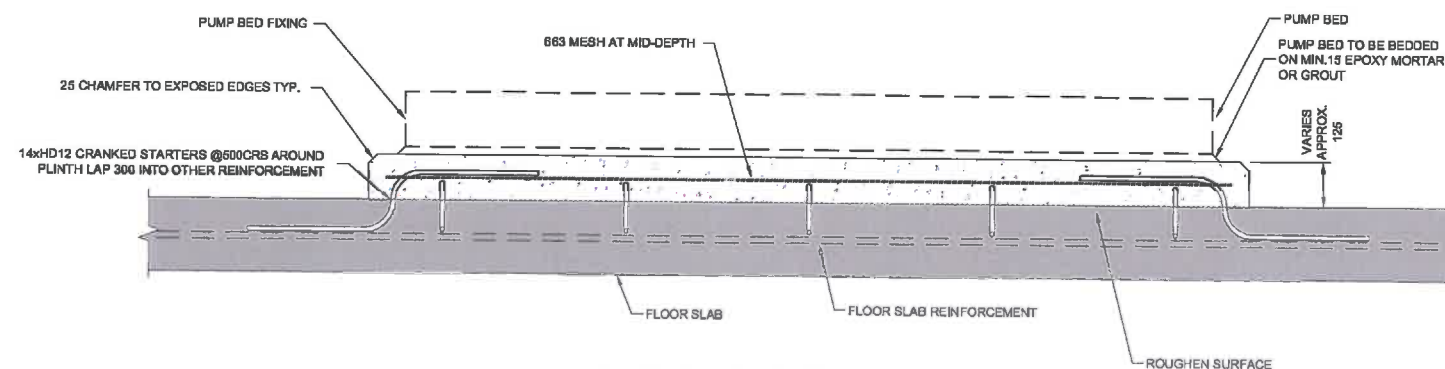

PUMP PLINTH ELEVATION
Scale: 1:10

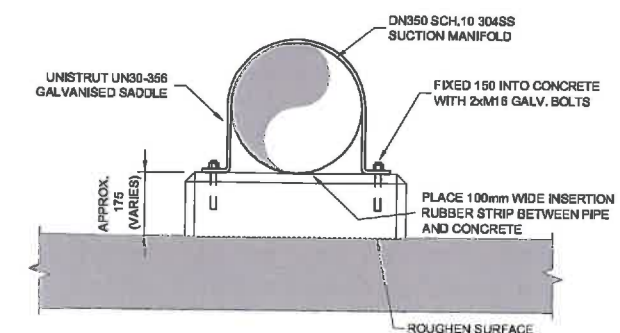

SUCTION PIPE PLINTH FRONT ELEVATION

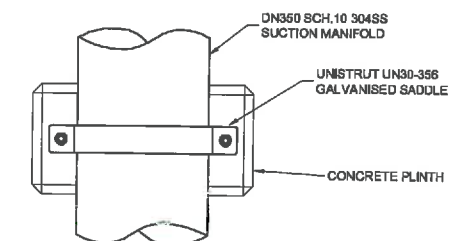

SUCTION PIPE PLINTH PLAN
Scale: 1:10

AS BUILT

CERTIFIED BY: *[Signature]*
DESIGNATION: *Senior Civil Engineer*
DATE: *21/12/2014*


Revision	Amendment	Approved	Revised Date
RAB	CERTIFIED AS RAB		05/14



Drawn	Checked	Approved	Revised Date
GB	GB		MAY 2014
Project No.	Drawn	Sheet	Revised
3C1004.51	AS SHOWN (A1)		

Project		AS BUILT	
Selwyn District Council DARFIELD WATER SUPPLY UPGRADE CONTRACT 1133			
Sheet			
PUMPHOUSE PLINTH DETAILS			
Drawn No.	Sheet No.	Revised	
6/1515/19/7605	52	RAB	

300 mm
200
100
50
10 mm
0

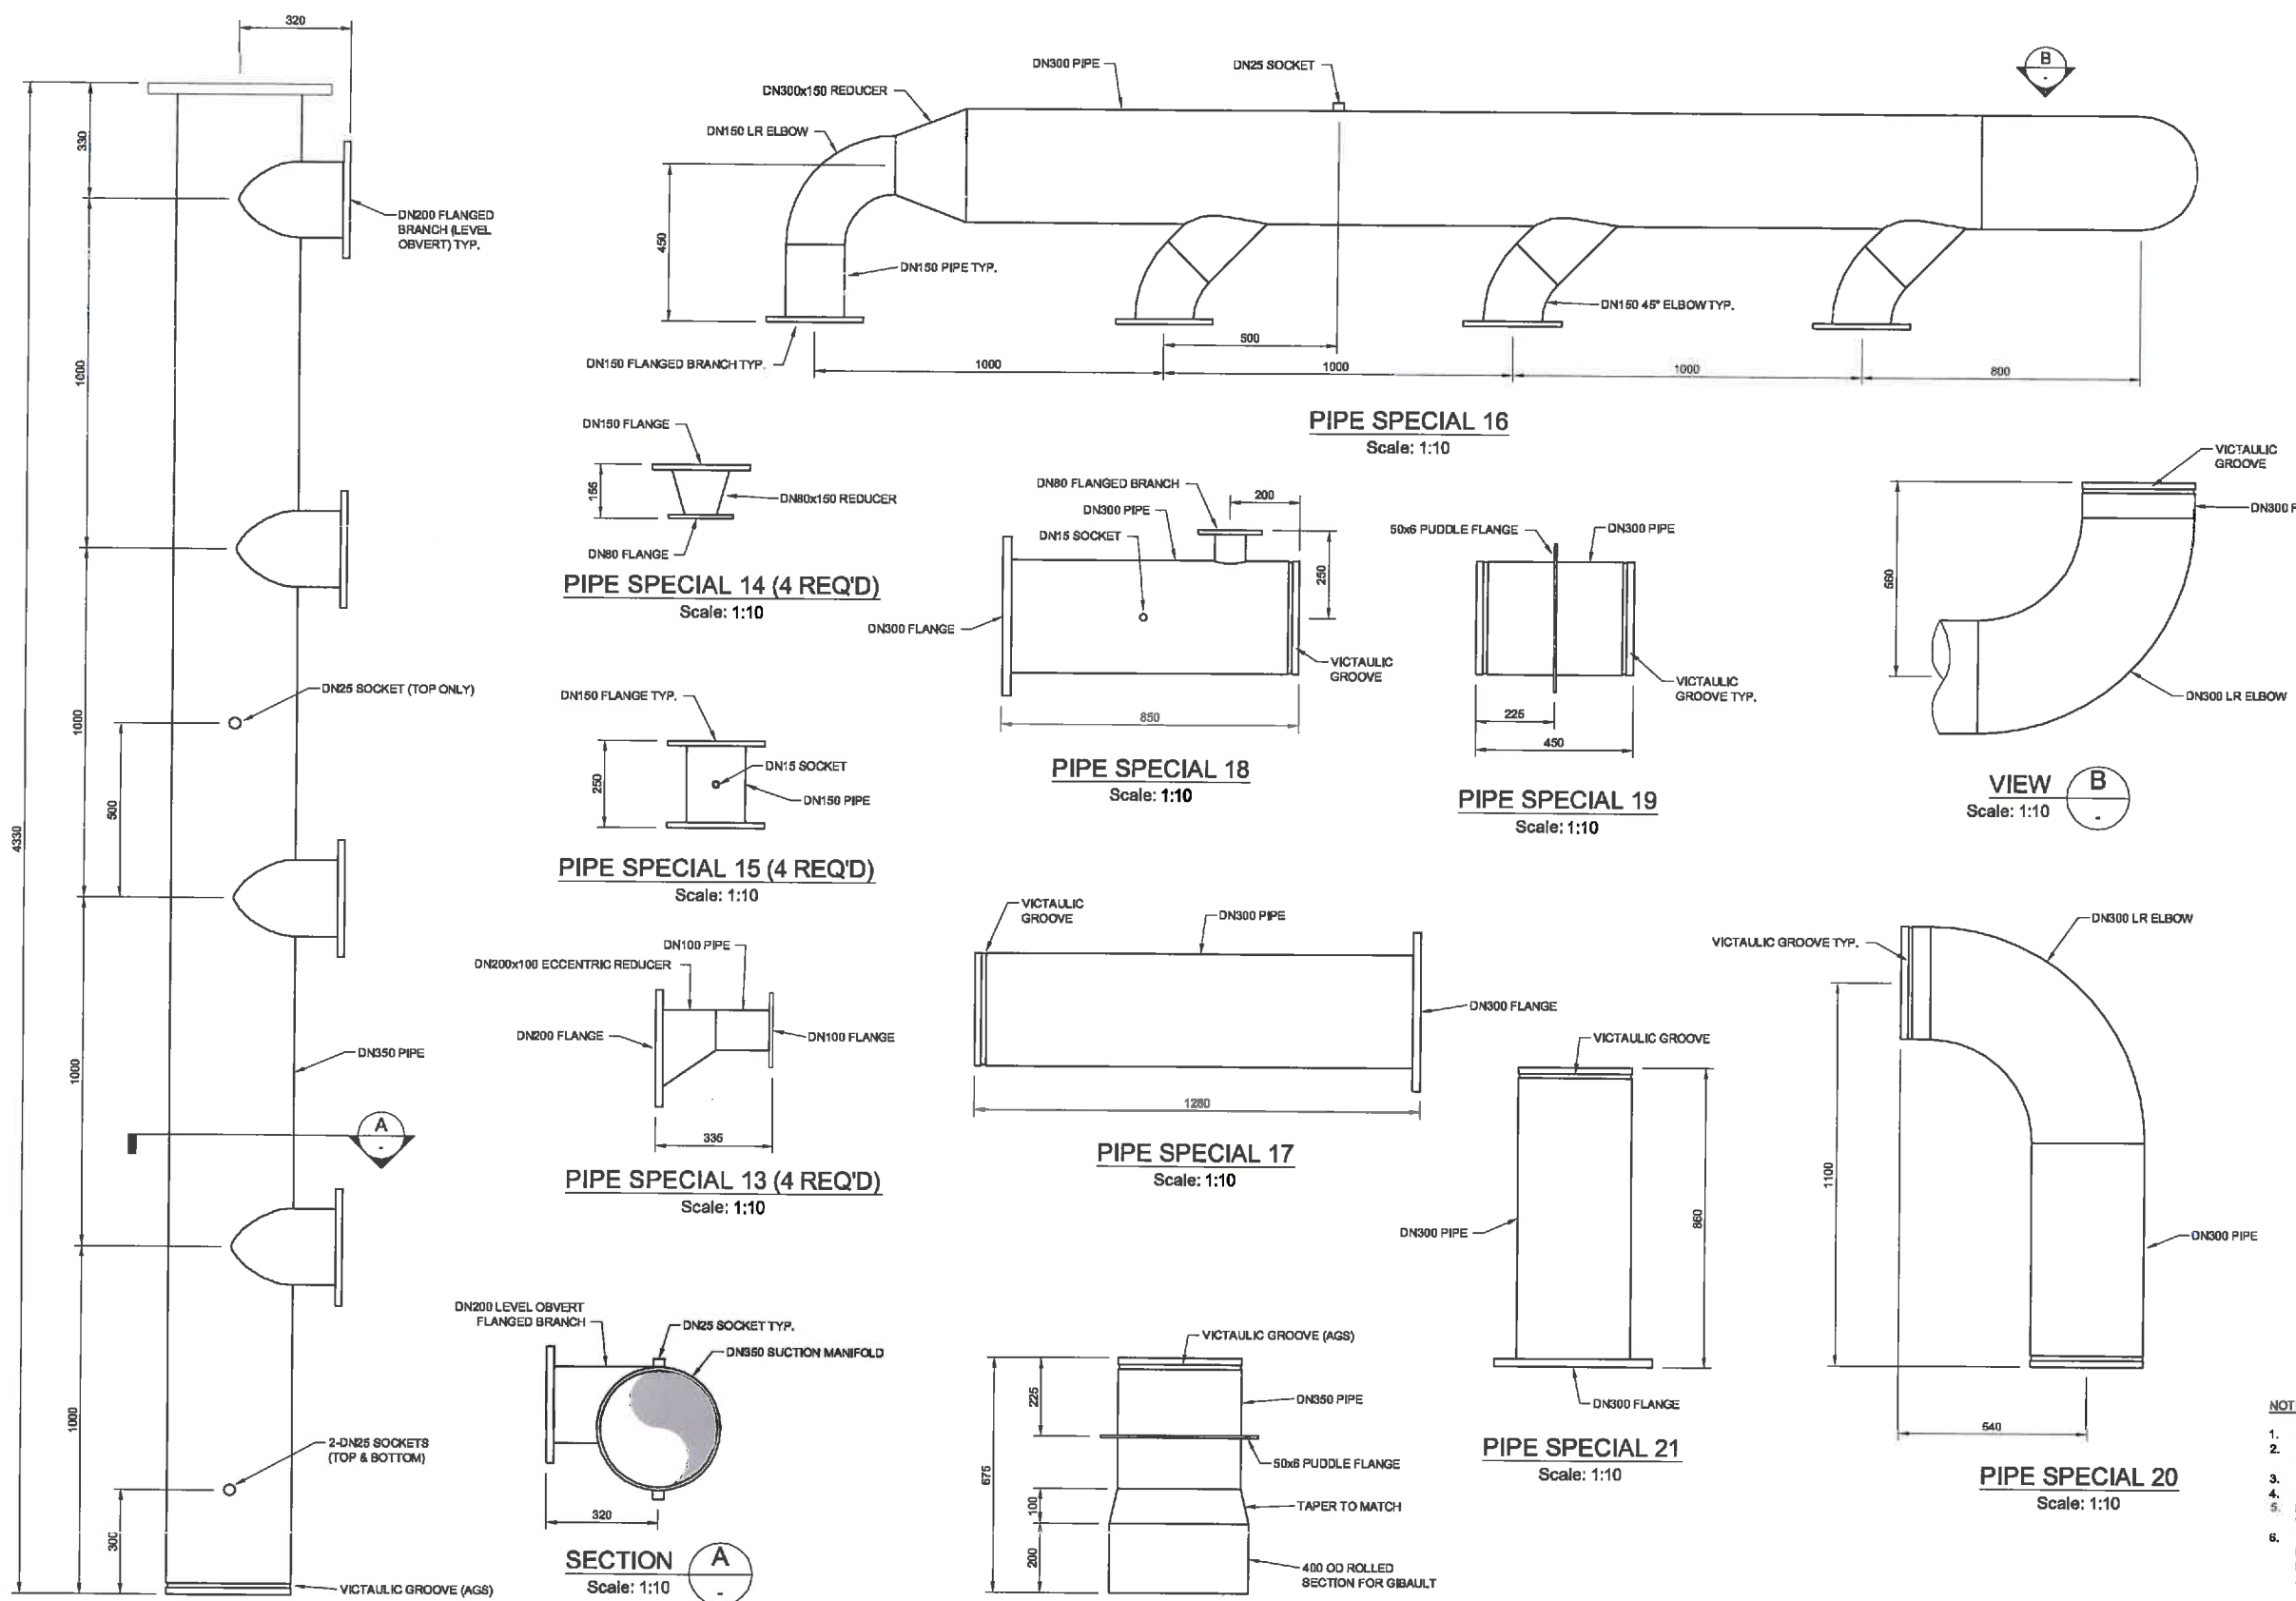

- NOTES:
1. ALL QUANTITIES 1 UNLESS OTHERWISE STATED
 2. ALL PIPE TO BE SCH10S 304 STAINLESS STEEL TO ASTM A312 UNLESS OTHERWISE STATED
 3. ALL FLANGES TO AS4087 MINIMUM RATING PN16
 4. ALL FLANGES TO BE SEAL WELDED
 5. MINIMUM WELD ROOT THICKNESS 4mm OR PIPE WALL THICKNESS
 6. BS WELDS TO BE MADE WITH PIPES PURGED AND FILLED WITH INERT GAS, AND IMMEDIATELY REPASSIVATED AND POLISHED (REFER SPECIFICATION)

PIPE SPECIAL 12
Scale: 1:10

AS BUILT

CERTIFIED BY *[Signature]*

DESIGNATION *Enric White Consultant*

DATE *21.7.2014*

Revision	Amendment	Approval	Revision Date
RAB	CERTIFIED AS RAB		05/14




OPUS

Christchurch Environmental
+64 3 383 5400


PO Box 1482
Christchurch 8140
New Zealand

Project	SELWYN DISTRICT COUNCIL DARFIELD WATER SUPPLY UPGRADE CONTRACT 1133
Sheet	PUMP STATION PIPE SPECIALS
Drawing No.	6/1515/19/7605
Sheet No.	53
Revision	RAB


300 mm
200
100
50
10 mm
0

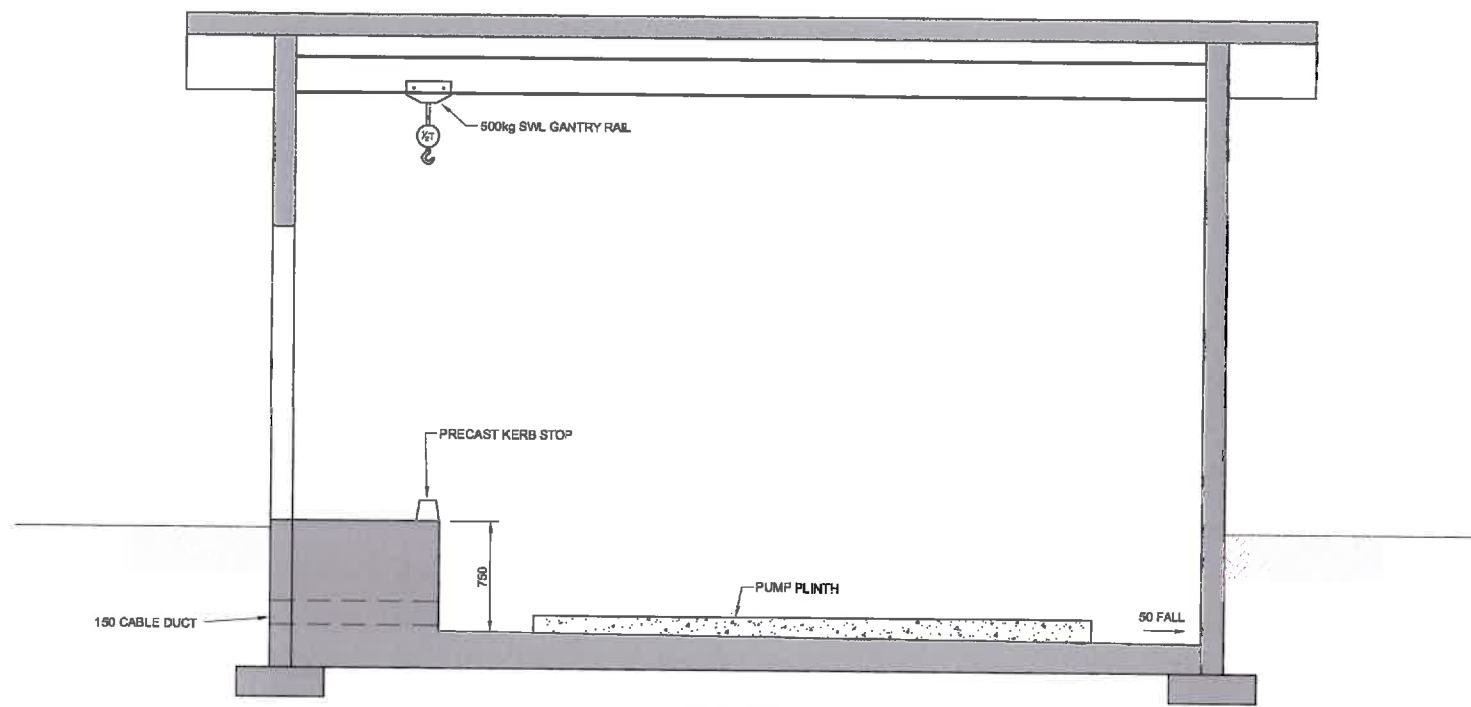

A SECTION
Scale: 1:25

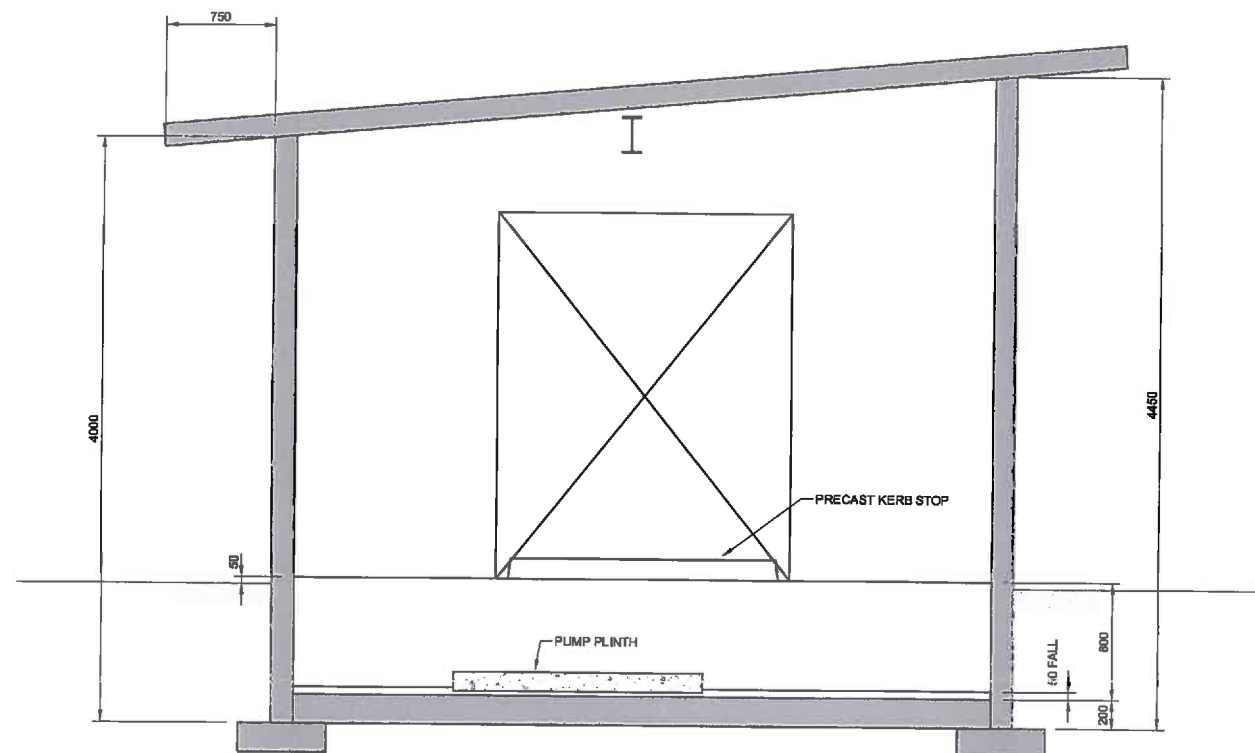

B SECTION
Scale: 1:25

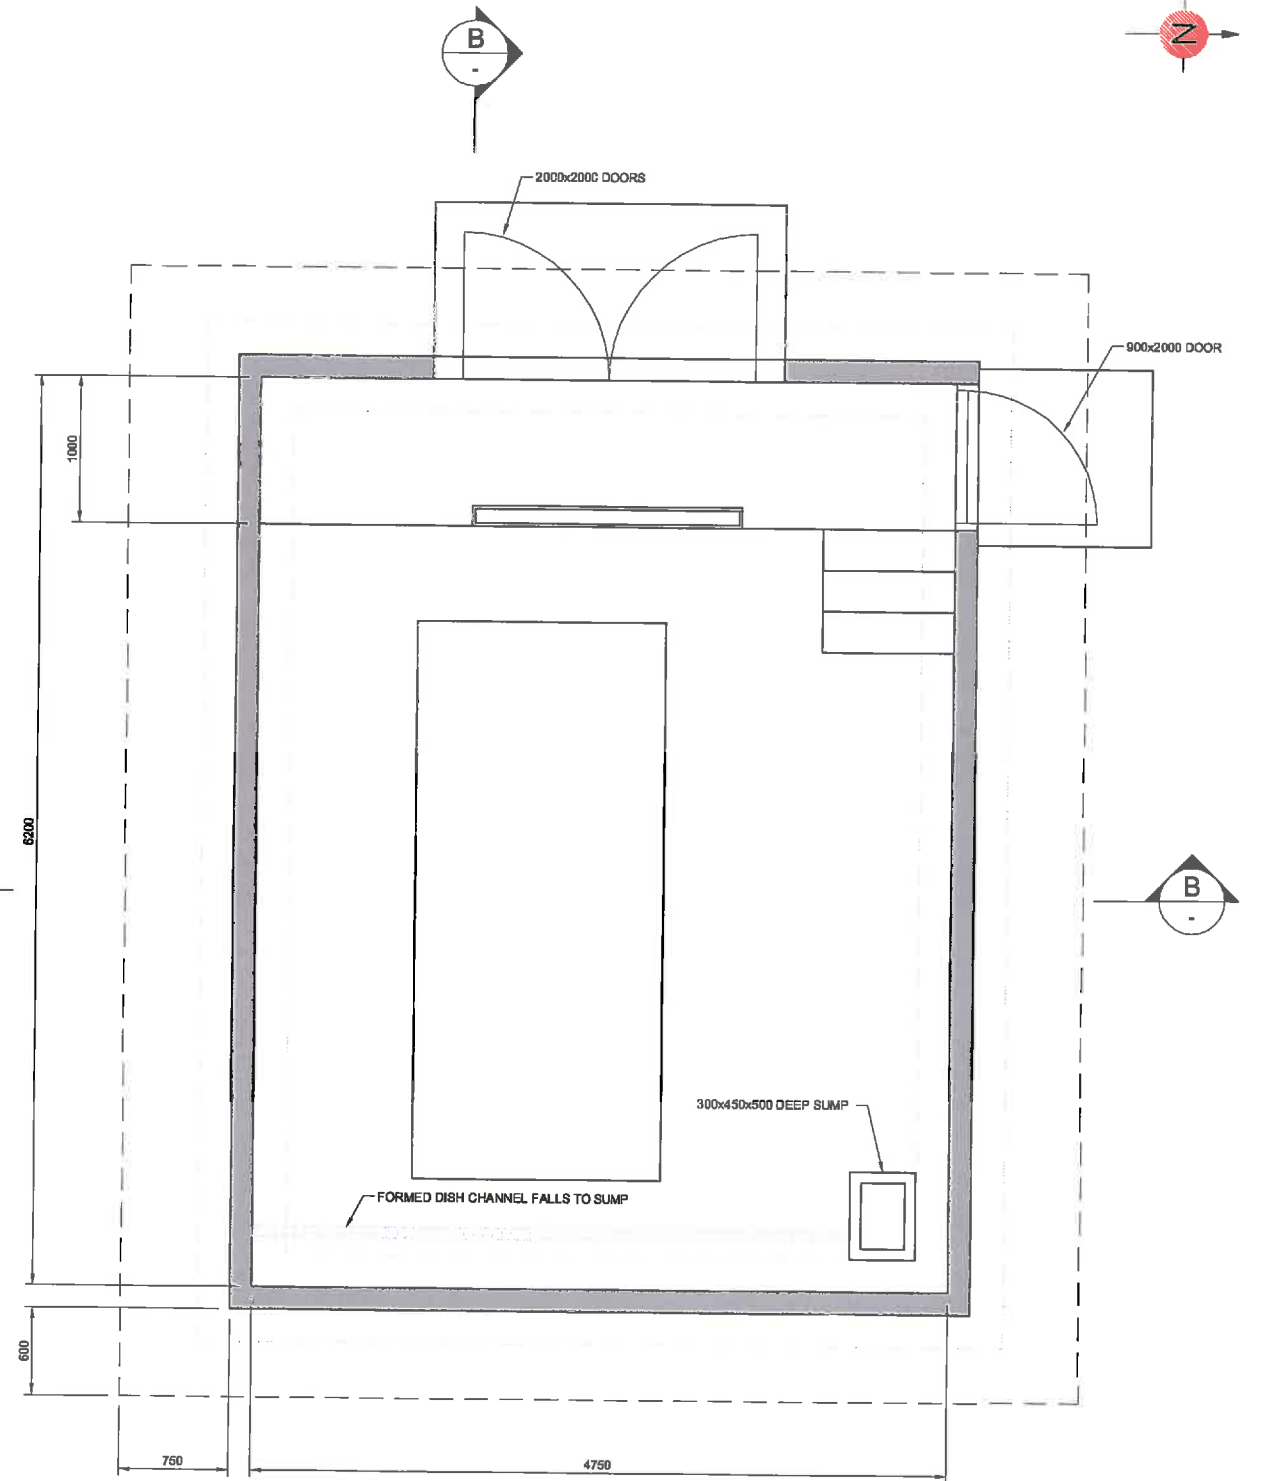

PLAN
Scale: 1:25

AS BUILT
CERTIFIED BY: *[Signature]*
DESIGNATION: *[Signature]*
DATE: 21/7/2014

Revision	Author/Drawn	Approved	Revision Date
RAB	CERTIFIED AS RAB		05/14



Christchurch Environmental
+64 3 333 5400
PO Box 1482
Christchurch 8140
New Zealand

Drawn: GB
Designed: GB
Approved: MAY 2014

Project No: 3C1004.51
Scale: AS SHOWN (A1)


Project: SELWYN DISTRICT COUNCIL
DARFIELD WATER SUPPLY UPGRADE
CONTRACT 1133

Sheet: PUMPHOUSE
INDICATIVE LAYOUT


Drawing No: 6/1515/19/7605

AS BUILT


300 mm
200
100
50
10 mm
0

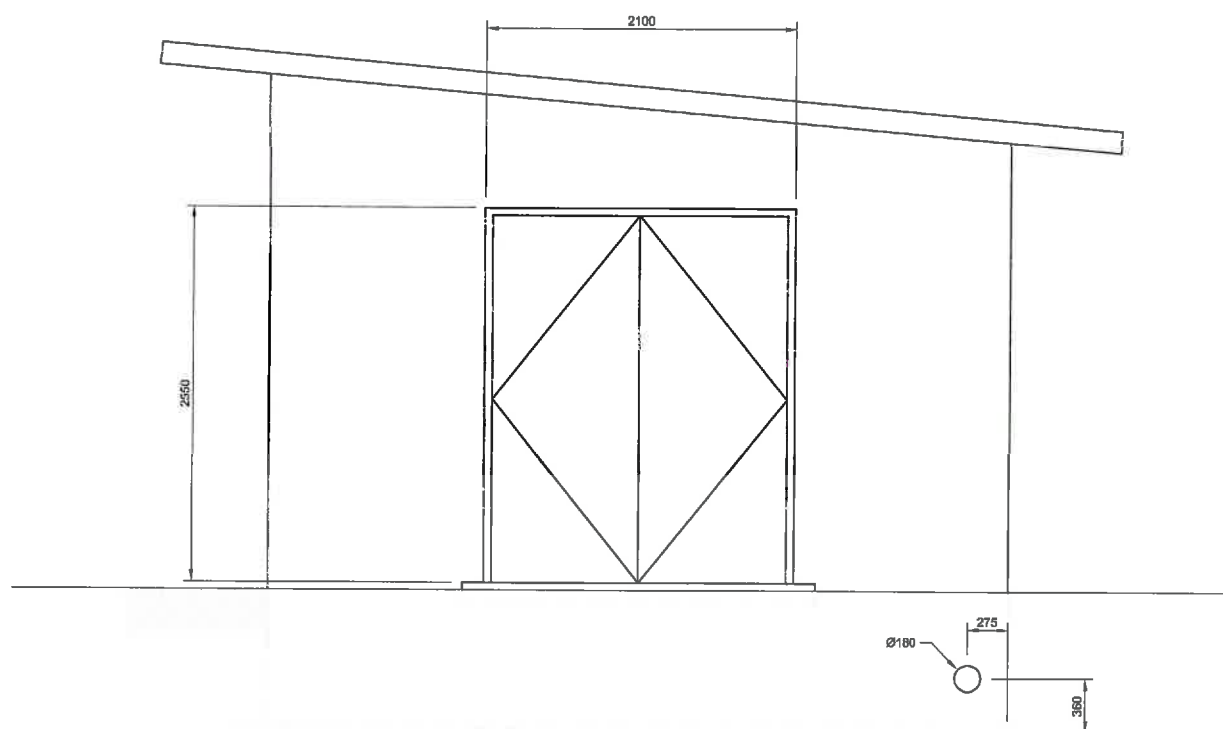


WEST ELEVATION
Scale: 1:25

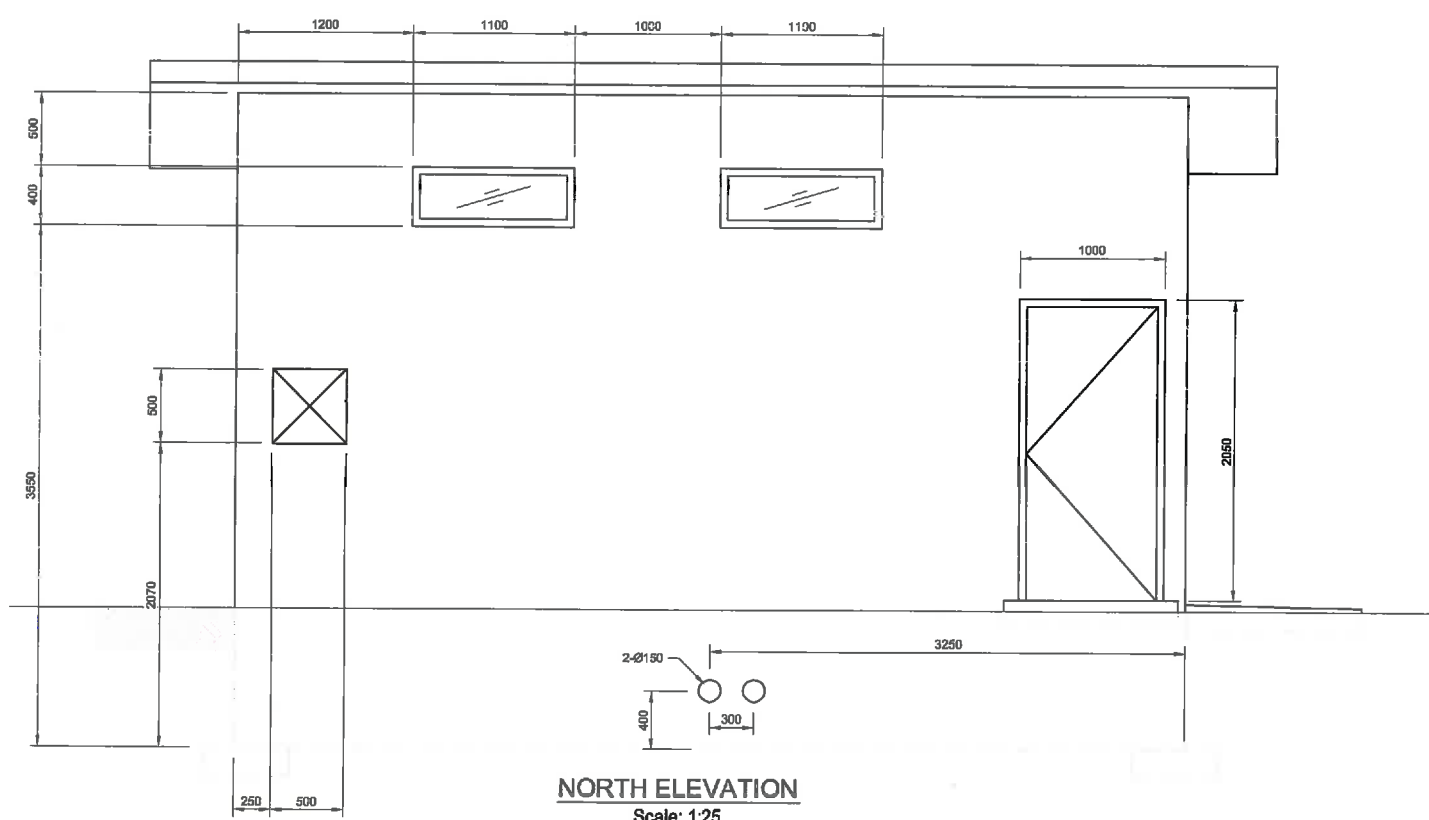

NORTH ELEVATION
Scale: 1:25

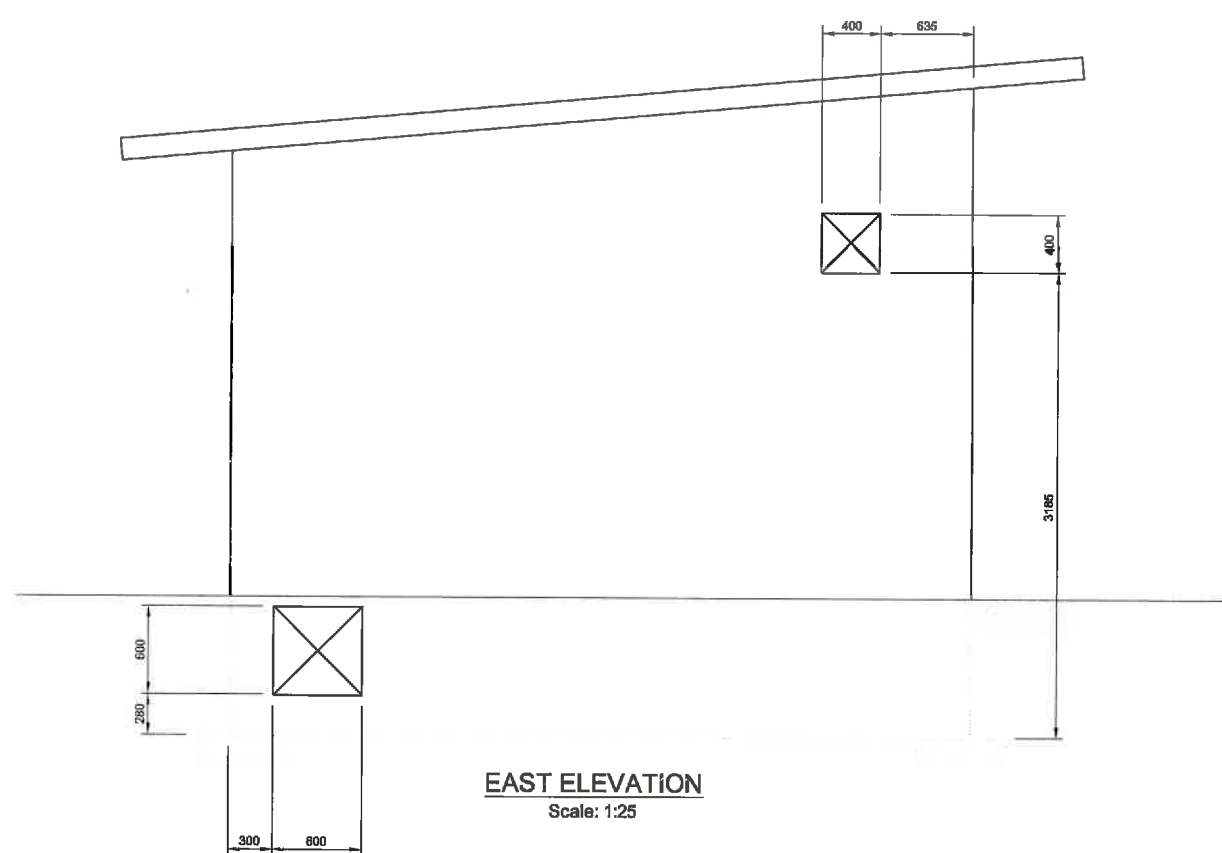

EAST ELEVATION
Scale: 1:25

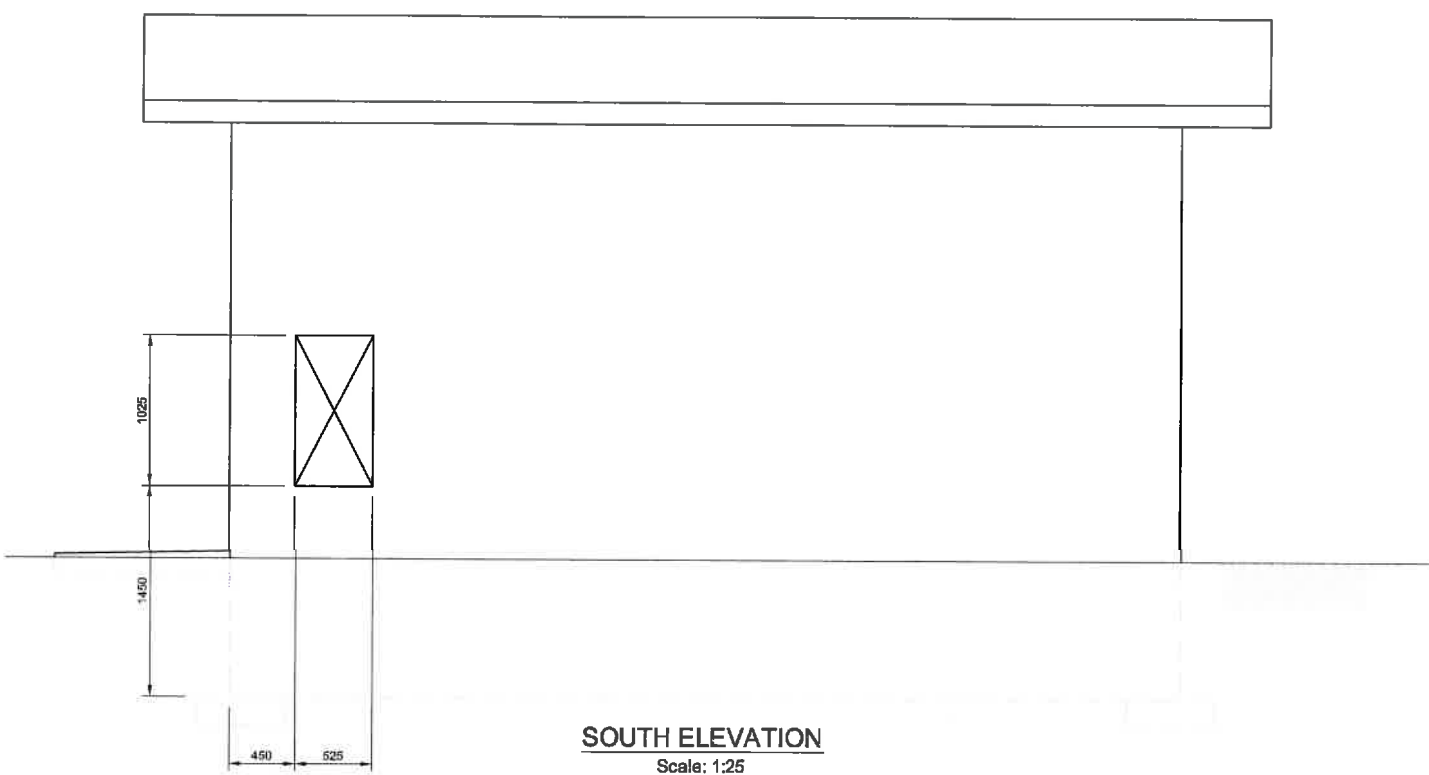

SOUTH ELEVATION
Scale: 1:25


AS BUILT
CERTIFIED BY *[Signature]*
DESIGNATION *Senior Citrus Consultant*
DATE *21/7/2014*

Revision	Description	Approved	Revision Date
RAB	CERTIFIED AS RAB		09/14




Drawn	Original	Approved	Review Date
GB	GB		MAY 2014
Project No.	Scale		
3C1004.51	AS SHOWN (A1)		

Project	Sheet No.	Revision
SELWYN DISTRICT COUNCIL DARFIELD WATER SUPPLY UPGRADE CONTRACT 1133	102	RAB
Sheet		
PUMPHOUSE INDICATIVE LAYOUT		
Drawing No.		
6/1515/19/7605		

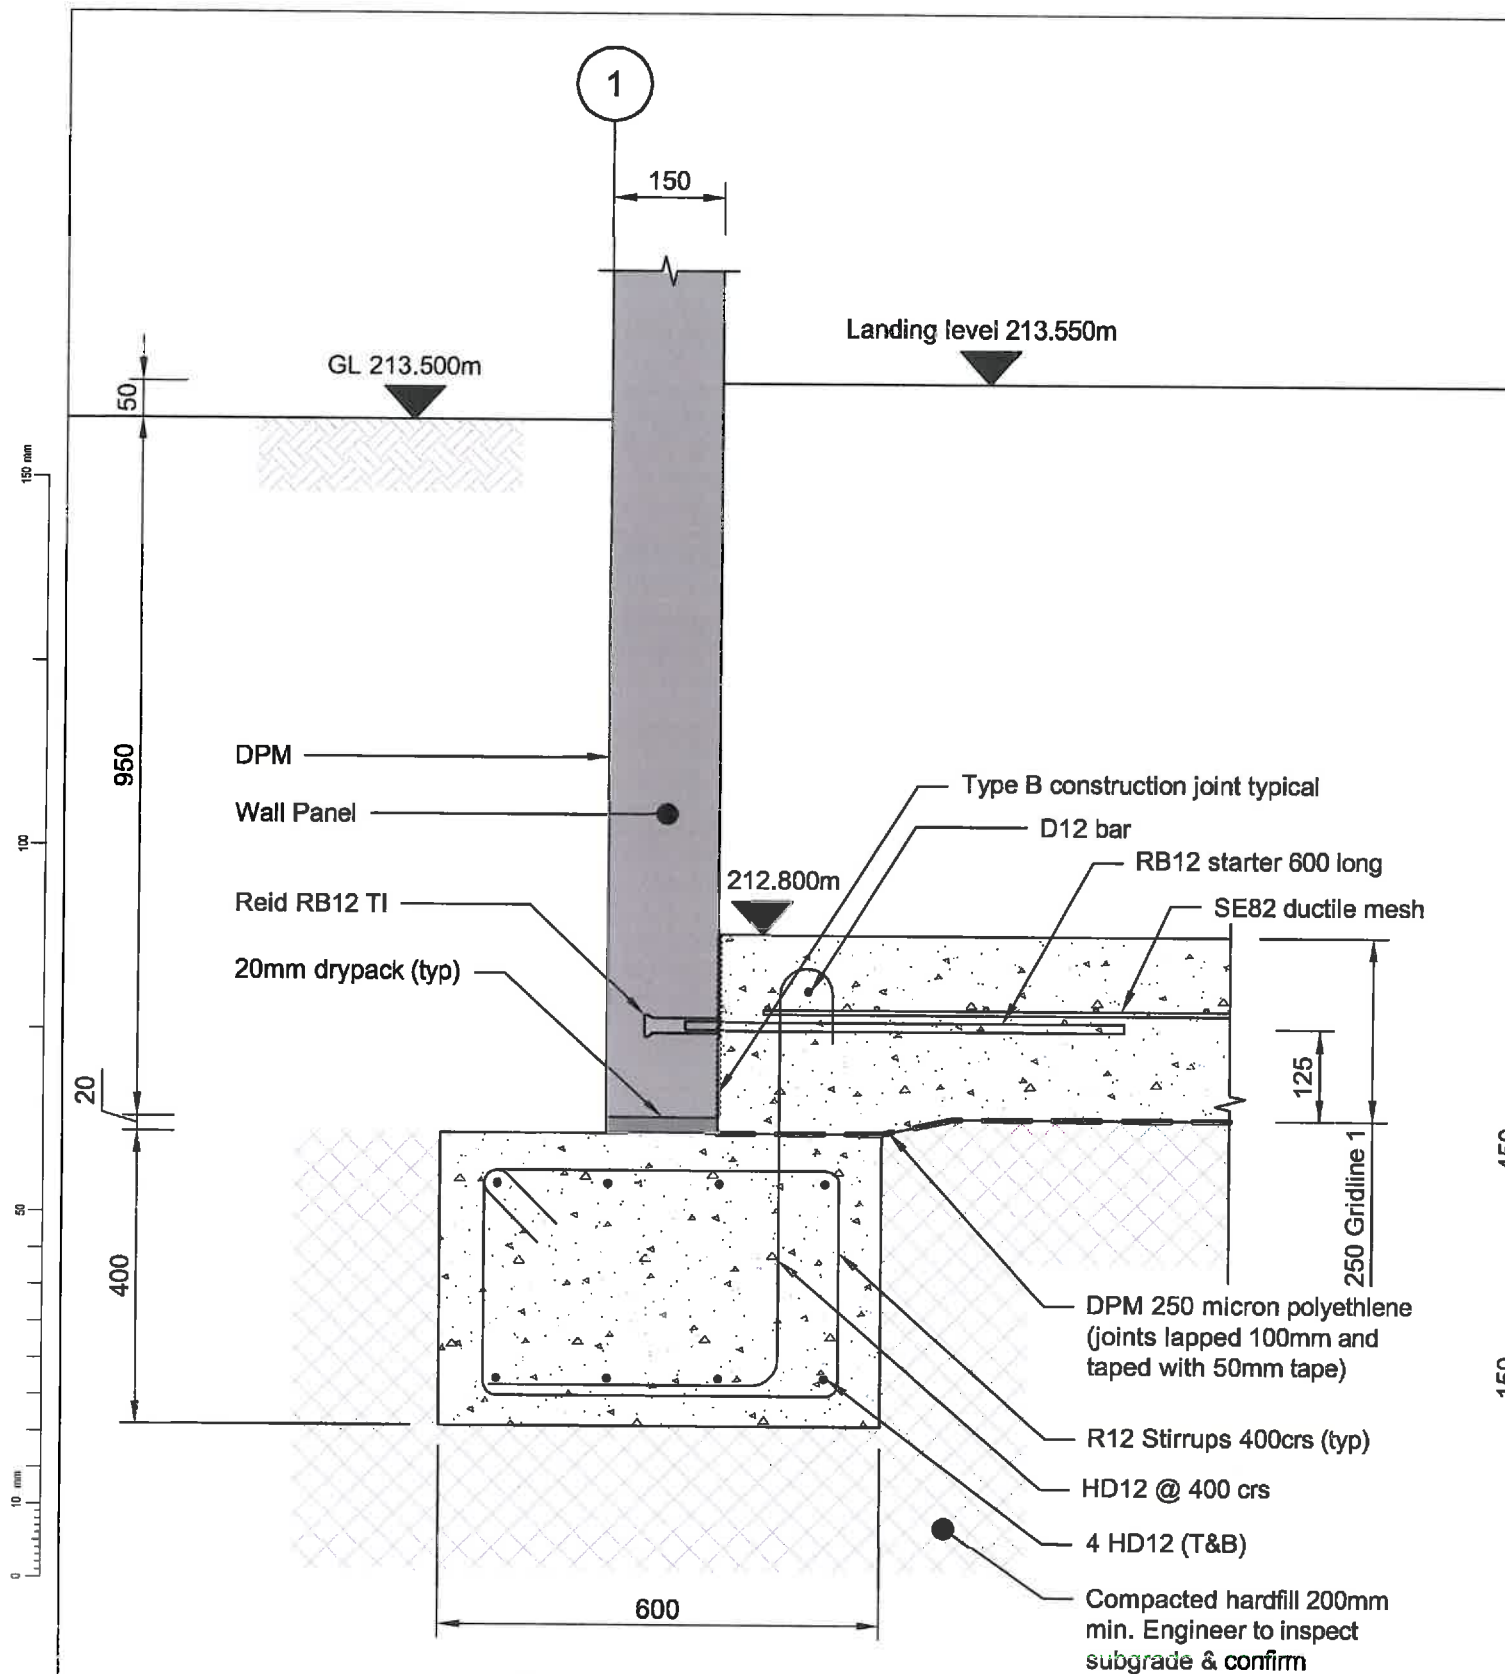

1
102
Section
Scale: 1:10

AS BUILT
 CERTIFIED BY: *[Signature]*
 DESIGNATION: *Senior Engineer (AS BUILT)*
 DATE: *21/12/2014*

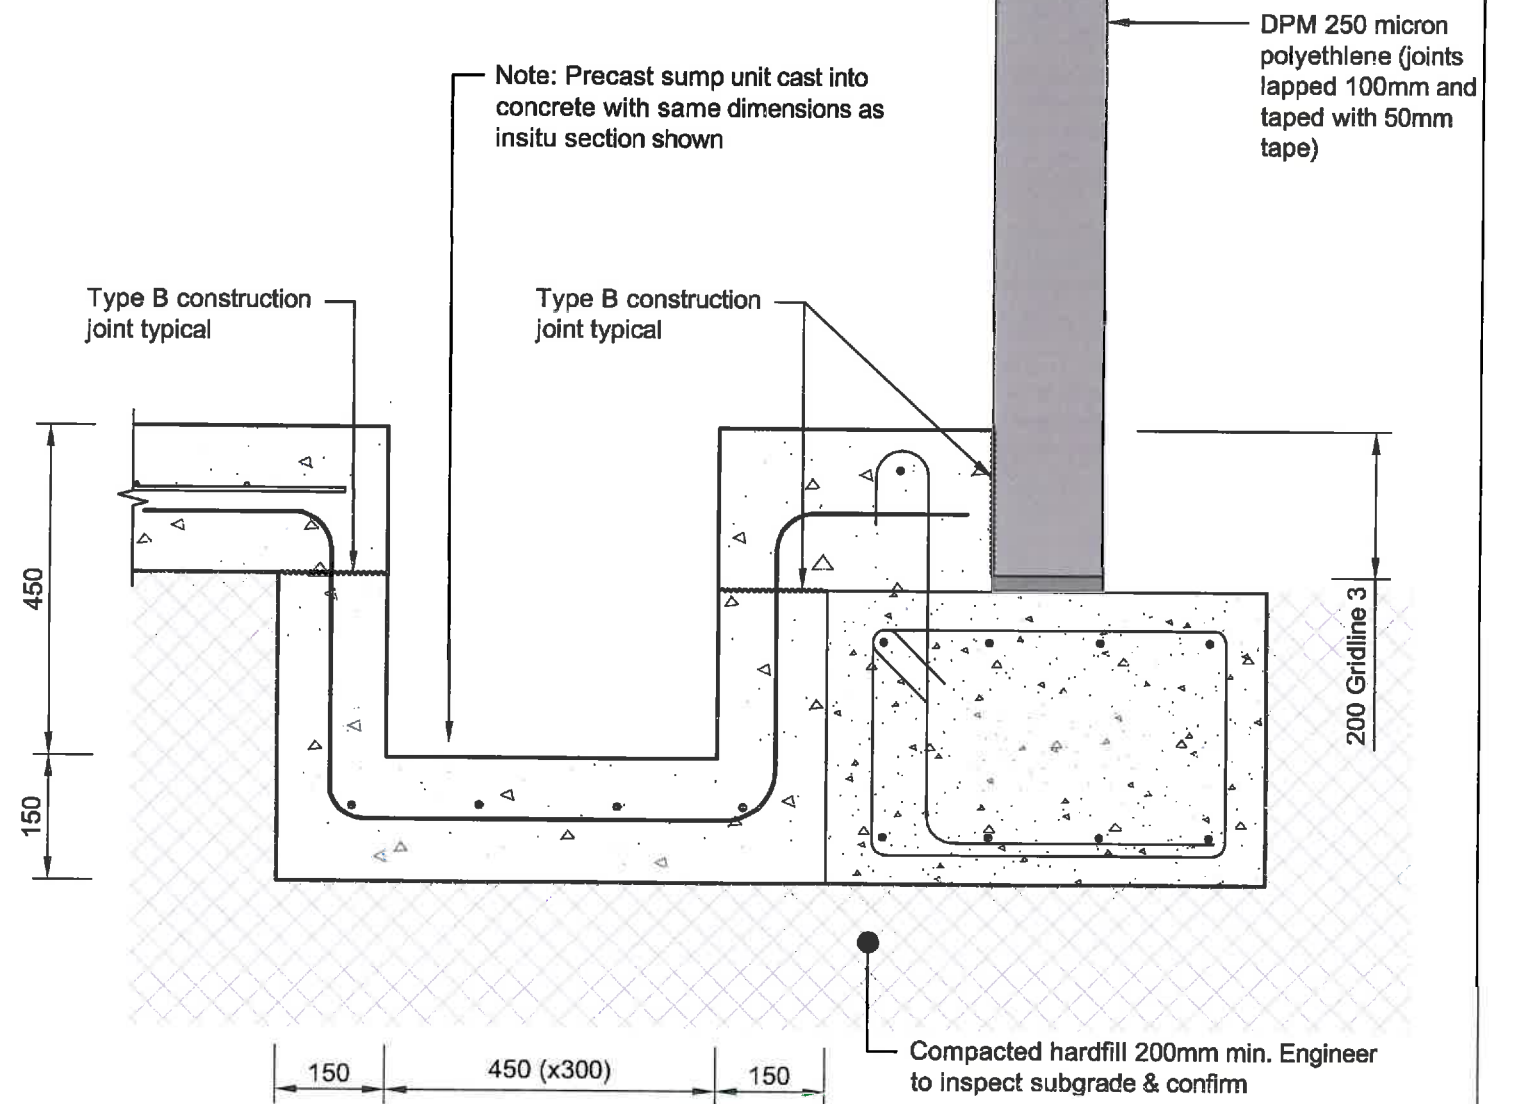

2
102
Section
Scale: 1:10

AS BUILT

Revision	Amendment	Approved	Revision Date
RAB	CERTIFIED AS RAB	GB	08/14



OPUS
 Christchurch Office
 +64 3 363 5400

PO Box 1482
 Christchurch 8140
 New Zealand

Drawn: DMF
 Design: MTM
 Approved: M. T. Mitchell
 Revision Date: 24/09/2013

Project No: 3C1004.51
 Scale: As Shown @ A3


Project: Selwyn District Council
 Darfield Water Supply
 SH73 Headworks
 Sheet: Pumphouse
 Foundation Sections

Drawn No: 6/1515/19/7602

Sheet No: 103
 Revision: RAB

1:10
 @ A3
 0 100 200 300 400 mm

150 mm
100
50
10 mm
0

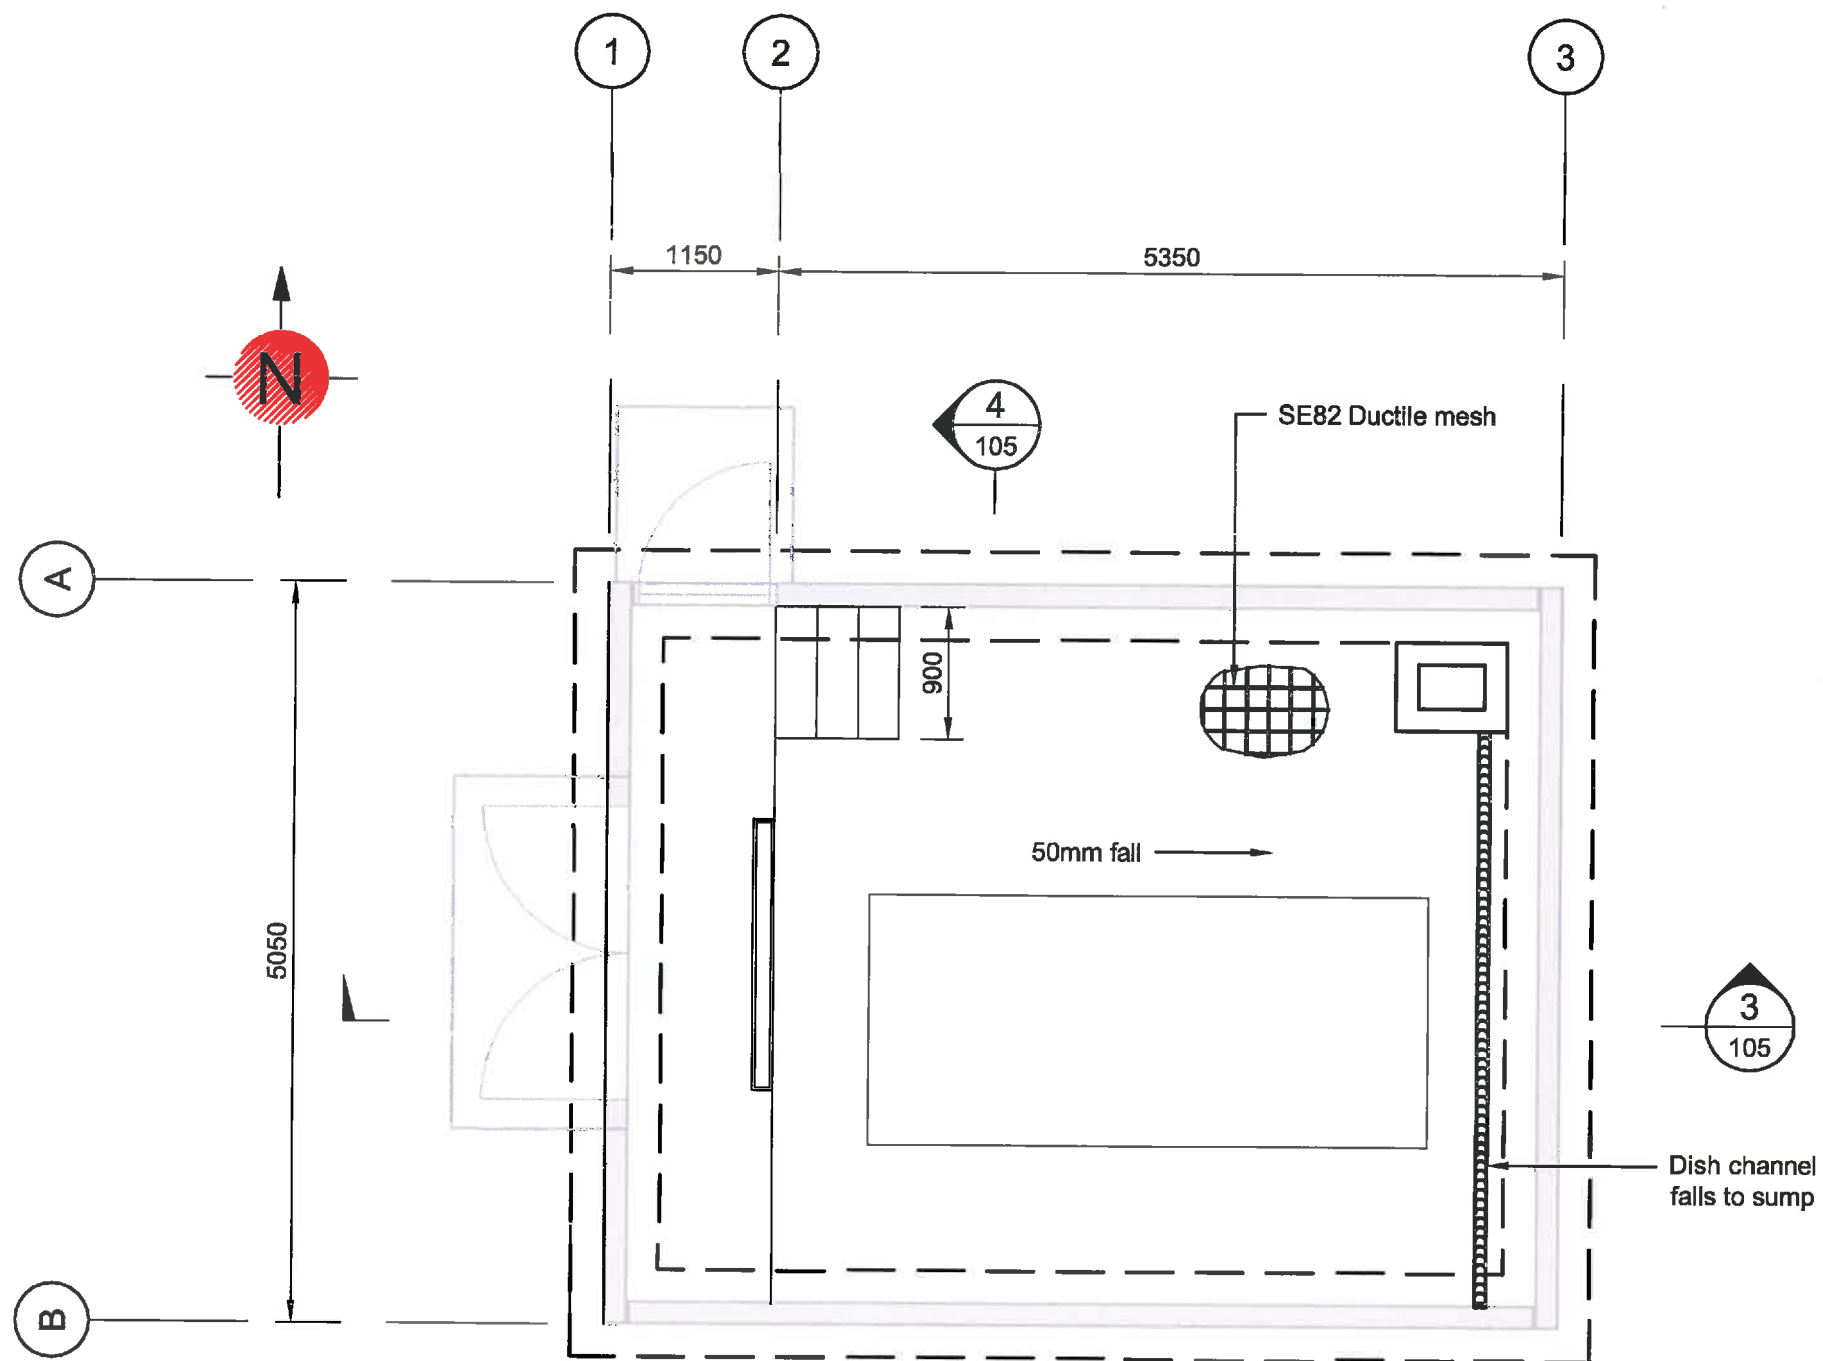

Floor Slab Plan

Scale: 1:50

AS BUILT
CERTIFIED BY *[Signature]*
DESIGNATION *[Signature]*
DATE *2/7/2014*

AS BUILT


Revision	Description	Approved	Revision Date
RAB	CERTIFIED AS RAB	GB	06/14




Drawn	Designed	Approved	Revision Date
DMF	MTM	M. T. Mitchell	24/08/2013
Project No.	Sheet	As Shown @ A3	6/1515/19/7602
3C1004.51			

Project	Sheet
Selwyn District Council Darfield Water Supply SH73 Headworks	Pumphouse Floor Slab Plan
104	RAB

150 mm
100
50
10 mm
0

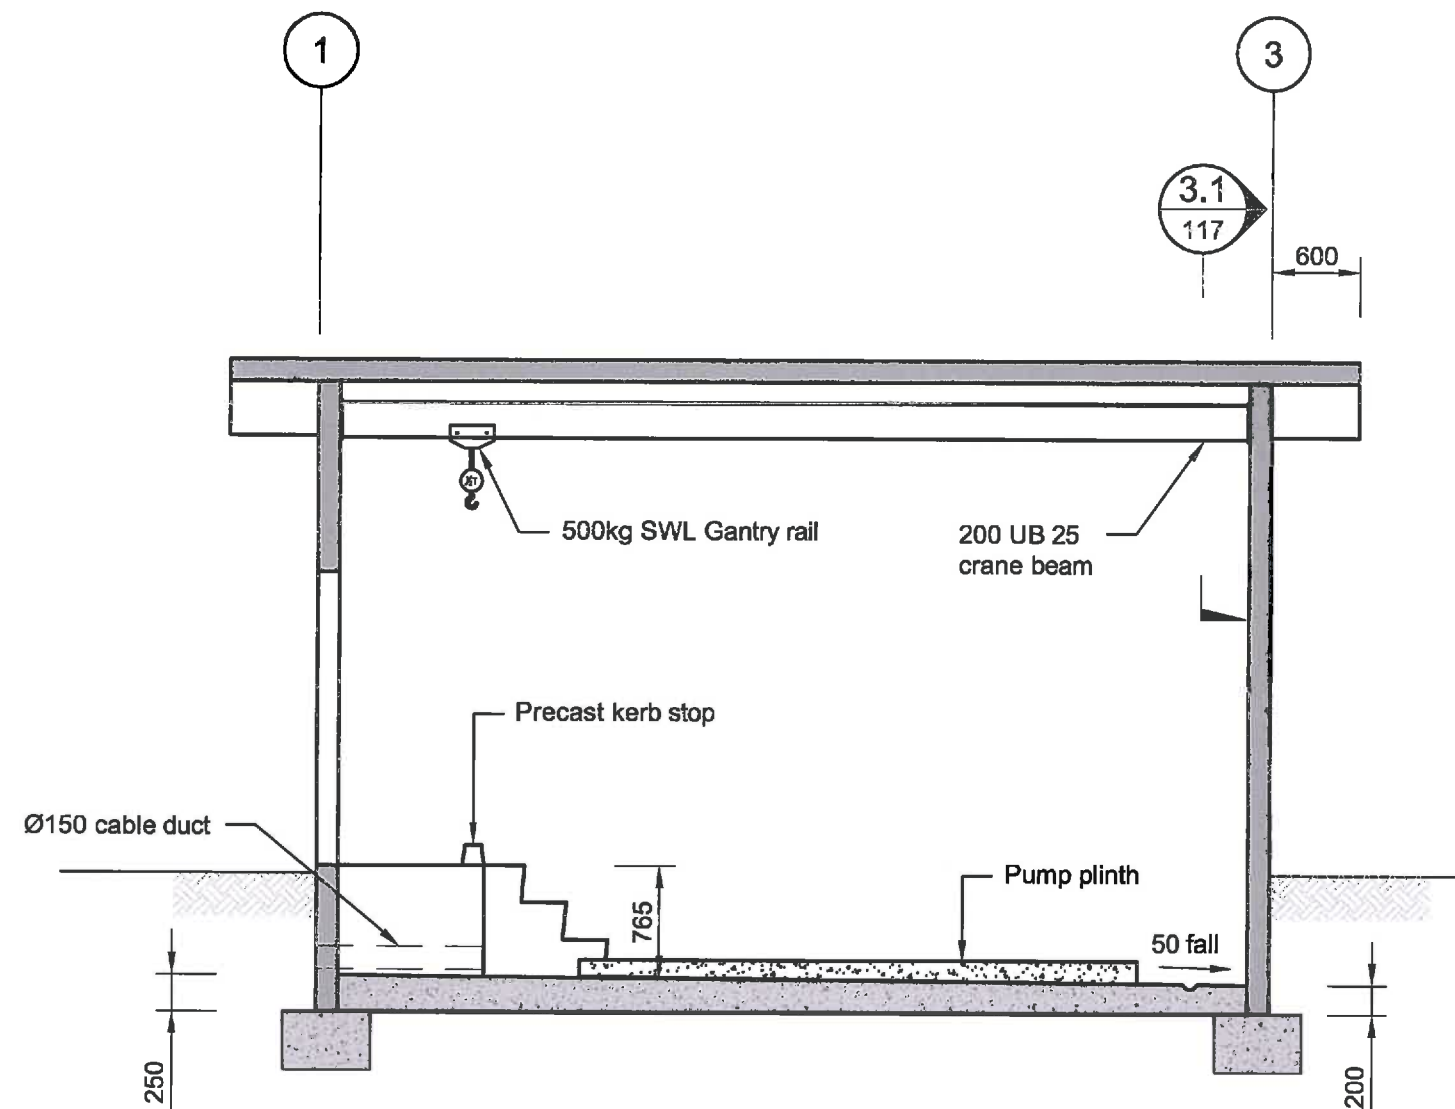

3 Long Section
104 Scale: 1:50

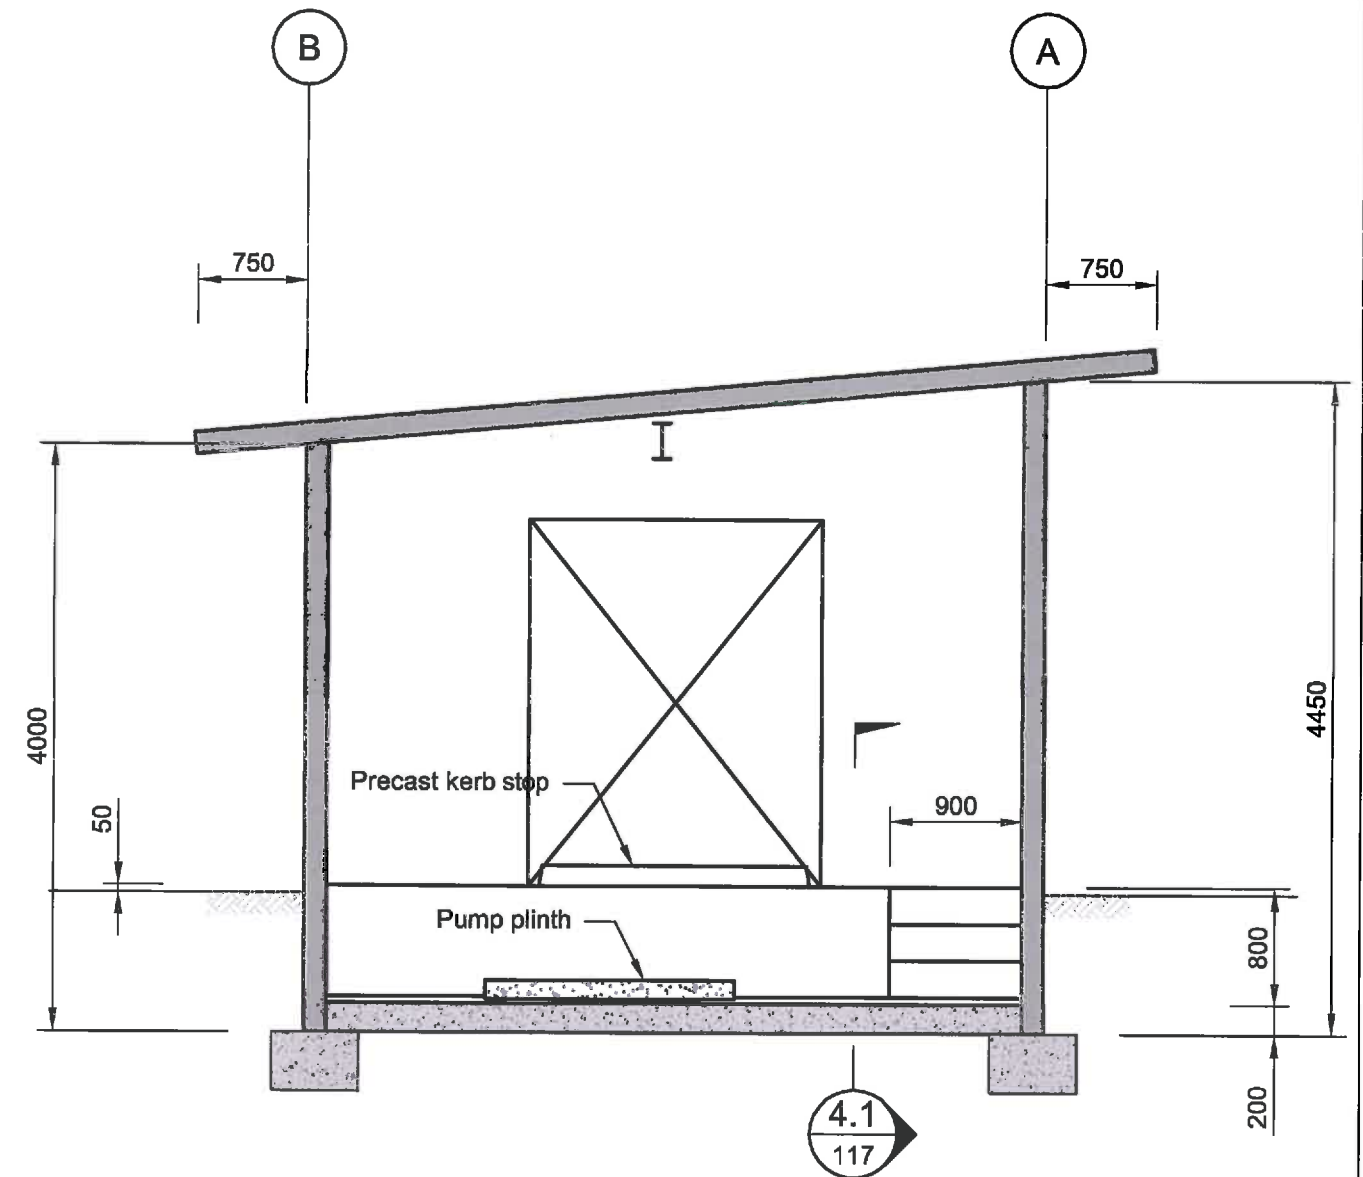

4 Cross Section
104 Scale: 1:50

AS BUILT
CERTIFIED BY: *[Signature]*
DESIGNATION: *Senior Civils Consultant*
DATE: *2.12.2014*

1:50
@ A3
0 1 m

Revision	Amendment	Approved	Revision Date
RAB	CERTIFIED AS RAB	GB	08/14




OPUS
Christchurch Office
+64 3 363 5400
PO Box 1482
Christchurch 8140
New Zealand

Drawn: DMF
Checked: MTM
Approved: M. T. Mitchell
Revision Date: 24/09/2013

Project No: 3C1004.51
Scale: As Shown @ A3

Project	Selwyn District Council Darfield Water Supply SH73 Headworks
Sheet	Pumphouse Building Sections
Drawing No.	6/1515/19/7602
Sheet No.	105
Rev. Date	RAB

150 mm
100
50
10 mm
0

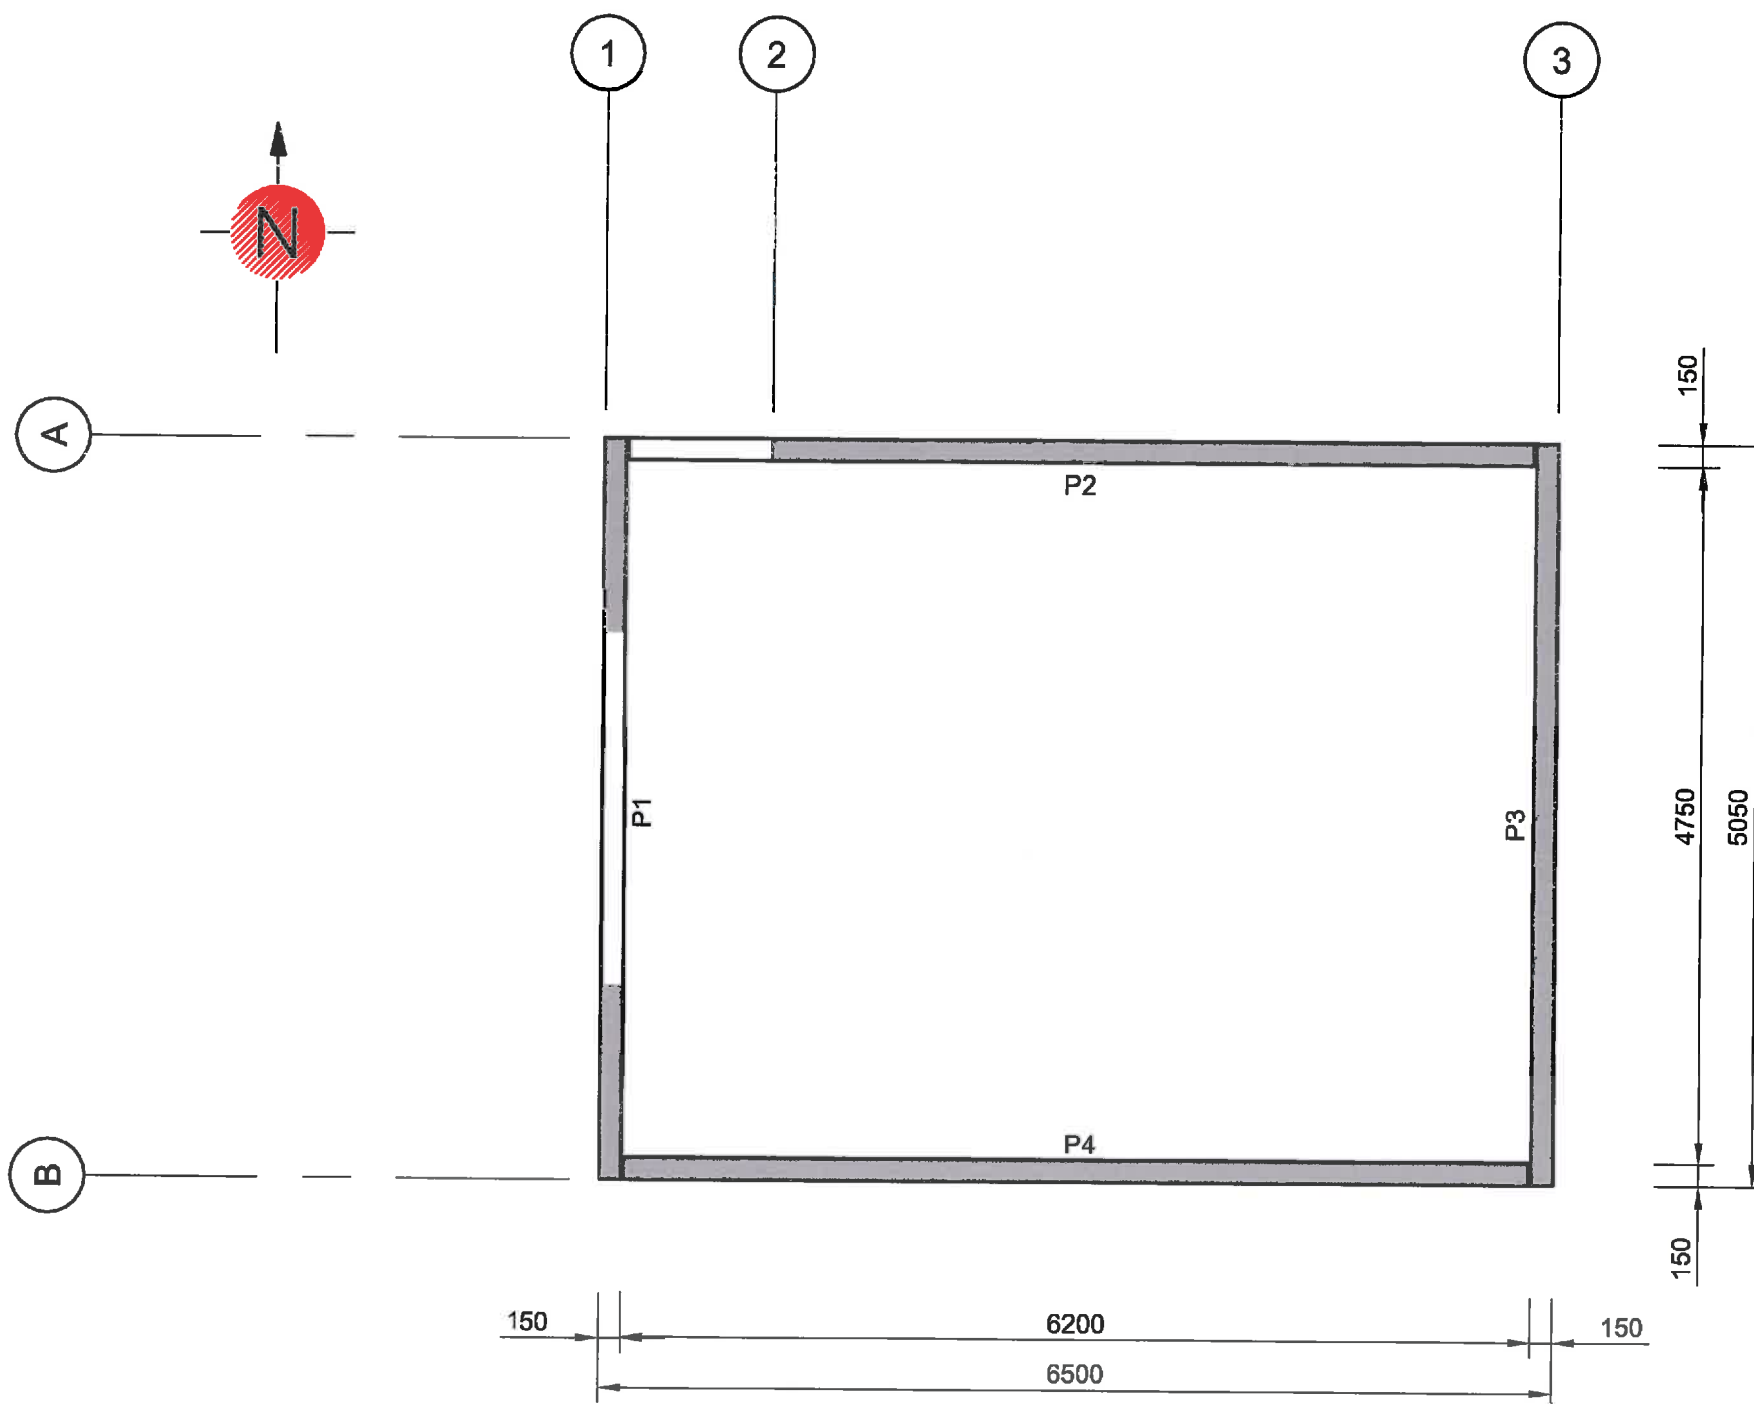

Panel Layout Plan
Scale: 1:50

AS BUILT
CERTIFIED BY: *[Signature]*
DESIGNATION: *Senior Civil Engineer*
DATE: *2-17-2014*

1:50
@ A3
0 1 m

Revision	Amendment	Approved	Revision Date
RAB	CERTIFIED AS RAB	GB	09/14




PO Box 1482
Christchurch 8140
New Zealand

Drawn	Designed	Approved	Revision Date
DMF	MTM	M. T. Mitchell	24/09/2013



Project No: 3C1004.51
Scale: As Shown @ A3

Project Selwyn District Council Darfield Water Supply SH73 Headworks		
Book Pumphouse Panel Layout Plan		
Drawing No: 6/1515/19/7602	Sheet No: 106	Revision: RAB

150 mm
100
50
10 mm
0

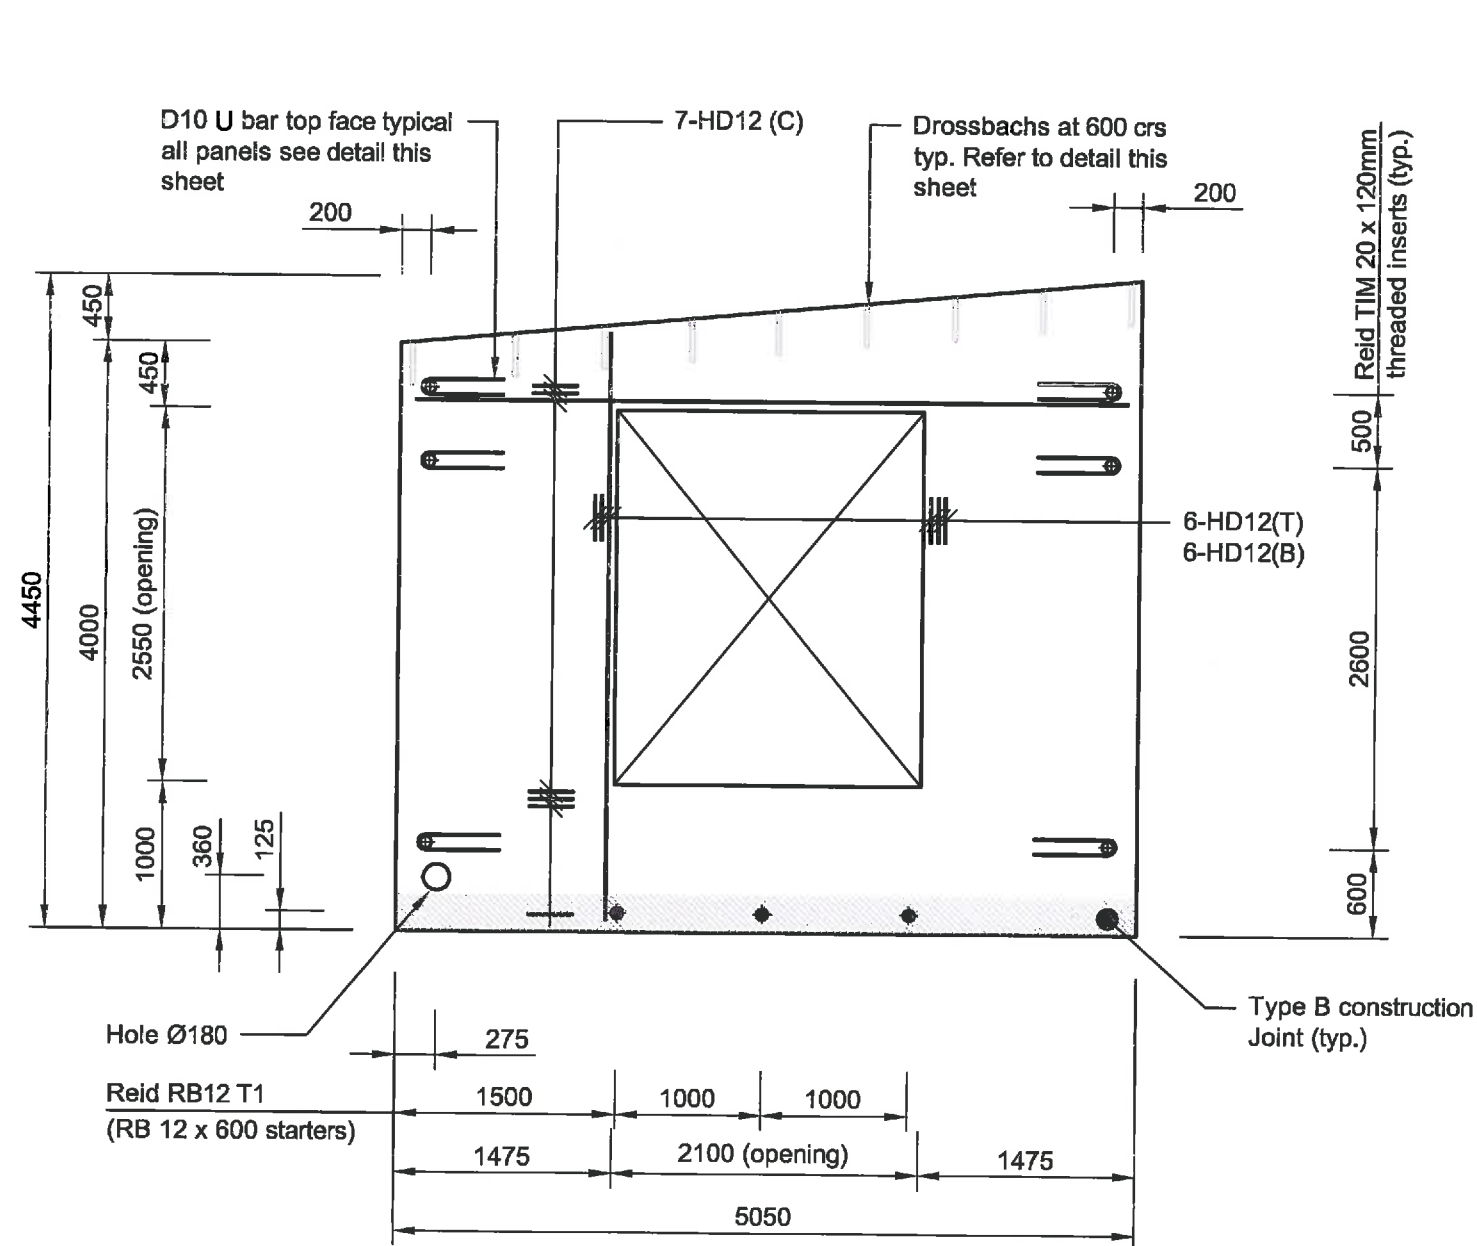

Panel P1
Scale: 1:50
Thickness: 150mm

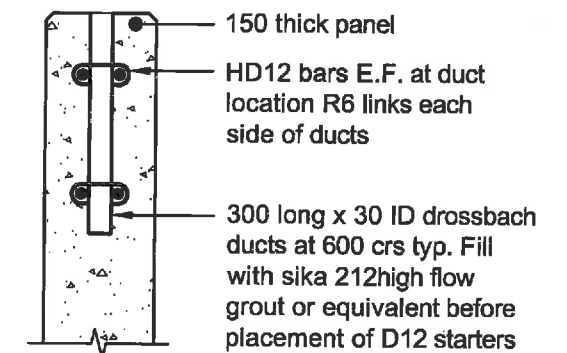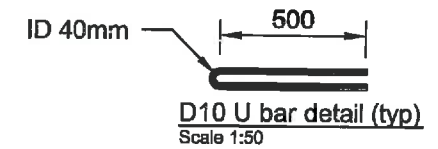

Crossbach Detail (typ.)
Scale : 1:10

Notes:

1. All panels viewed from the interior face
2. All panels HD12 @ 200 crs EW (C) with standard 90° hooks bottom and sides
3. Lifting eyes. Reid swiftlift - to be confirmed by contractor
4. Edge anchors. Reid TIM 20 x 120 Galv
5. The contractor is responsible for the design and location of the panel lifting inserts
6. The contractor is to coordinate crossbach location with flat slab roof
7. Chamfer panel edges 10x10
8. T = 40mm top cover
9. B = 50mm bottom cover
10. C = Central

AS BUILT

AS BUILT
CERTIFIED BY: *[Signature]*
DESIGNATION: *[Signature]*
DATE: 2.12.2014


Revision	Amendment	Approved	Revision Date
RAB	CERTIFIED AS/RAB	GB	08/14



Drawn	Designed	Approved	Revision Date
DMF	MTM	M. T. Mitchell	24/09/2013
Project No.	Scale		
3C1004.51	As Shown @ A3		

Project	Sheet
Selwyn District Council Darfield Water Supply SH73 Headworks	
Pumphouse Panel P1	
Drawing No.	Sheet No.
6/1515/19/7602	107
	RAB

150 mm
100
50
10 mm
0

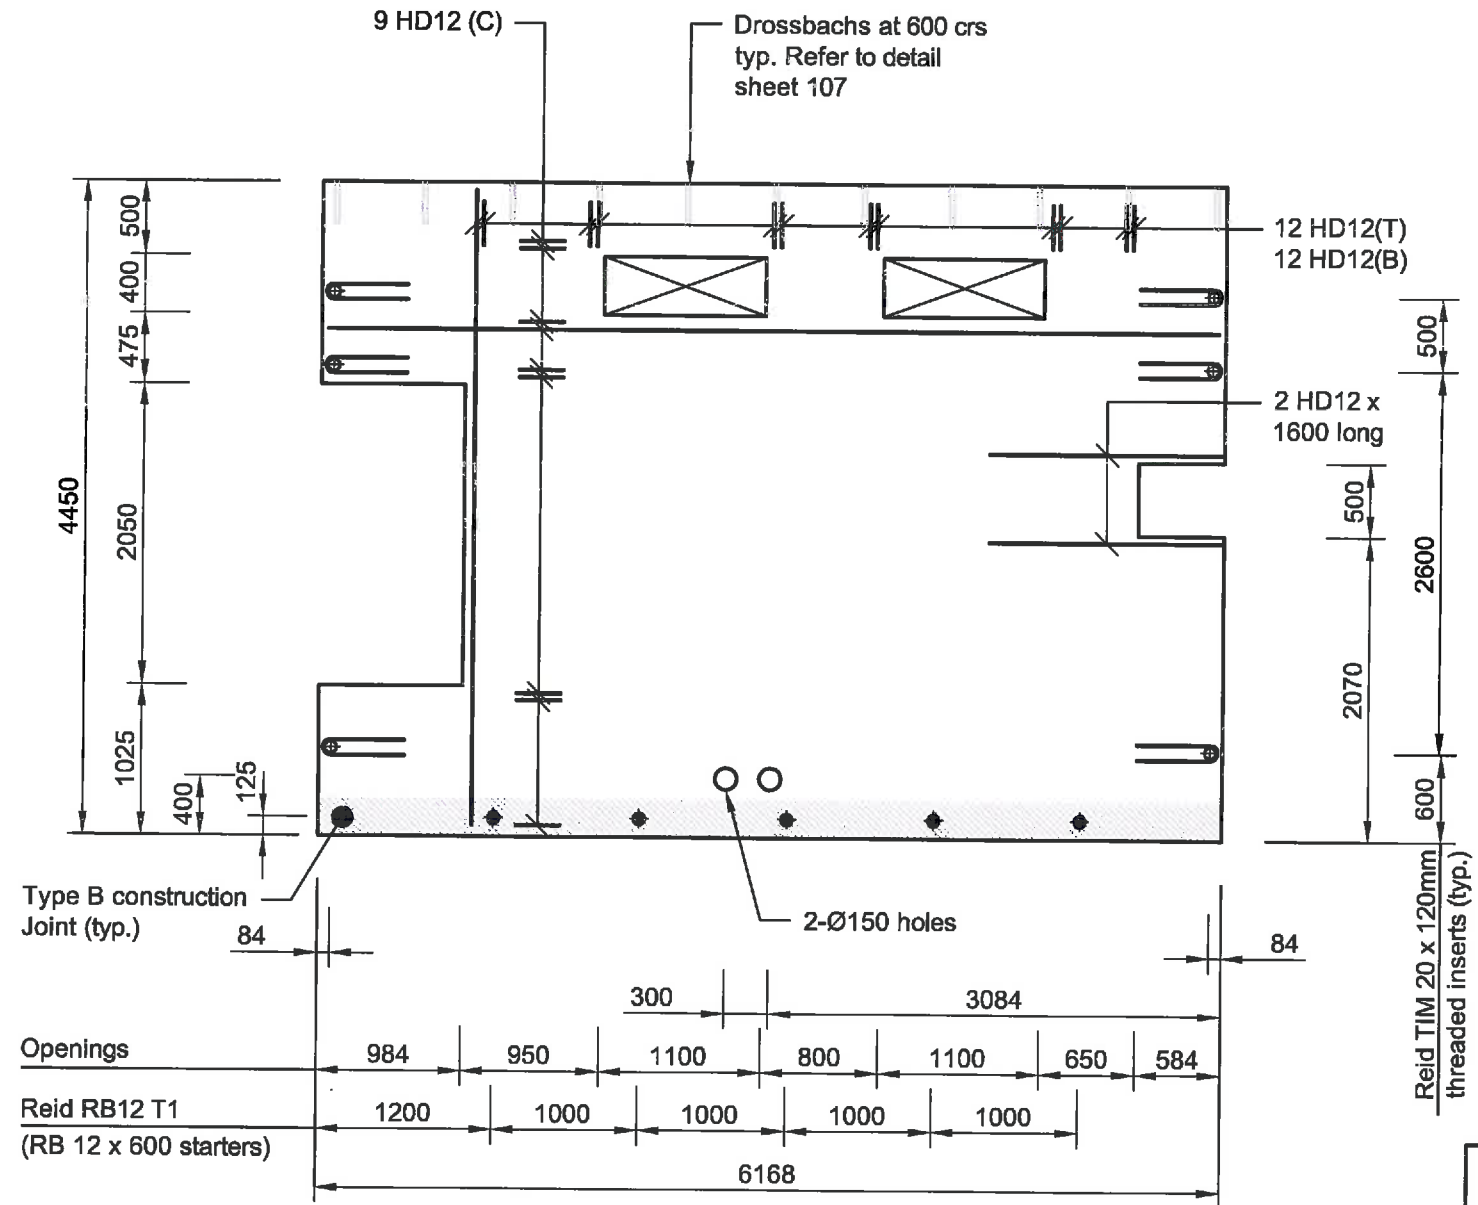

Panel P2

Scale: 1:50

Thickness: 150mm

Notes:

1. All panels viewed from the interior face
2. All panels HD12 @ 200 crs EW (C) with standard 90° hooks bottom and sides
3. Lifting eyes. Reid swiftlift - to be confirmed by contractor
4. Edge anchors. Reid TIM 20 x 120 Galv
5. The contractor is responsible for the design and location of the panel lifting inserts
6. The contractor is to coordinate drossbach location with flat slab roof
7. Chamfer panel edges 10x10
8. T = 40mm top cover
9. B = 50mm bottom cover
10. C = Central

AS BUILT

CERTIFIED BY

DESIGNATION

DATE 2/7/2014

Revision	Amendment	Approved	Revision Date
RAB	CERTIFIED AS RAB	GB	08/14



Owner	Designer	Approved	Revision Date
DMF	MTM	N. T. Mitchell	24/09/2013
Project No.	Scale		
3C1004.51	As Shown @ A3		


Project	Sheet No.	Revision
Selwyn District Council Darfield Water Supply SH73 Headworks		
Pumphouse Panel P2		
Drawing No.		
6/1515/19/7602		

AS BUILT

108 RAB

1:50
@ A3

150 mm
100
50
10 mm
0

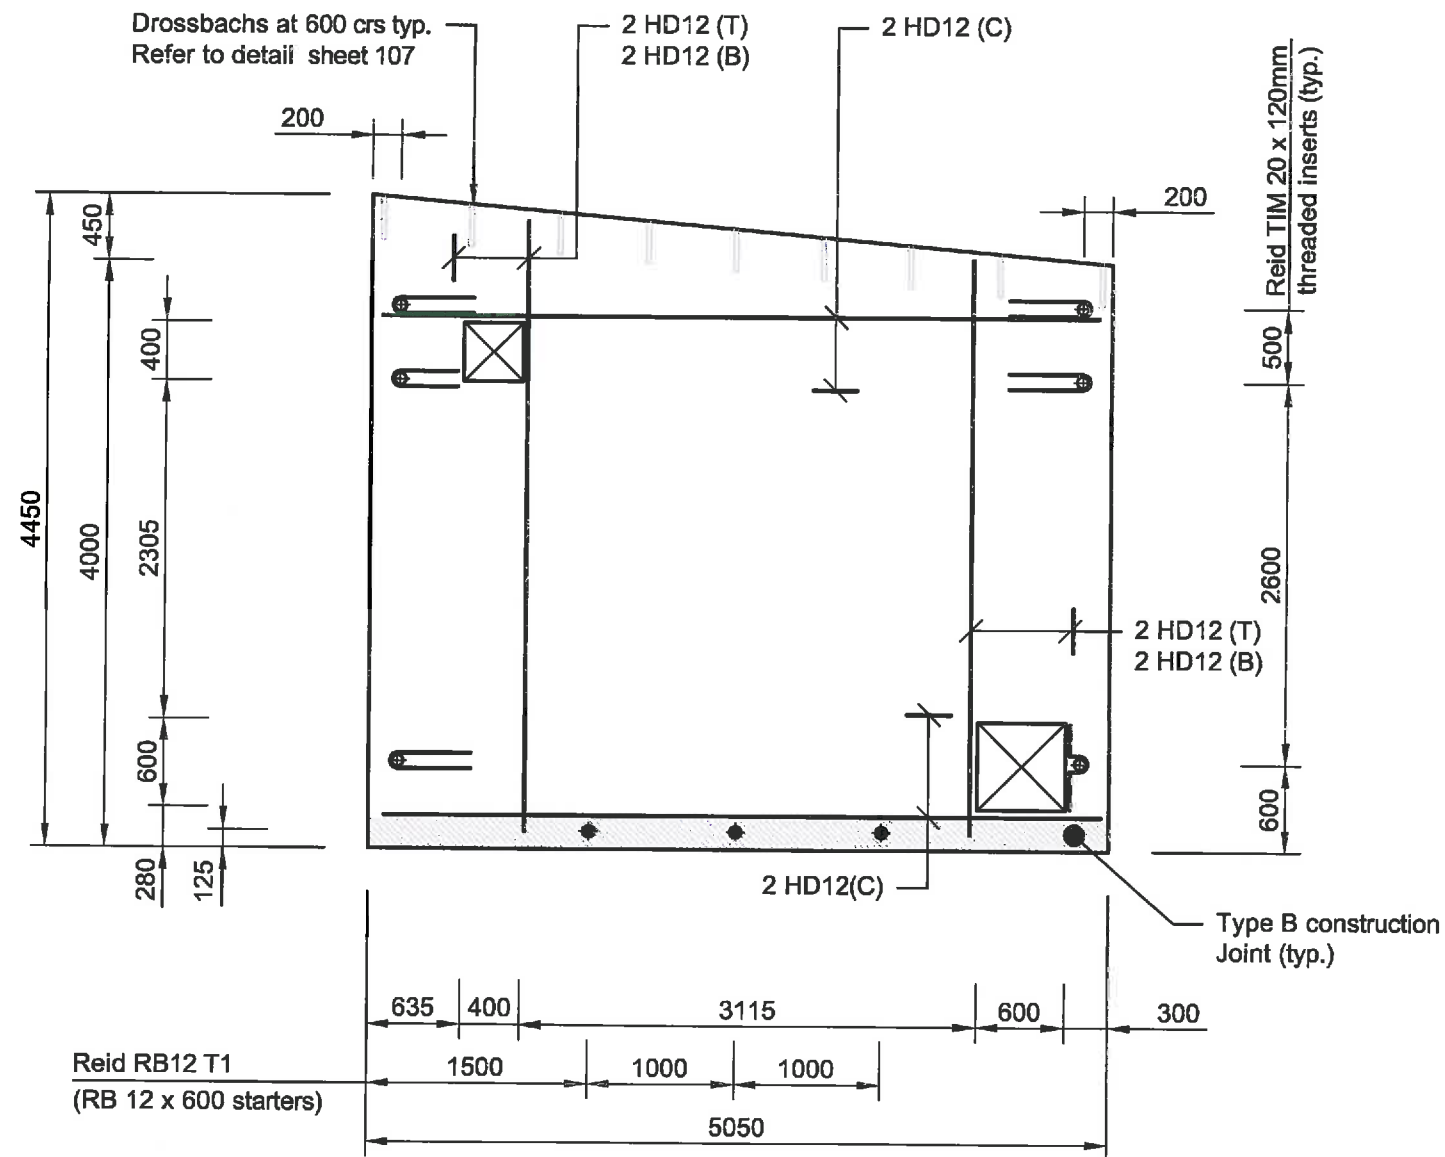

Panel P3

Scale: 1:50

Thickness: 150mm

Notes:

1. All panels viewed from the interior face
2. All panels HD12 @ 200 crs EW (C) with standard 90° hooks bottom and sides
3. Lifting eyes. Reid swiftlift - to be confirmed by contractor
4. Edge anchors. Reid TIM 20 x 120 Galv
5. The contractor is responsible for the design and location of the panel lifting inserts
6. The contractor is to coordinate drossbach location with flat slab roof
7. Chamfer panel edges 10x10
8. T = 40mm top cover
9. B = 50mm bottom cover
10. C = Central

AS BUILT

AS BUILT
CERTIFIED BY: <i>[Signature]</i>
DESIGNATION: <i>[Signature]</i>
DATE: 2/7/2014

Revision	Approved	Approved	Revision	Date
RAB	CERTIFIED AS RAB	GB	08/14	



Christchurch Office
+64 3 353 5400

PO Box 1482
Christchurch 8140
New Zealand

Date: 24/08/2013
Designed: MTM
Approved: M. T. Mitchell

Project No: 3C1004.51
As Shown @ A3


Selwyn District Council
Darfield Water Supply
SH73 Headworks

Pumphouse
Panel P3

Drawing No: 6/1515/19/7602

Sheet No: 109
Revised: RAB

1:50
@ A3

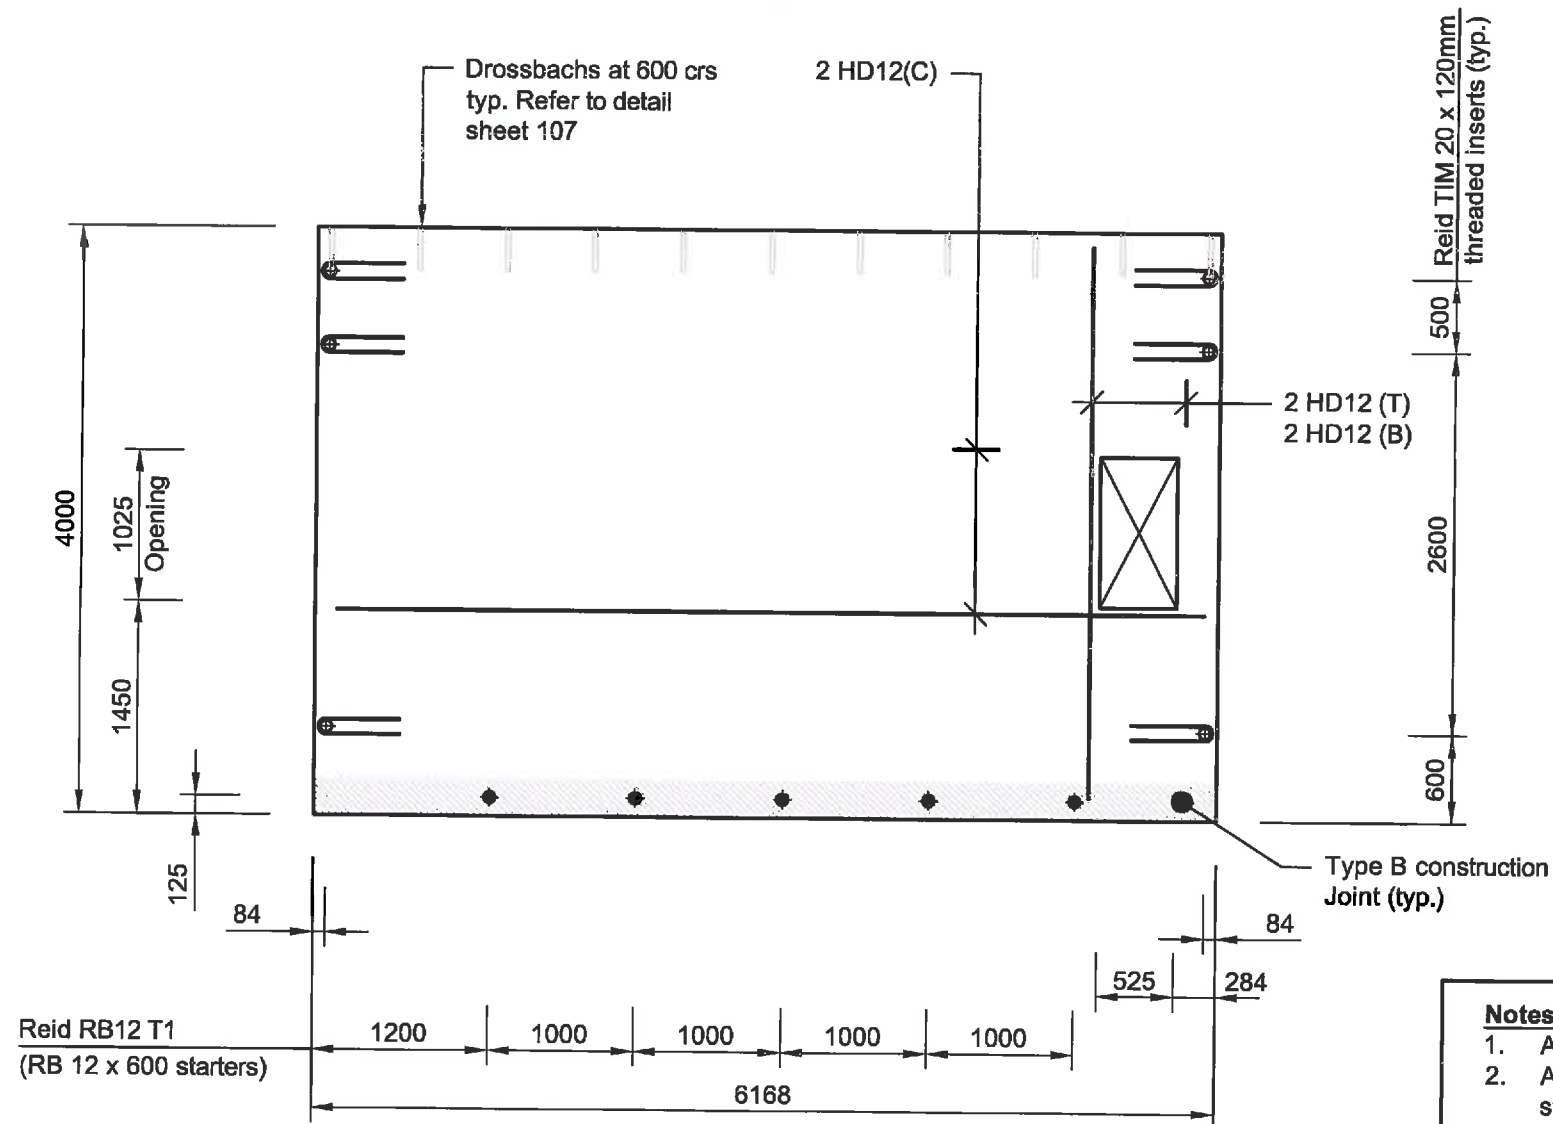

Panel P4

Scale: 1:50
Thickness: 150mm

Notes:

1. All panels viewed from the interior face
2. All panels HD12 @ 200 crs EW (C) with standard 90° hooks bottom and sides
3. Lifting eyes. Reid swiftlift - to be confirmed by contractor
4. Edge anchors. Reid TIM 20 x 120 Galv
5. The contractor is responsible for the design and location of the panel lifting inserts
6. The contractor is to coordinate crossbach location with flat slab roof
7. Chamfer panel edges 10x10
8. T = 40mm top cover
9. B = 50mm bottom cover
10. C = Central

AS BUILT

CERTIFIED BY: *[Signature]*
DESIGNATION: *[Signature]*
DATE: 21/12/2014

AS BUILT

Revision	Amendment	Approved	Revision Date
RAB	CERTIFIED AS RAB	GB	08/14




Christchurch Office +94 3 355 5400	PO Box 1482 Christchurch 8140 New Zealand
Designed DMF	Approved M. T. Mitchell
Project No. 3C1004.51	Revision Date 24/09/2013
Scale As Shown @ A3	Sheet No. 110

Project Selwyn District Council Darfield Water Supply SH73 Headworks
Sheet Pumphouse Panel Details
Drawing No. 6/1515/19/7602
Revision RAB


1:50
@ A3

150 mm
100
50
10 mm
0

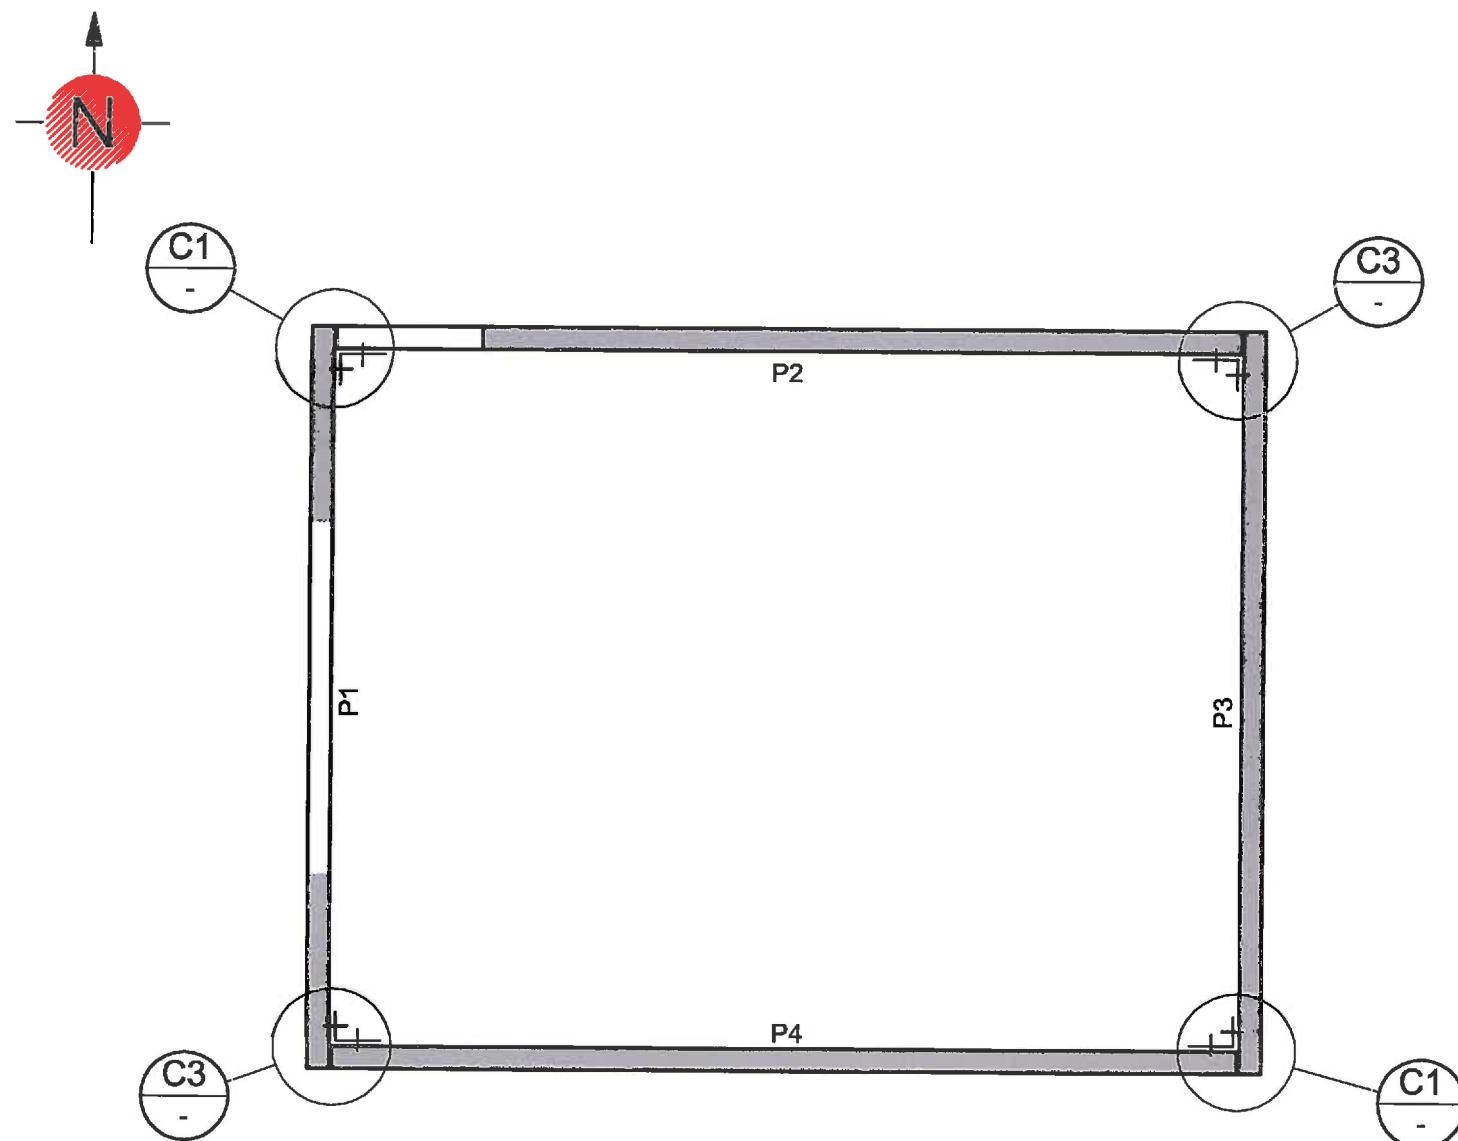

Precast Panel Layout


Scale: 1:50

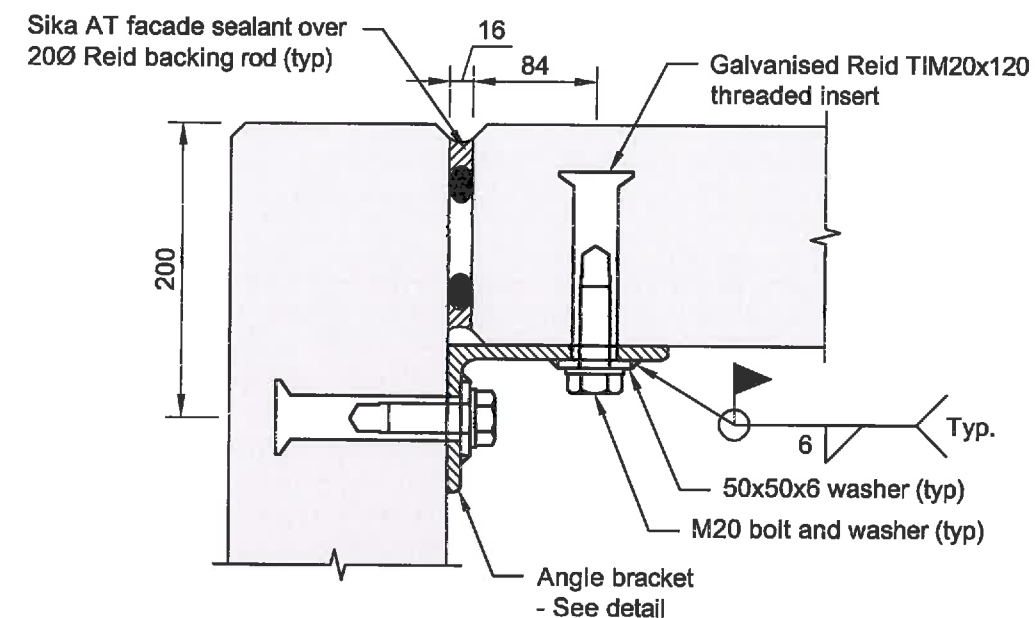

Connection C1

Scale: 1:5


(Connection C3 is other handed)

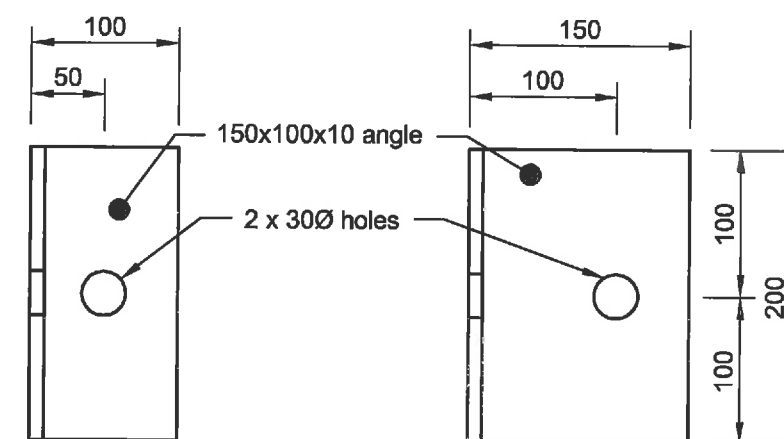

Angle bracket

Scale: 1:5

AS BUILT
 CERTIFIED BY *[Signature]*
 DESIGNATION *Senior Water Consultant*
 DATE *2.12.2014*

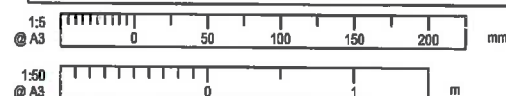

Revised	Amendment	Approved	Revision Date
RAB	CERTIFIED AS RAB	GB	08/14




Christchurch Office
 +64 3 363 5400
 PO Box 1482
 Christchurch 8140
 New Zealand
 Drawn: DMF
 Designed: NTM
 Approved: M. T. Mitchell
 Project No: 3C1004.51
 Scale: As Shown @ A3

Selwyn District Council
 Darfield Water Supply
 SH73 Headworks
 Sheet:
 Pumphouse
 Panel Fixing Details
 Drawing No: 6/1515/19/7602


AS BUILT

111 RAB

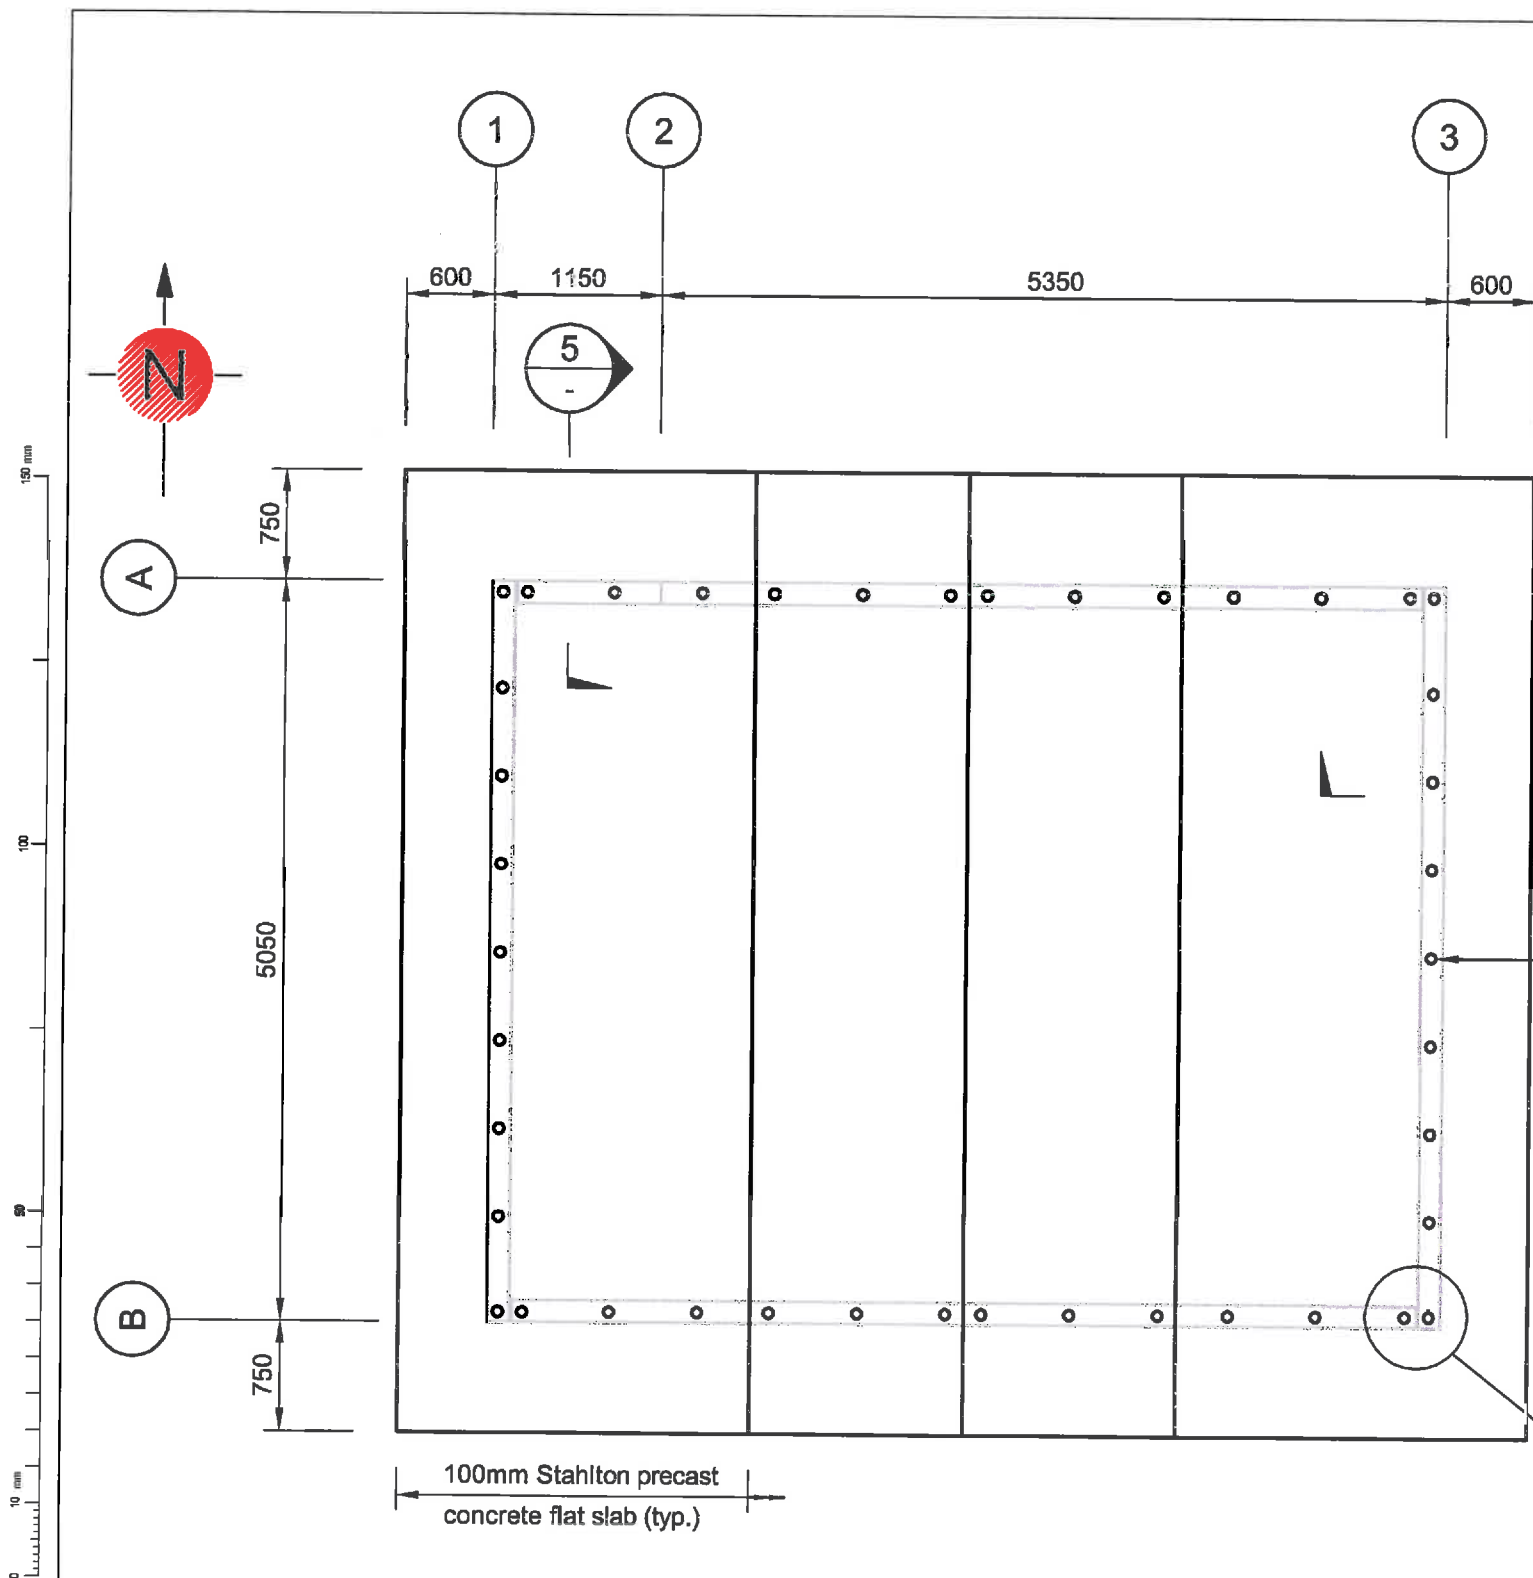


Roof Slab Plan

Scale: 1:50

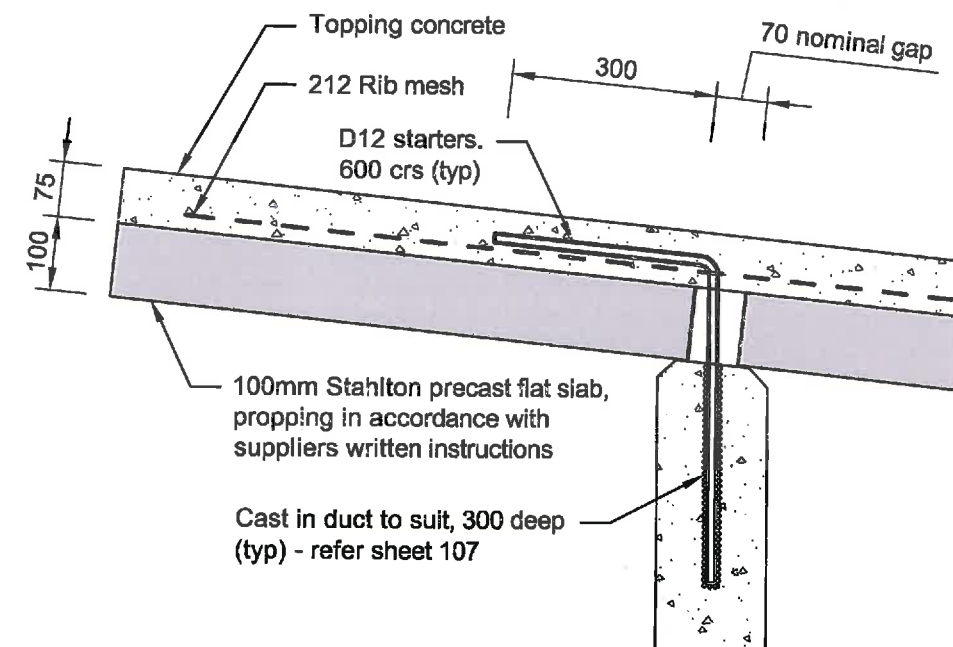

Roof Slab Section

Scale: 1:10

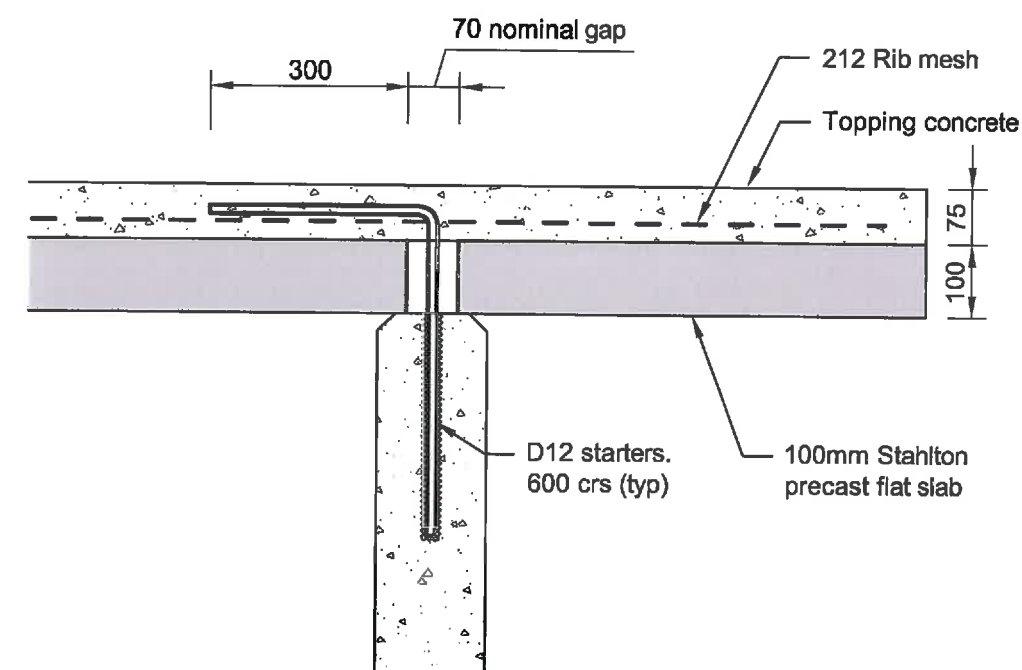

Roof Slab Section

Scale: 1:10

AS BUILT
 CERTIFIED BY: [Signature]
 DESIGNATION: [Signature]
 DATE: 21/12/2014

Ø70 hole in flat slab

75 edge distance (typ.)

AS BUILT

Revised	Amendment	Approved	Revision Date
RAB	CERTIFIED AS RAB	QB	08/14



Christchurch Office
 +64 3 353 5400

PO Box 1482
 Christchurch 8140
 New Zealand

Project
 Selwyn District Council
 Darfield Water Supply
 SH73 Headworks



Sheet
 Pump House
 Roof Slab Plan & Sections

Drawn: DMF
 Designed: MTM
 Approved: M. T. Milne
 Revision Date: 24/09/2013

Project No: 3C1004.51
 Scale: As Shown @ A3


Drawing No: 6/1515/19/7602

Sheet No: 112
 Revise: RAB

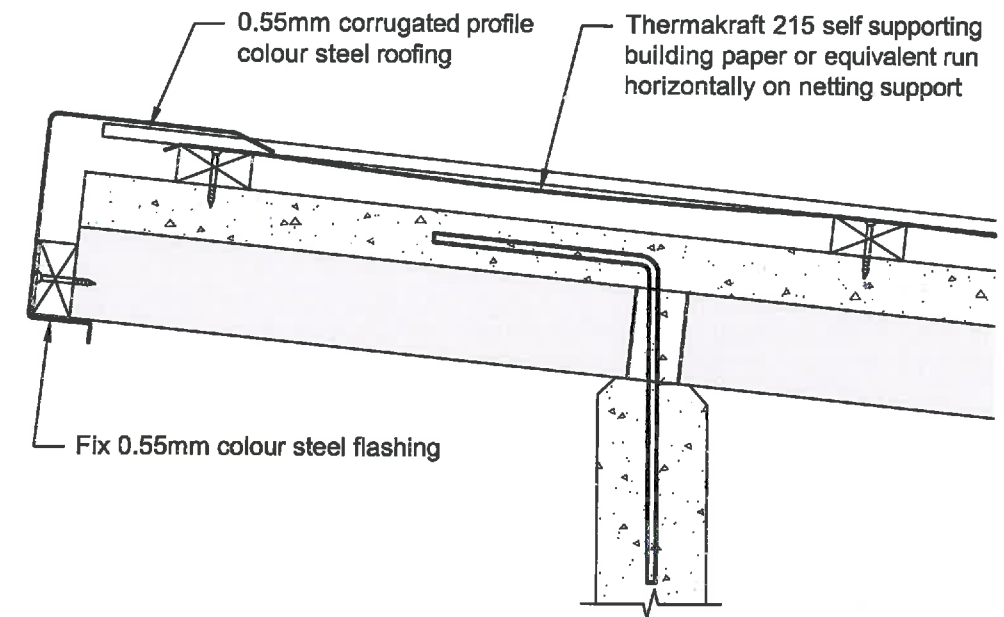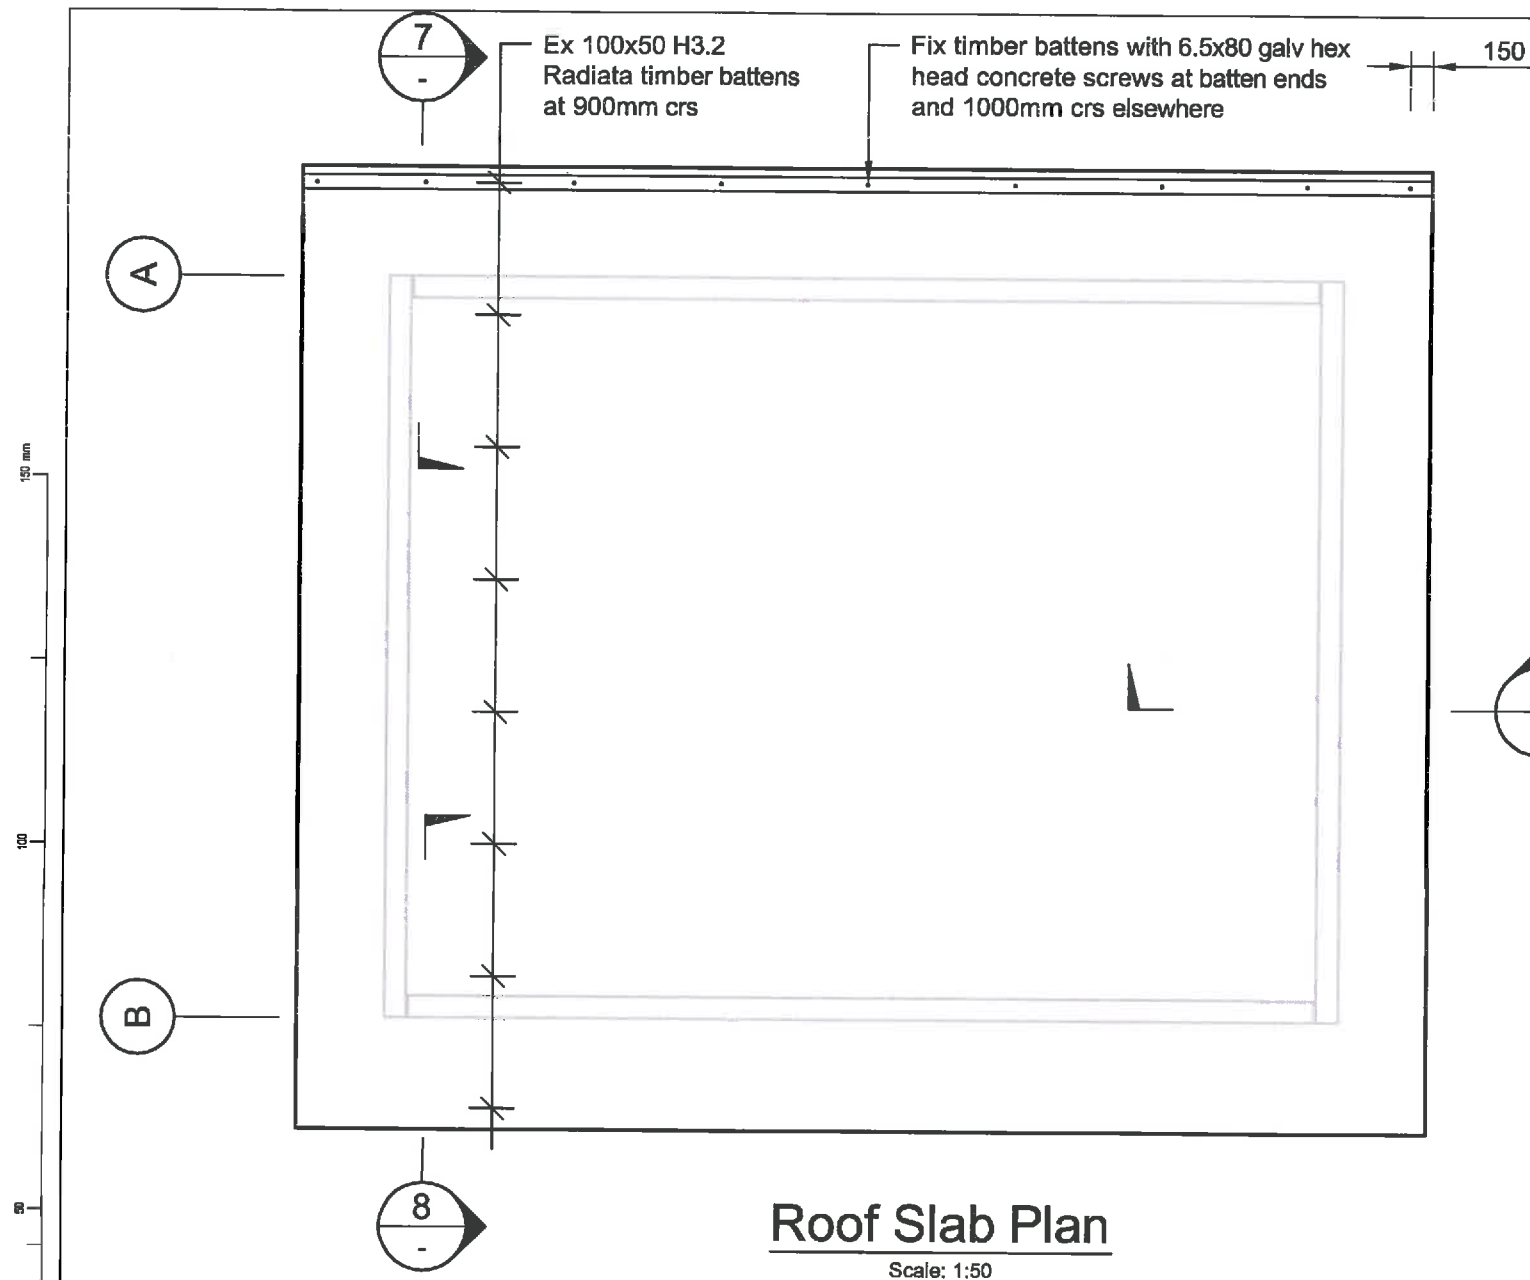


7
-

Roof Framing Section
Scale: 1:10

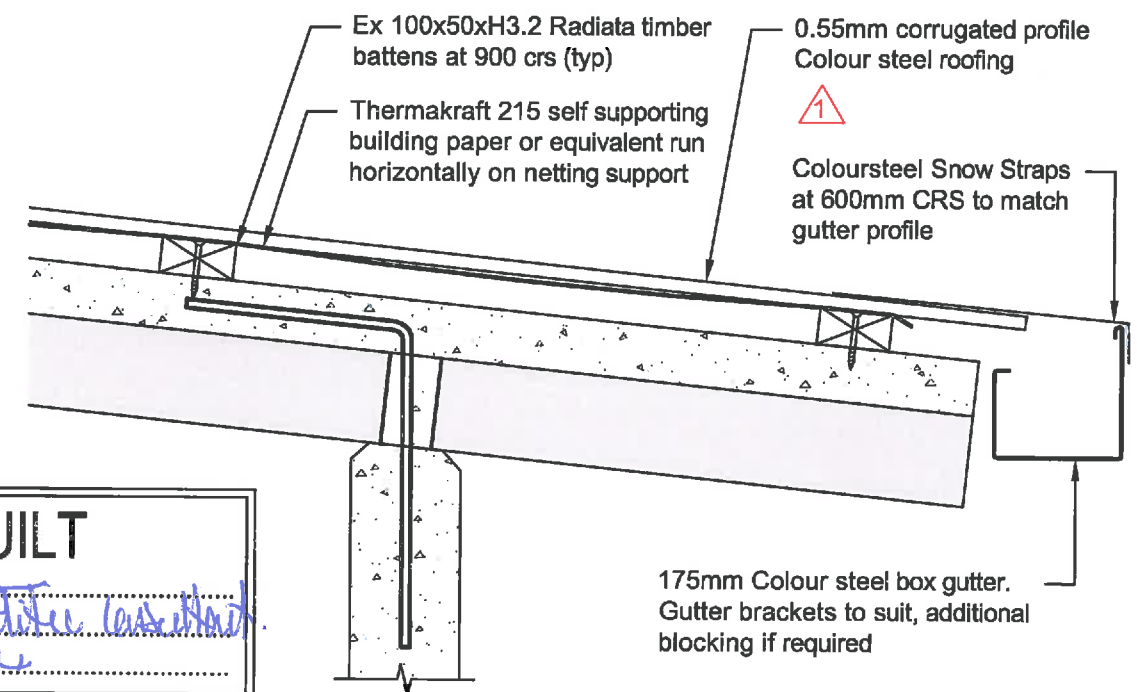

8
-

Roof Framing Section
Scale: 1:10

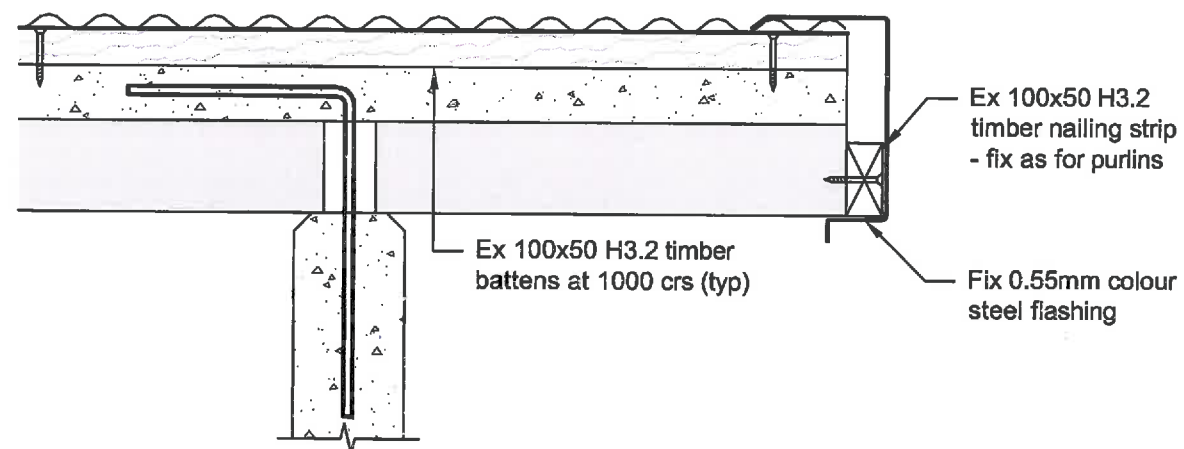

9
-

Roof Framing Section
Scale: 1:10

AS BUILT
CERTIFIED BY: [Signature]
DESIGNATION: [Signature]
DATE: 21/12/14

Revision	Appointed	Approved	Revision Date
RAB	CERTIFIED AS/RAB	GB	08/14



PO Box 1482
Christchurch 8140
New Zealand

Drawn: DMF
Designed: MTM
Approved: M. T. Mitchell
Revision Date: 24/09/2013

Project No: 3C1004.51
As Shown @ A3


Project: Selwyn District Council
Darfield Water Supply
SH73 Headworks
Roof Slab Framing Layout and Details

Drawing No: 6/1515/19/7602


AS BUILT

Sheet No: 113
Revised: RAB

150 mm
100
50
10 mm
0

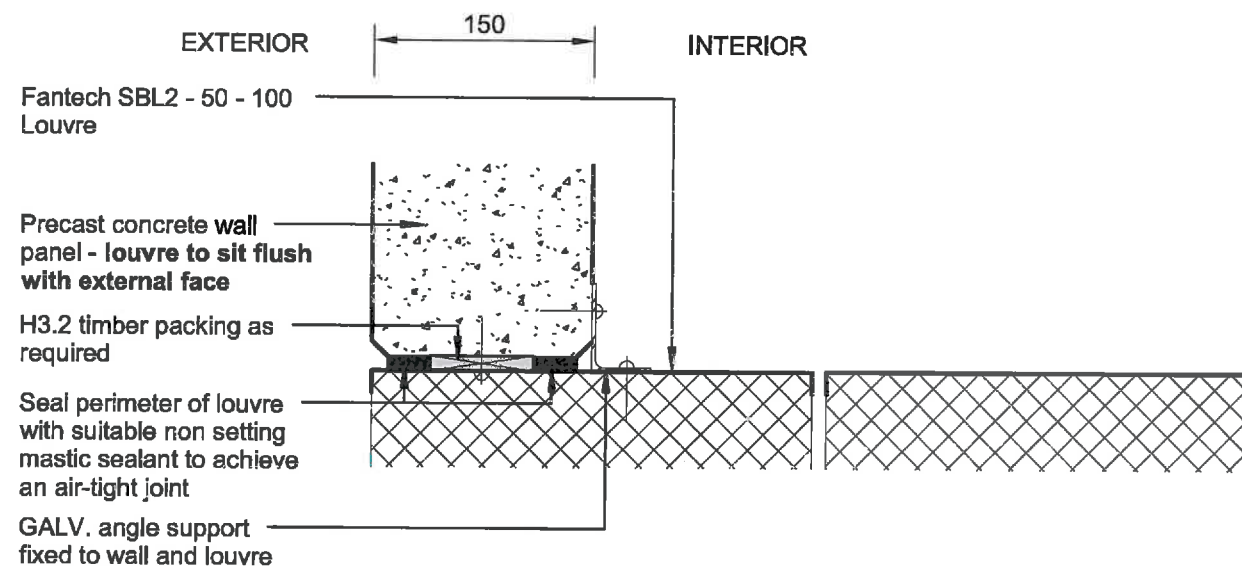

DOUBLE BANK ACOUSTIC LOUVRE HEAD

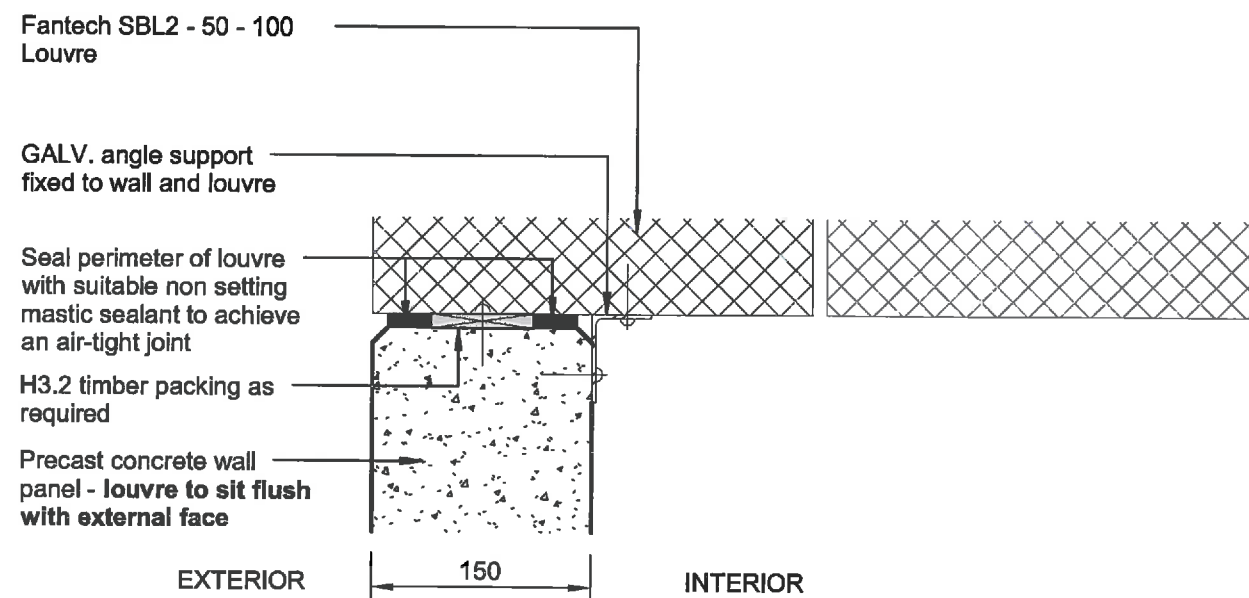

DOUBLE BANK ACOUSTIC LOUVRE SILL


AS BUILT	
CERTIFIED BY	<i>[Signature]</i>
DESIGNATION	<i>Senior Project Engineer</i>
DATE	<i>2.17.2014</i>

Revision	Amendment	Approval	Revision Date
RAB	CERTIFIED AS RAB	GB	08/14




OPUS		PO Box 1482 Christchurch 8140 New Zealand
Drawn DMF	Designed MTM	Approved M. T. Mitchell
Project No 3C1004.51	Scale As Shown @ A3	Revision Date 24/08/2013

Project Selwyn District Council Darfield Water Supply SH73 Headworks	
Sheet Pumphouse Acoustic Louvre Details	
Drawing No. 6/1515/19/7602	Revised No. 114
Revised By RAB	

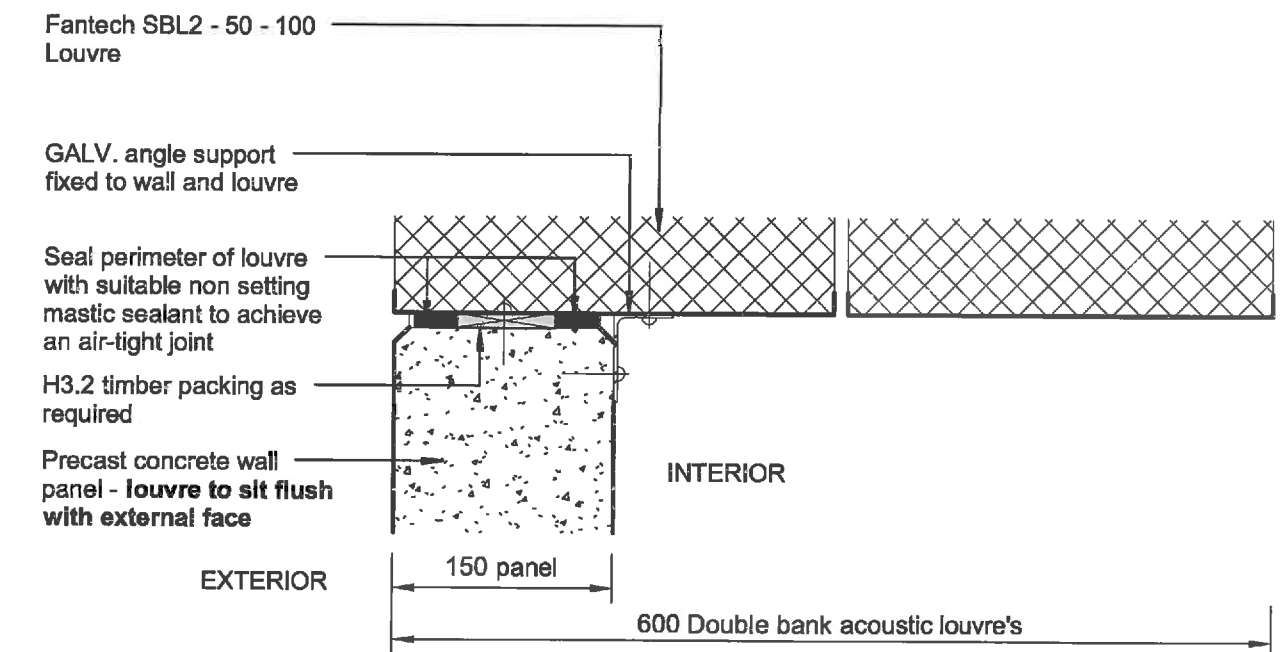


DOUBLE BANK ACOUSTIC LOUVRE JAMB


AS BUILT

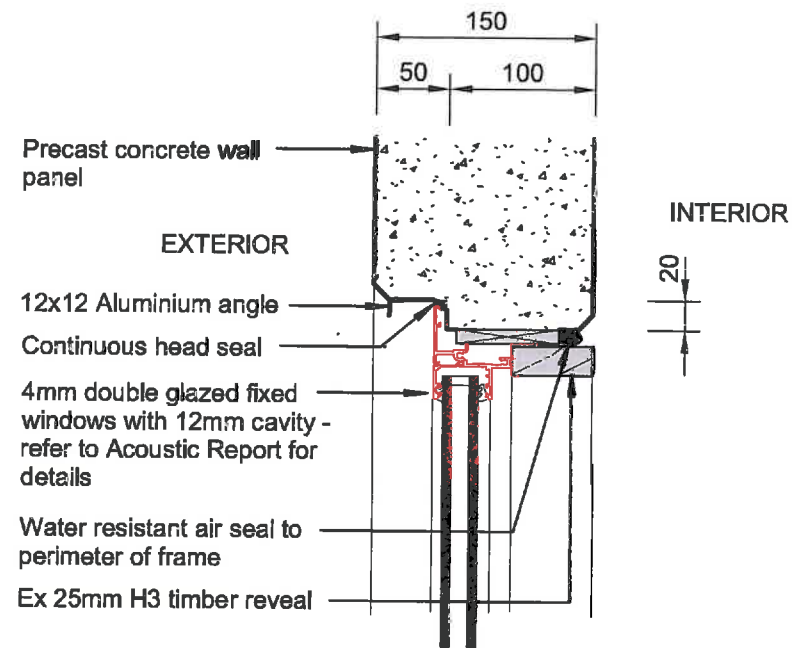

DOUBLE GLAZED WINDOW HEAD

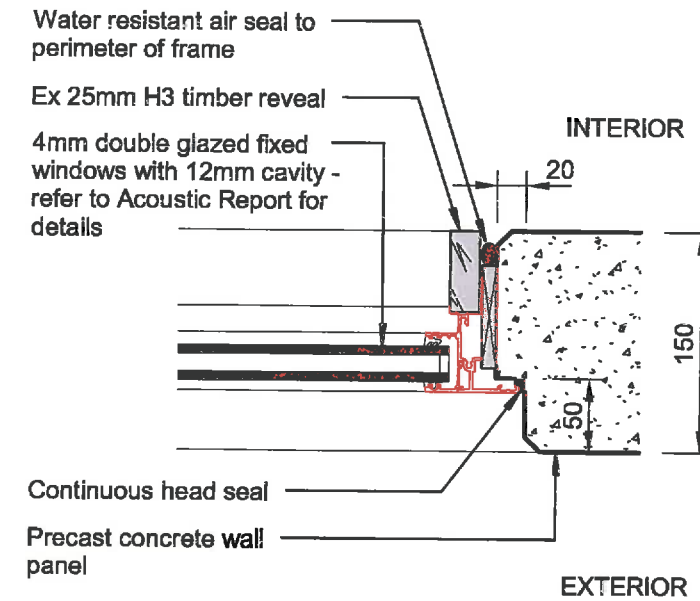

DOUBLE GLAZED WINDOW JAMB

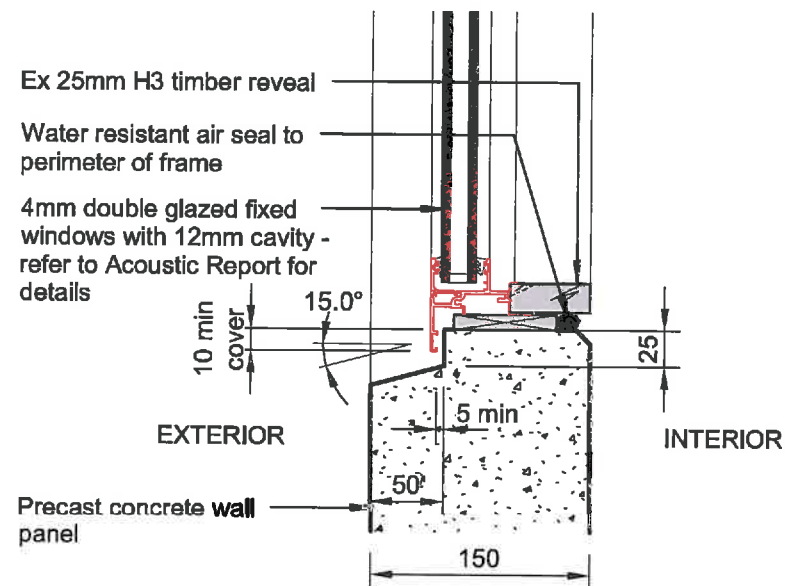

DOUBLE GLAZED WINDOW SILL

AS BUILT	
CERTIFIED BY	<i>[Signature]</i>
DESIGNATION	<i>Senior Civil Engineer</i>
DATE	<i>21/7/2014</i>


Revision	Amendment	Approval	Revision Date
RAB	CERTIFIED AS RAB	GB	08/14




Design	Design	Approved	Revision Date
DMF	NTM	M. T. Mitchell	24/09/2013
Project No.	Scale		
3C1004.51	As Shown @ A3		

Project	
Selwyn District Council	
Darfield Water Supply	
SH73 Headworks	
Sheet	
Pumphouse	
Double Glazed Window Details	
Drawing No.	
6/1515/19/7602	


AS BUILT

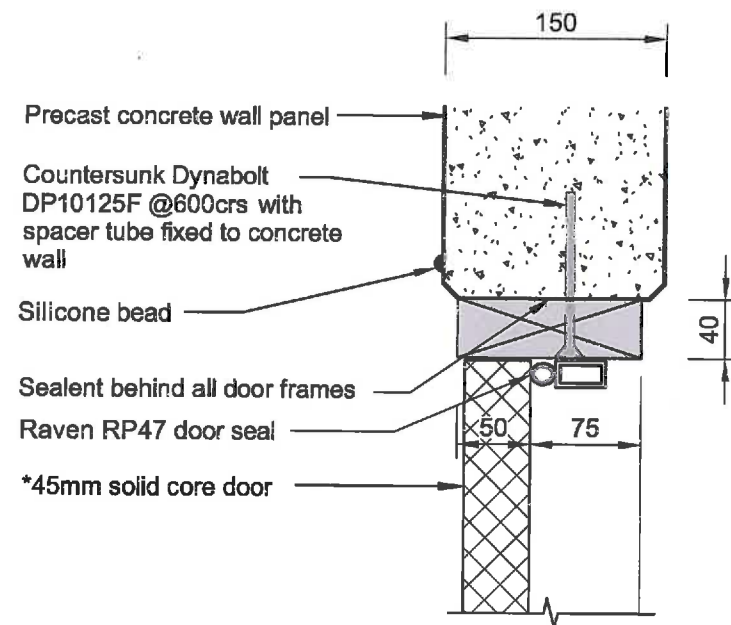

STANDARD DOOR HEAD

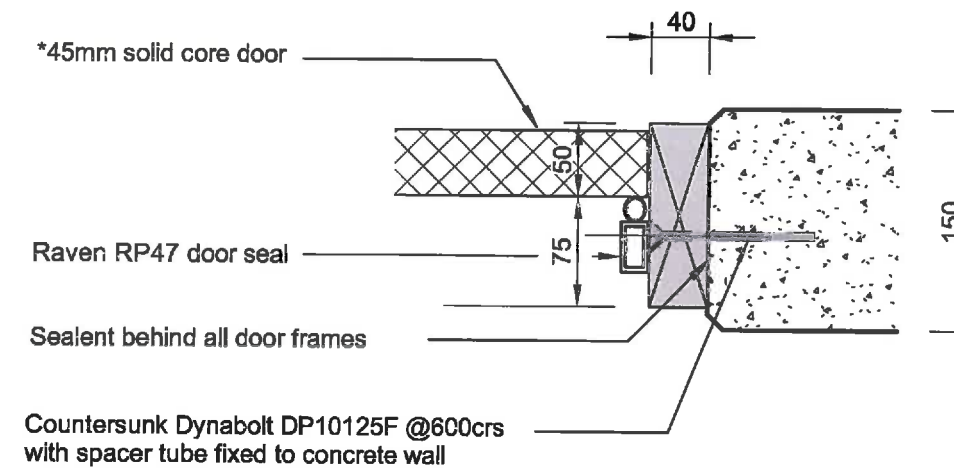

STANDARD DOOR JAMB

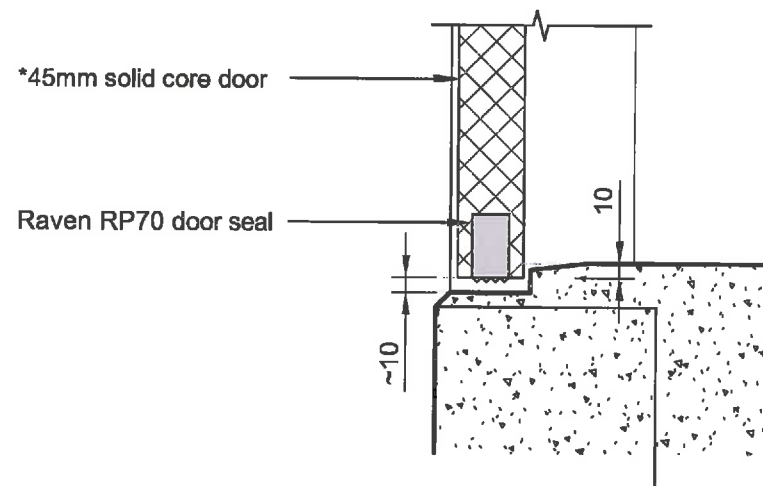

STANDARD DOOR THRESHOLD

*Solid core 45mm exterior grade door with Raven RP47 & RP70 seals, and RP16si (double door joint only). Doors should have acoustic performance of at least 22 dB Rw. Refer to the Acoustic Report for more information.

AS BUILT
 CERTIFIED BY *[Signature]*
 DESIGNATION *[Signature]*
 DATE *2/7/2014*


Rev	Revised	Approved	Revision Date
RAB	CERTIFIED AS RAB	GB	06/14




Drawn: DMF, Designed: NTM, Approved: M. T. Mitchell, Revision Date: 24/09/2013

Project No: 3C1004.51, Scale: As Shown @ A3

Project: Selwyn District Council Darfield Water Supply SH73 Headworks	
Sheet: Pumphouse Single Door Details	
Drawing No: 6/1515/19/7602	Sheet No: 116
Revision: RAB	

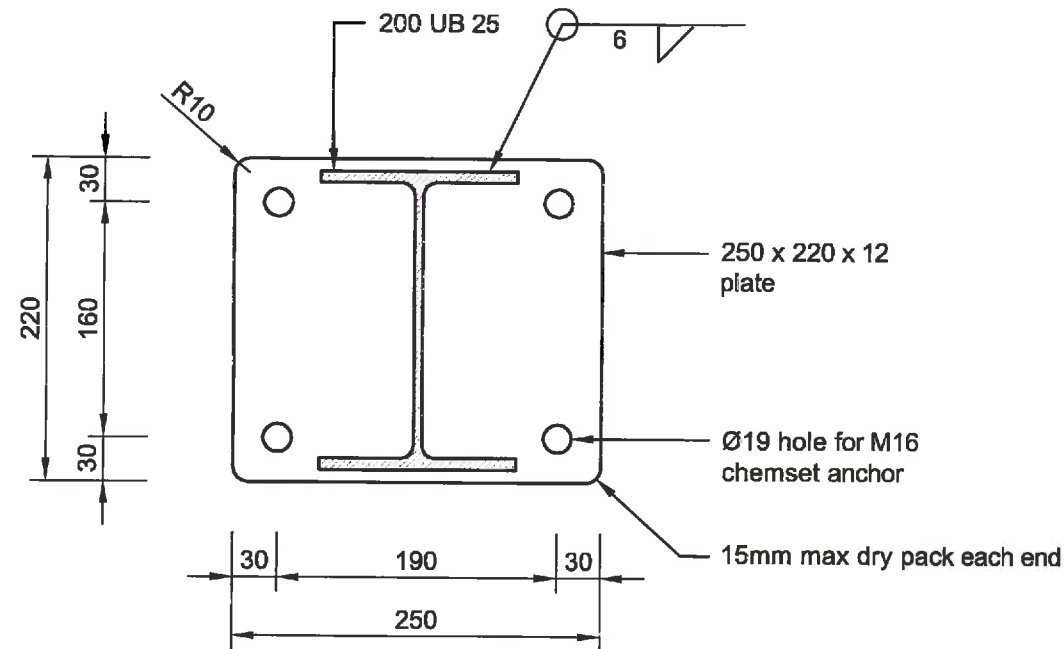


3.1
105
Section
Scale: 1:5

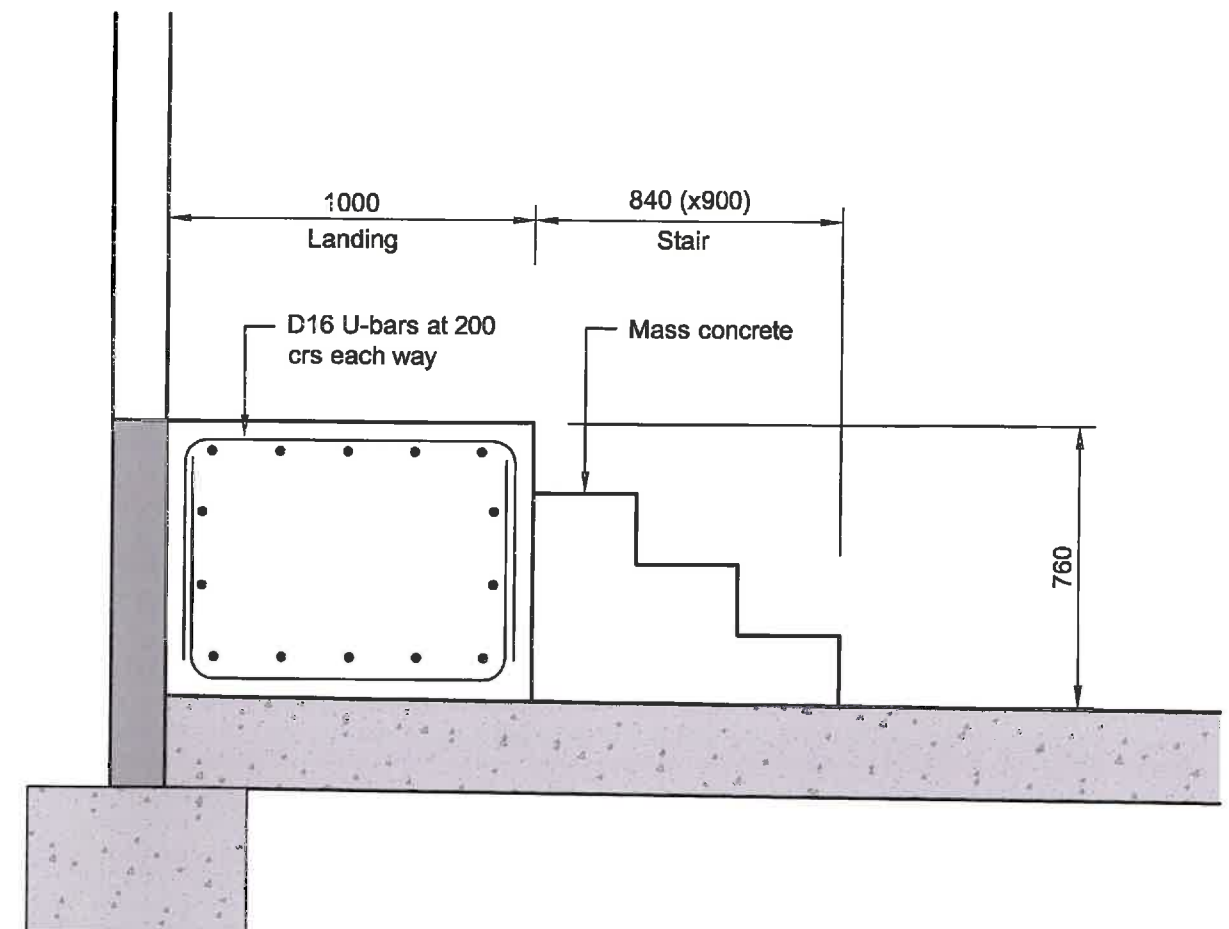

4.1
105
Section
Scale: 1:20

Wood float finish on landing & stair in accordance with NZS 3114:1987 class U2

AS BUILT
CERTIFIED BY: *[Signature]*
DESIGNATION: *[Signature]*
DATE: *2.17.2014*

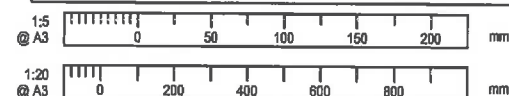

Revision	Author/Item	Approved	Revision Date
RAB	CERTIFIED AS RAB	GB	06/14



Christchurch Office
+64 3 383 5400
PO Box 1482
Christchurch 8140
New Zealand

Drawn: DMF
Designed: NTM
Approved: M. T. Mitchell
Revision Date: 24/09/2013

Project:
Selwyn District Council
Darfield Water Supply
SH73 Headworks








Sheet:
Pumphouse
General Details

Project No: 3C1004.51
Scale: As Shown @ A3

Drawing No: 6/1515/19/7602

AS BUILT

Sheet No: 117
Revision: RAB

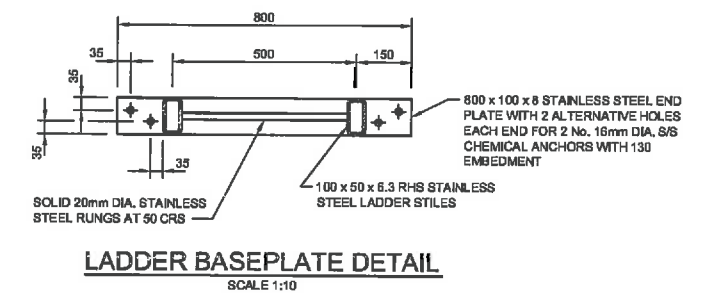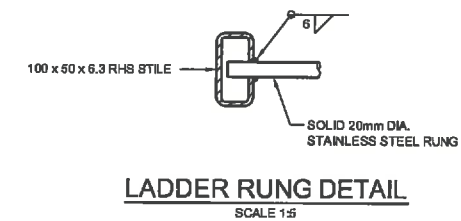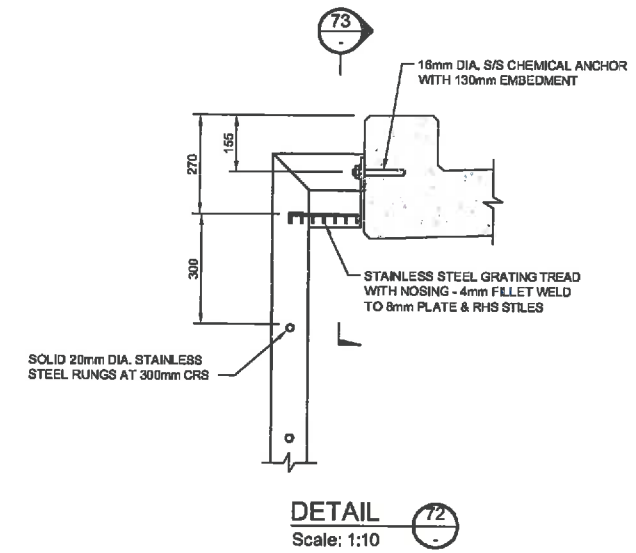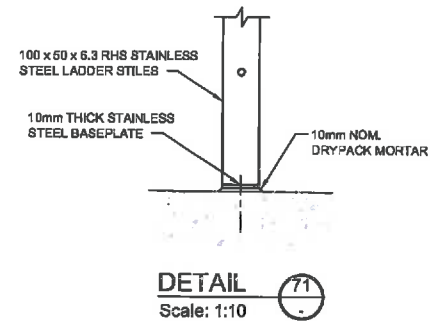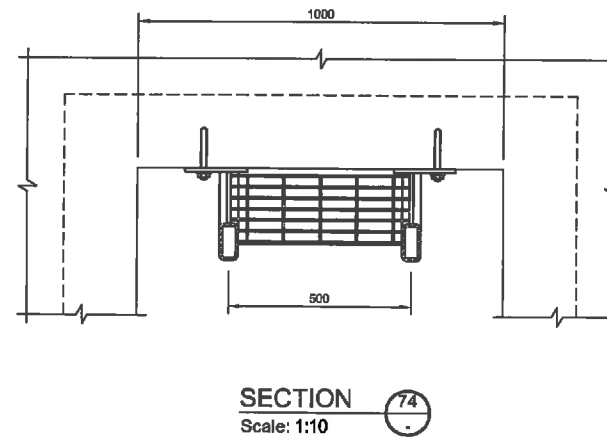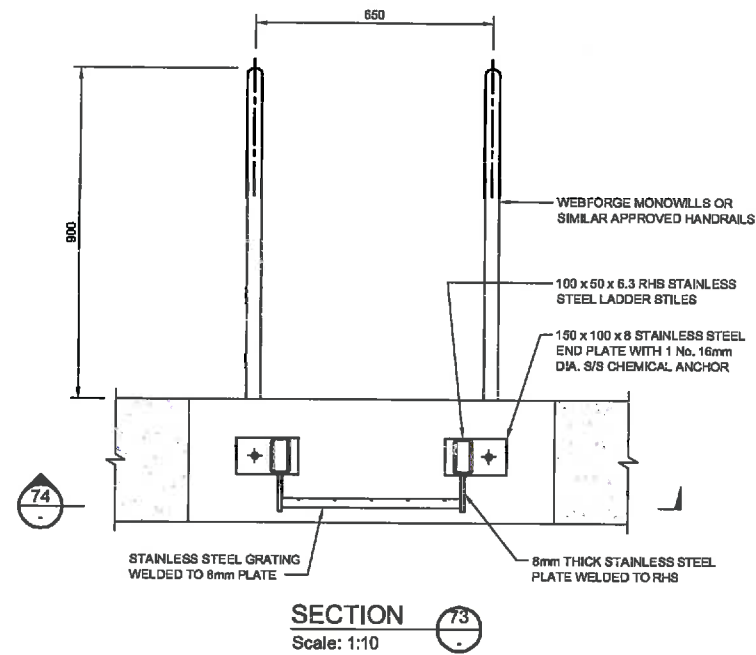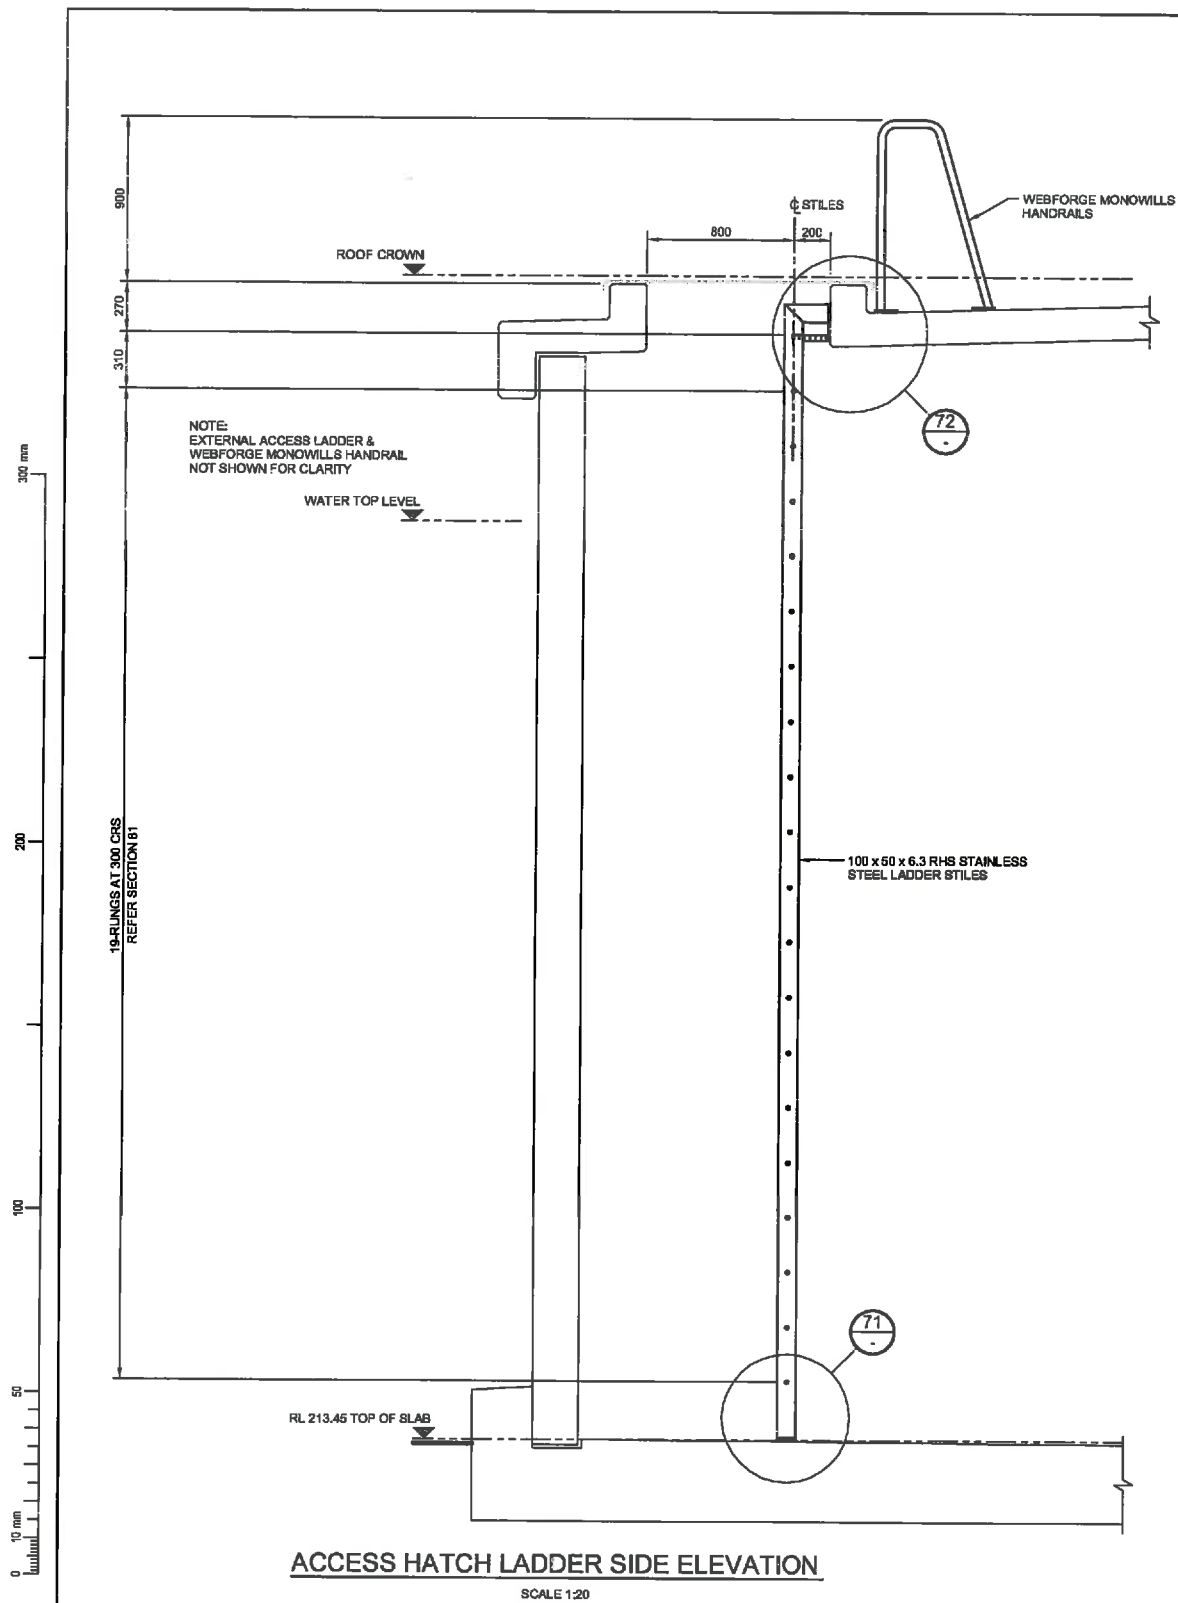


AS BUILT
 CERTIFIED BY *[Signature]*
 DESIGNATION *Senior Civil Engineer*
 DATE *21/12/2014*

Revision	Author	Approved	Revision Date
RAB	CERTIFIED AS RAB	GB	6/14




Wellington Office +64 4 471 7000	PO Box 12-003 Wellington 6144 New Zealand
Drawn G.J.McGILL	Designed L.McDONALD
Approved R.A.DAVEY	Revision Date 12/6/2013
Project No. 3-C1004.51	Scale 1:20 AT A1

Project SELWYN DISTRICT COUNCIL DARFIELD WATER SUPPLY SH73 RESERVOIR
Sheet STEELWORK - ACCESS HATCH LADDER GENERAL ARRANGEMENT ELEVATION
Sheet No. 6 / 1515 / 19 / 7504
Revision 261 RAB

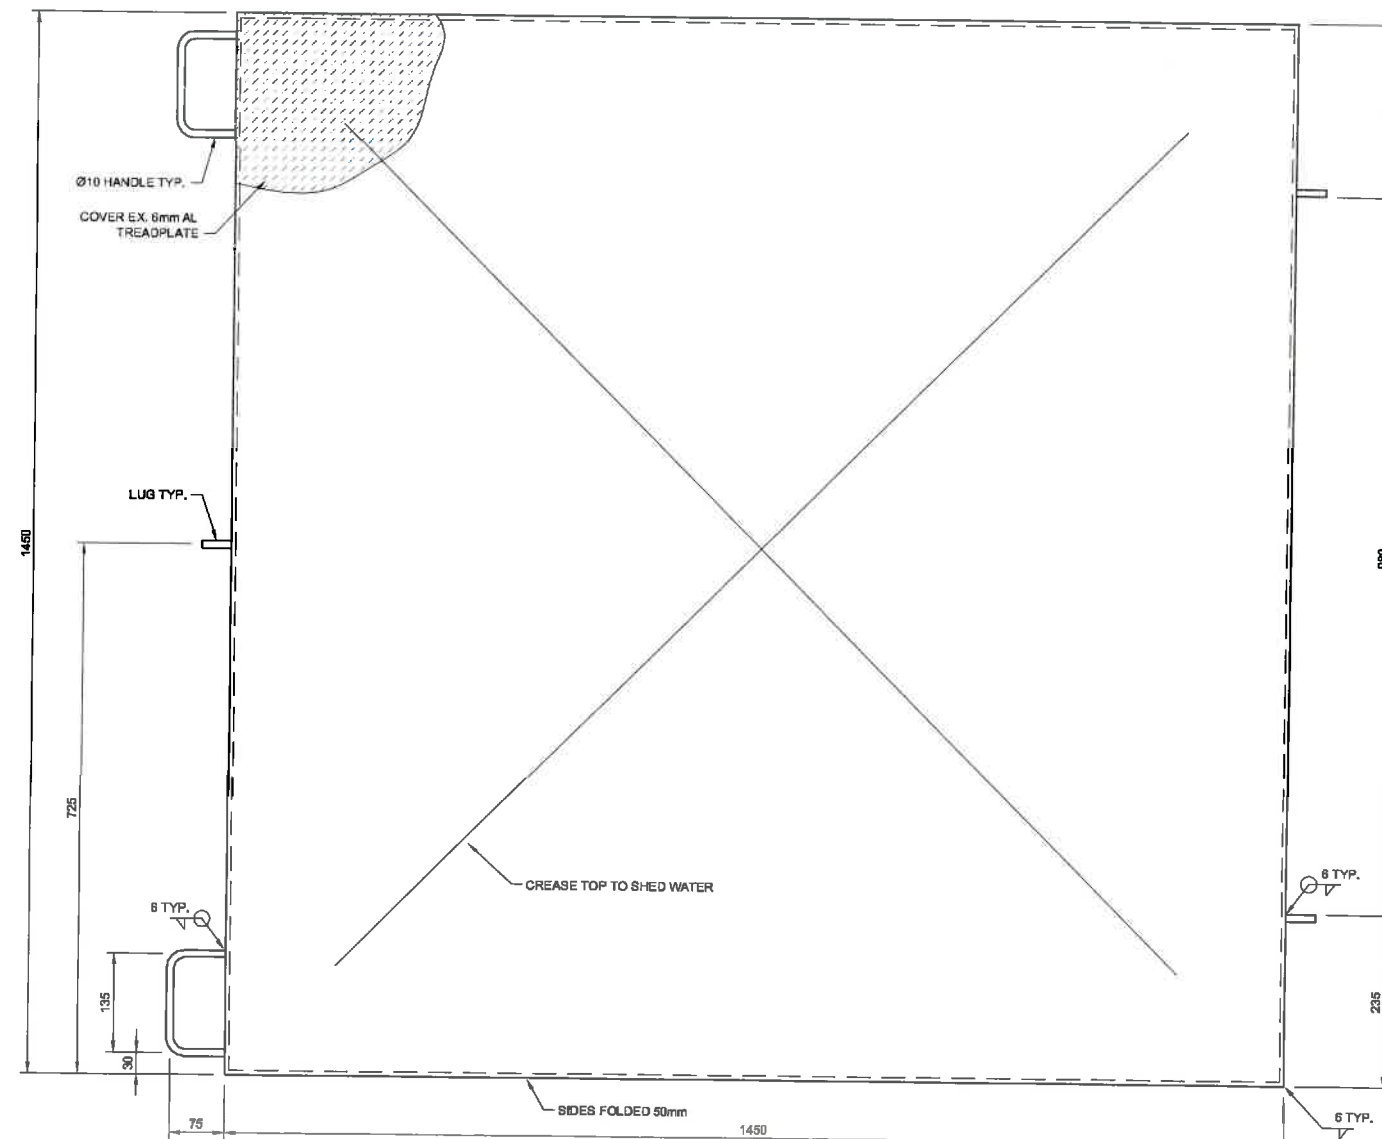


COVER DETAIL
Scale: 1:5


NOTE: ALUMINIUM IS CORROSION
RESISTANT (MARINE GRADE)

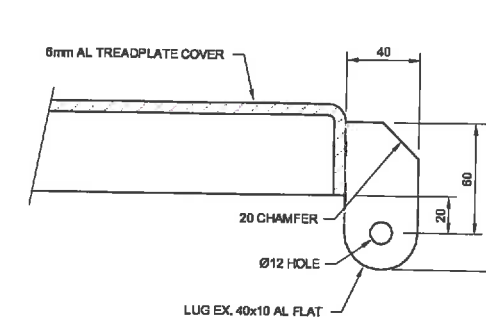


LUG DETAILS
Scale: 1:2

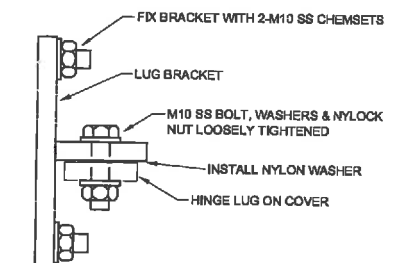


HINGE ASSEMBLY
Scale: 1:2

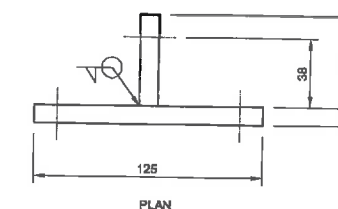

PLAN

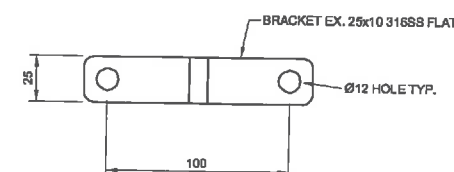


FRONT ELEVATION

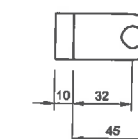

SIDE ELEVATION

LOCKING LUG ASSEMBLY
Scale: 1:2

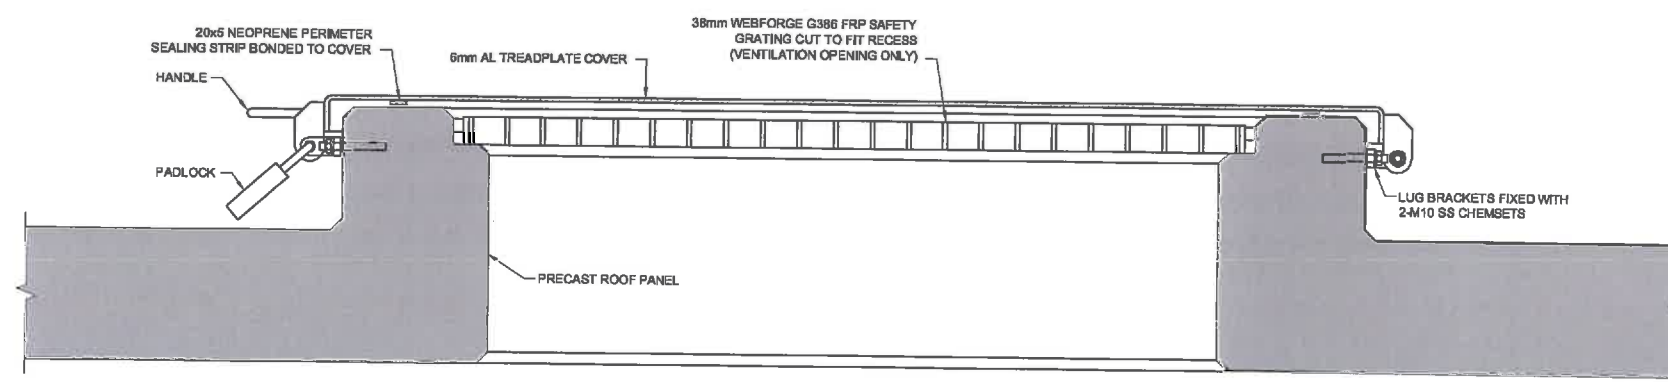

COVER ASSEMBLY
Scale: 1:5

NOTE: HATCH OPENING DIRECTION TO BE
SIDEWAYS I.e. NOT TOWARDS OR AWAY
FROM THE CENTRE OF THE RESERVOIR

AS BUILT
CERTIFIED BY: [Signature]
DESIGNATION: [Signature]
DATE: 2.17.2014

AS BUILT

Revision	Amendment	Approved	Revision Date
RAB	CERTIFIED AS RAB	GB	05/14



OPUS
Christchurch Environmental
+64 3 353 5400

PO Box 1482
Christchurch 8140
New Zealand


Drawn: GB, Design: GB, Approved: GB, Revision Date: MAY 2014

Project No: 3C1004.51, Title: AS SHOWN (A1), Drawing No: 6/1515/19/7605


Project: SELWYN DISTRICT COUNCIL
DARFIELD WATER SUPPLY UPGRADE
CONTRACT 1133
Sheet: RESERVOIR
ACCESS HATCH DETAILS

Sheet No: 262, Revision: RAB


300 mm
200
100
50
10 mm
0

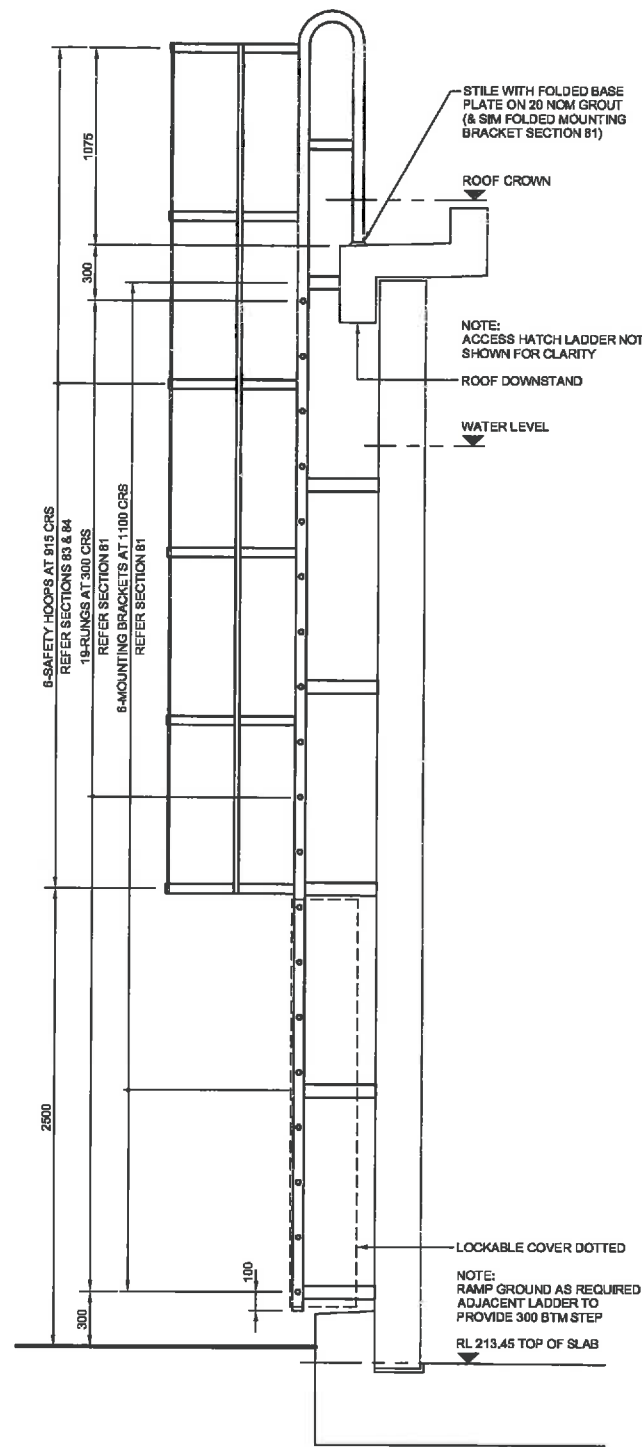


LADDER SIDE ELEVATION
SCALE 1:25

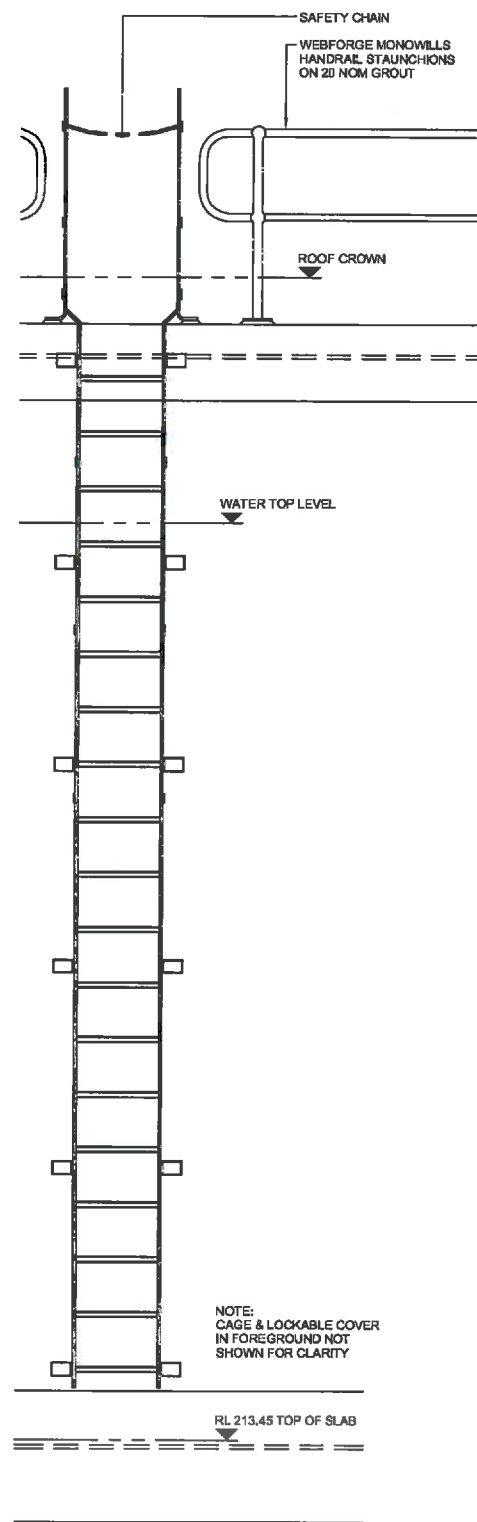


LADDER FRONT ELEVATION
SCALE 1:25

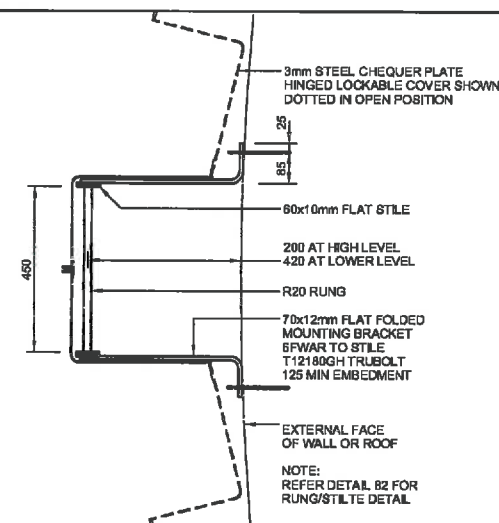


SECTION 81
Scale: 1:10
TYP LADDER PLAN

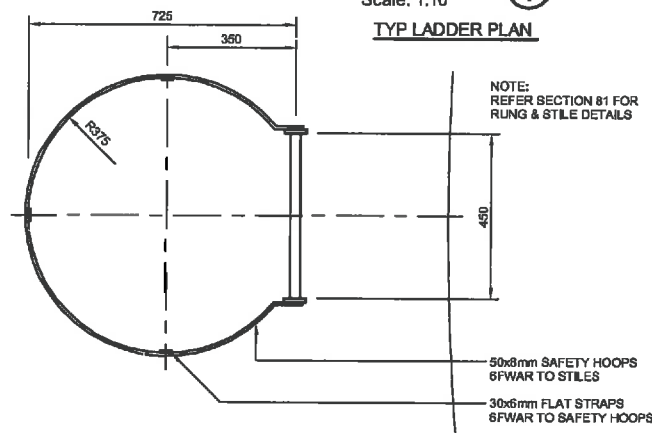

SECTION 83
Scale: 1:10
TYP INTERMEDIATE LADDER PLAN

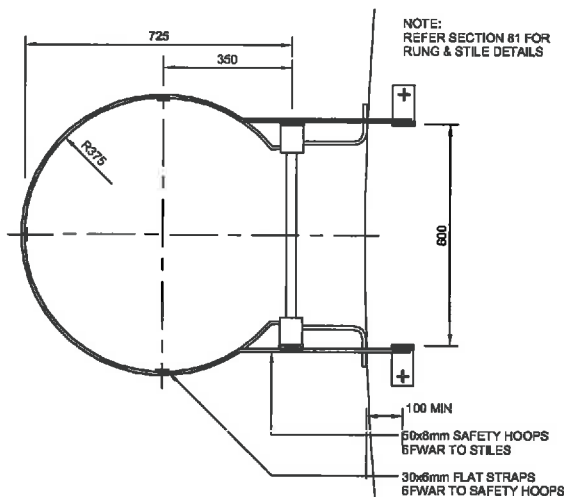

SECTION 84
Scale: 1:10
ROOF LADDER PLAN

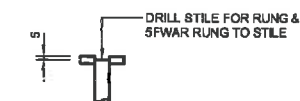

DETAIL 82
Scale: 1:5
TYP RUNG/STILE

AS BUILT
CERTIFIED BY: [Signature]
DESIGNATION: [Signature]
DATE: 21/7/2014

Revision	Amendment	Approved	Revision Date
RAB	CERTIFIED AS RAB	GB	8/14




Drawn	Designed	Approved	Revision Date
G.I. McGill	I. McDonald	R. Davey	12/6/2013
Project No.	Scale	Sheet No.	Revised
3-C1004.51	1:20, 1:10, 1:5 AT A1	263	RAB


Project	Project
SELWYN DISTRICT COUNCIL DARFIELD WATER SUPPLY SH73 RESERVOIR	STEELWORK - EXTERNAL ACCESS LADDER GENERAL ARRANGEMENT & DETAILS
6/1515/19/7504	263




THERMOSTAT MOUNTED ON PUMP ROOM
CONTROL CABINET SETTING 25 DEG

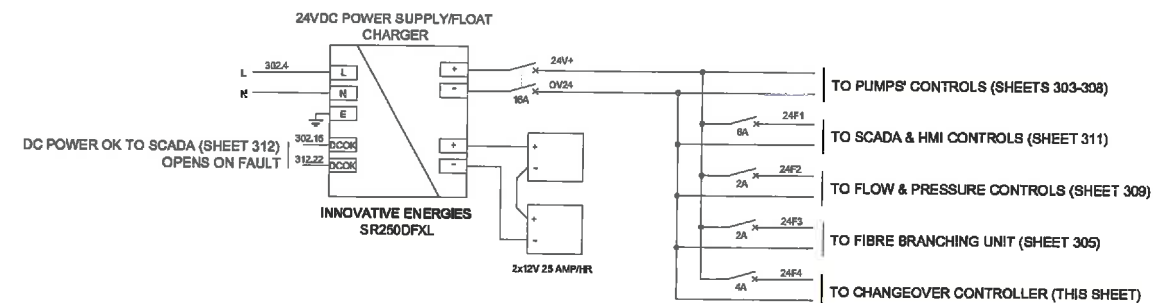

The diagram illustrates the wiring from an "INTERFACE BOX (EXISTING)" to a new "A/C 1 RUNNING" unit. The interface box has two terminals labeled "1" and "2". Terminal "1" connects via a 2C 10mm cable to terminal "1" of the A/C 1 unit. Terminal "2" connects via a 2C 10mm cable to terminal "2" of the A/C 1 unit. The A/C 1 unit is shown with two internal components: a fan motor labeled "FAN" and a compressor labeled "COMP". Both are connected to a common power supply line labeled "TBS-302". The fan motor is rated at 300.5 and the compressor at 300.6.

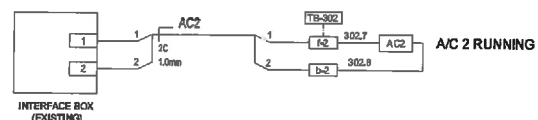

TO SCADA (SHEET 312)
GENERATOR TEST ACTIVE

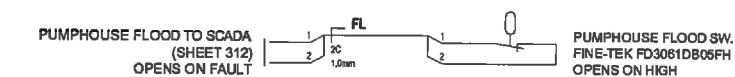

GENERATOR TEST

24V+
0V24

24V

0V

302.10

302.11

302.12

PFR1R

GR

NOTE:
EXISTING CONTROLLER
SALVAGED FOR RE-USE

CHANGEOVER CONTROLLER (EXISTING)

Q1

1

2

302.13

OM

302.20

TC2

Q2

1

2

302.14

CG

302.21

TC3

OM

TC1

Q3

1

2

301.21

301.22

Q4

1

2

302.15

311.14

TC4

10s ONDELAY (10s OFF, THEN ON)

OPEN MAINS

5s ONDELAY (5s OFF, THEN ON)

CLOSE MAINS TIMER

CLOSE TO GENERATOR

CLOSE GENERATOR TIMER

5s ONDELAY (5s OFF, THEN ON)

PAUSE TIMER

5s INTERVAL (5s ON, THEN OFF)

TO GENERATOR - (SHEET 301)
RUN REQUIRED

TO SCADA (SHEET 311)
WATCHDOG INPUT

EATON EASY 513-DCRC

POWER DISTRIBUTION C'TD.

AS BUILT 7/4/14 PCSL



Drum	Deep red	Approved	Row
------	----------	----------	-----

GB	GB		FE
----	----	--	----

Project No.	State
-------------	-------


3C1004.51	NTS
-----------	-----

**SELWYN DISTRICT COUNCIL
DARFIELD WATER SUPPLY UPGRADE
CONTRACT 1133**

**ELECTRICAL CONTROLS
POWER DISTRIBUTION 2**

Drawing No.
6/1515/19/7605

AS BUILT

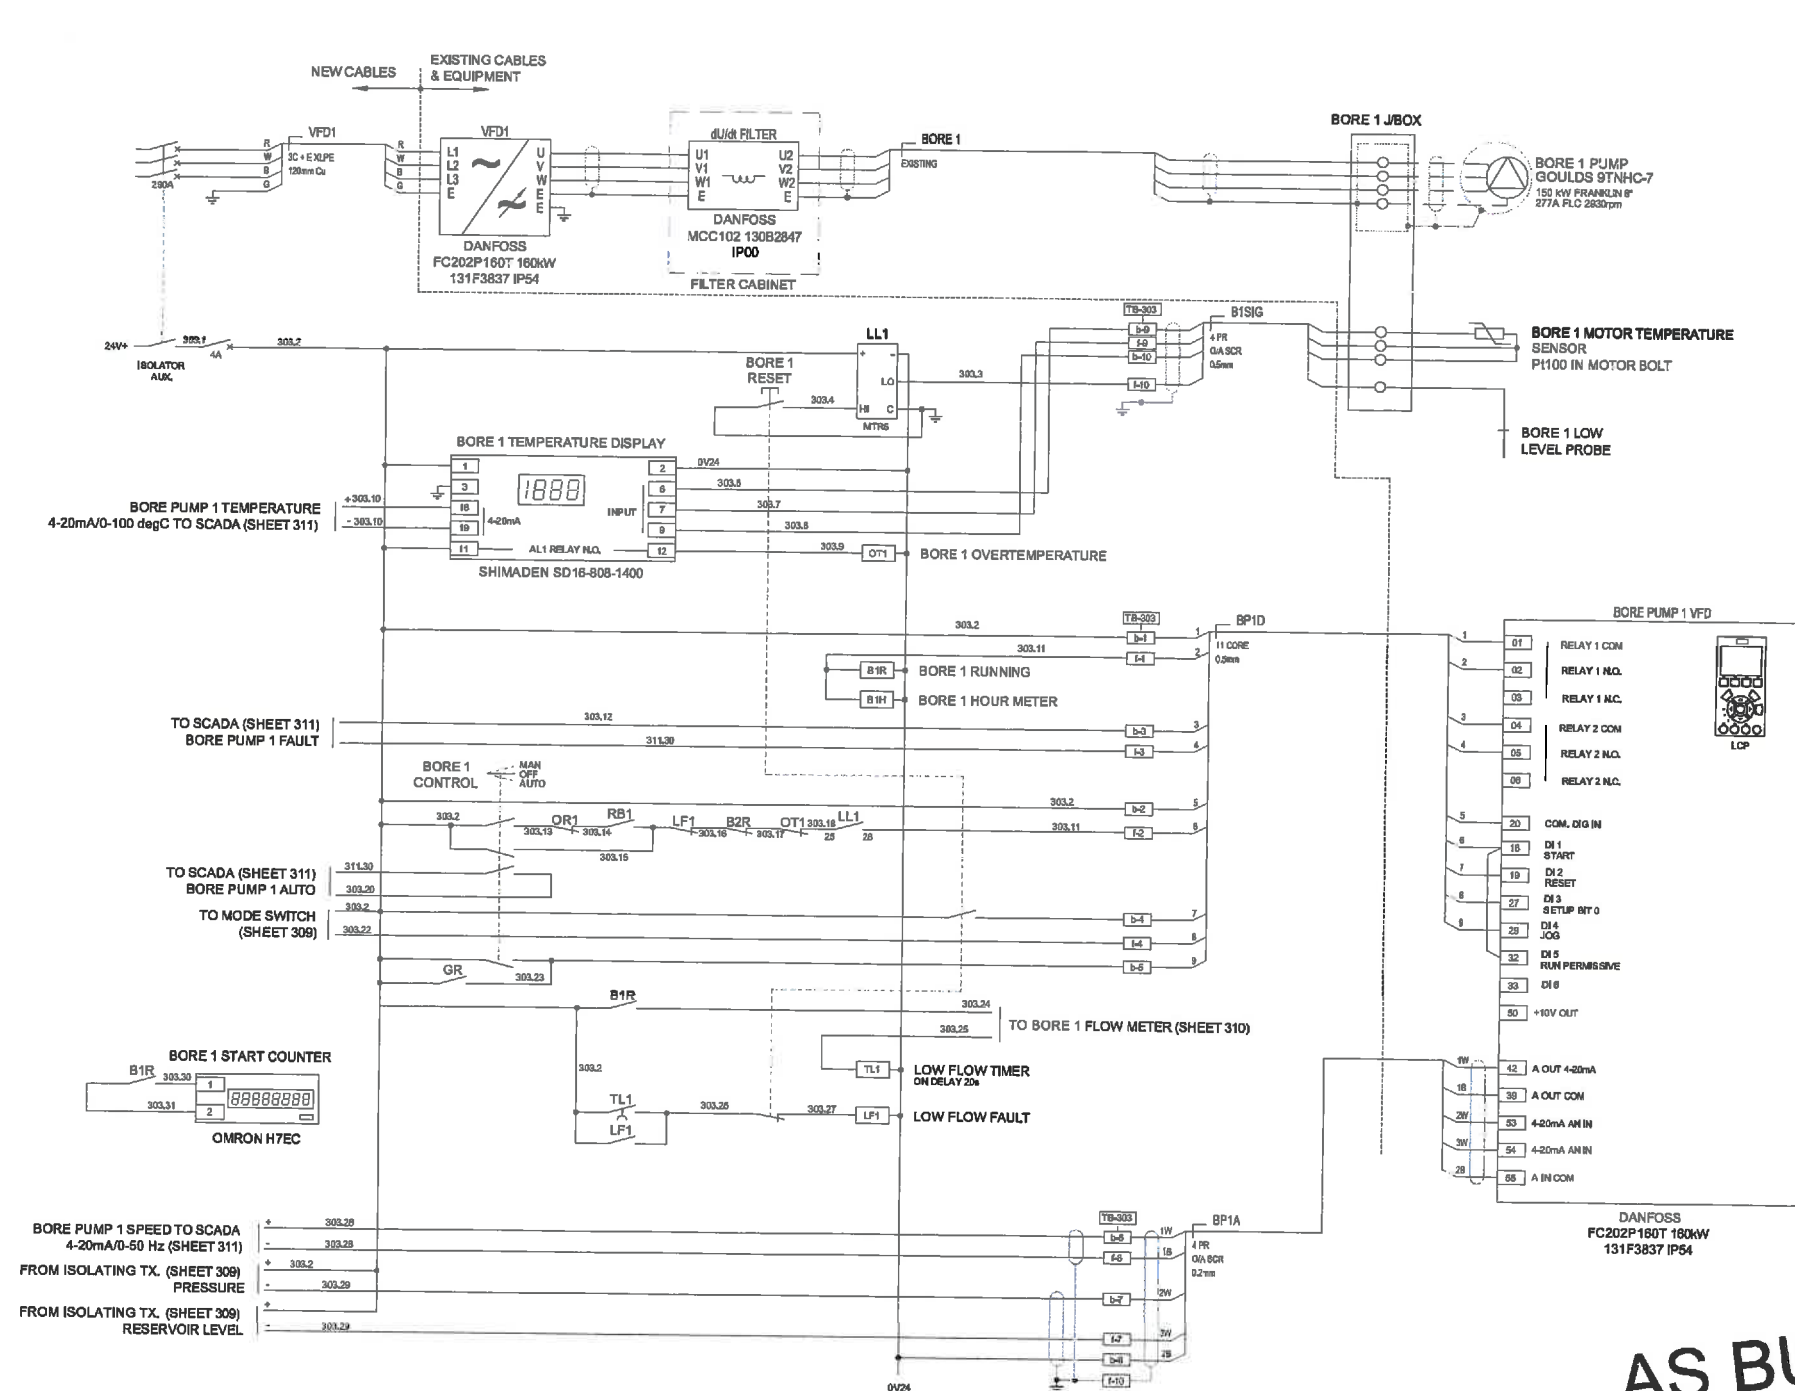

VFD SETTINGS:

- MINIMUM SPEED: 40 Hz
- MAXIMUM SPEED: 50 Hz
- ANALOGUE OUT: MOTOR SPEED 0-50 Hz
- RELAY 1: RUNNING
- RELAY 2: FAULT
- AUTO RESET: ENABLED (x2, 10s DELAY)
- RAMP 0-40 Hz 2s
- RAMP 40-50 Hz 2s
- ACCELERATION 30-50-30 Hz 10s
- JOG SPEED: 40 Hz
- START DELAY: 2s

MOTOR PROTECTION: THERMAL MODEL

- SETUP 1: RESERVOIR LEVEL CONTROL RAMP
- MINIMUM SPEED: RESERVOIR >80% FULL
 - MAXIMUM SPEED: RESERVOIR LEVEL <70% FULL

- SETUP 2: PID CONTROL OF PRESSURE TO 280 kPa
- PID GAIN: 0.4

SETTINGS TO BE CONFIRMED AND TESTED ON SITE

AS BUILT 7/4/14 PCSL

AS BUILT

Revision	Amendment	Approved	Revision Date
RAB	CERTIFIED AS BUILT	GB	06/14



Christchurch Environmental
+64 3 353 5400


PO Box 1482
Christchurch 8140
New Zealand

SELWYN DISTRICT COUNCIL
DARFIELD WATER SUPPLY UPGRADE
CONTRACT 1133

ELECTRICAL CONTROLS
BORE PUMP 1 CONTROLS

6/15/15/19/7805

303 RAB

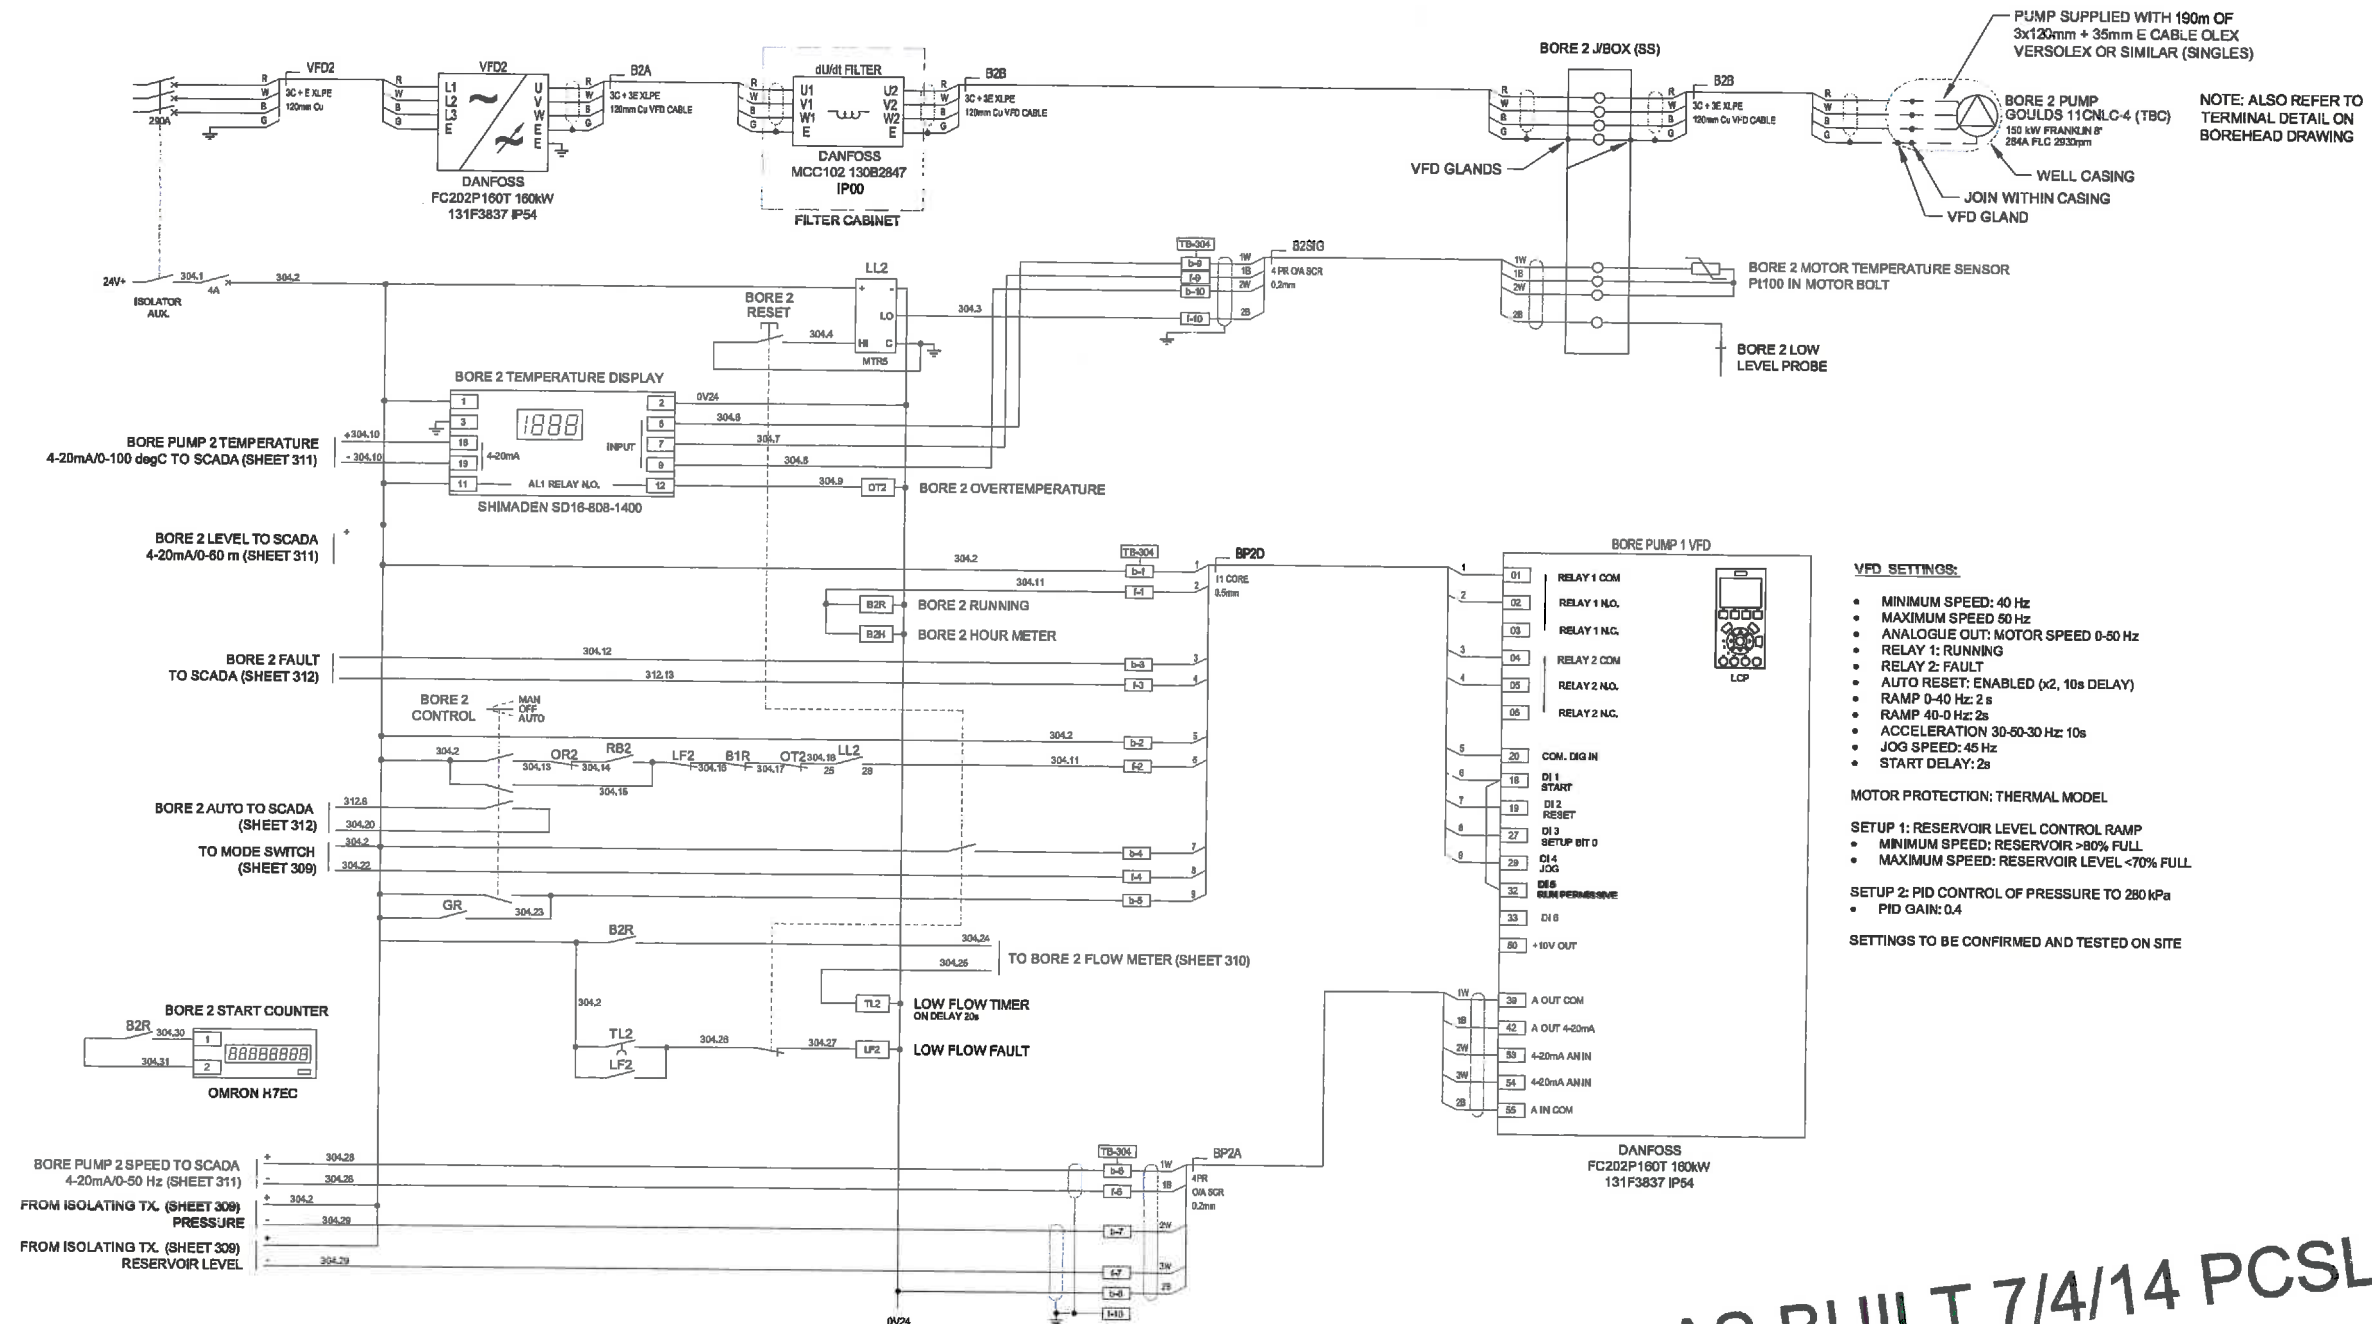

AS BUILT 7/4/14 PCSL

AS BUILT

Revision	Amendment	Approved	Revision Date
RAB	CERTIFIED AS RAB	GB	08/14




Christchurch Environmental
+64 3 363 5400

PO Box 1482
Christchurch 8140
New Zealand

Drawn: GB
Designed: GB
Approved: GB
Revision Date: SEP 2013

Project No: 3C1004.51
Scale: NTS

Project:
SELWYN DISTRICT COUNCIL
DARFIELD WATER SUPPLY UPGRADE
CONTRACT 1133
Sheet:
ELECTRICAL CONTROLS
BORE PUMP 2 CONTROLS
Drawing No: 6/1515/19/7605
Sheet No: 304
Revision: RAB

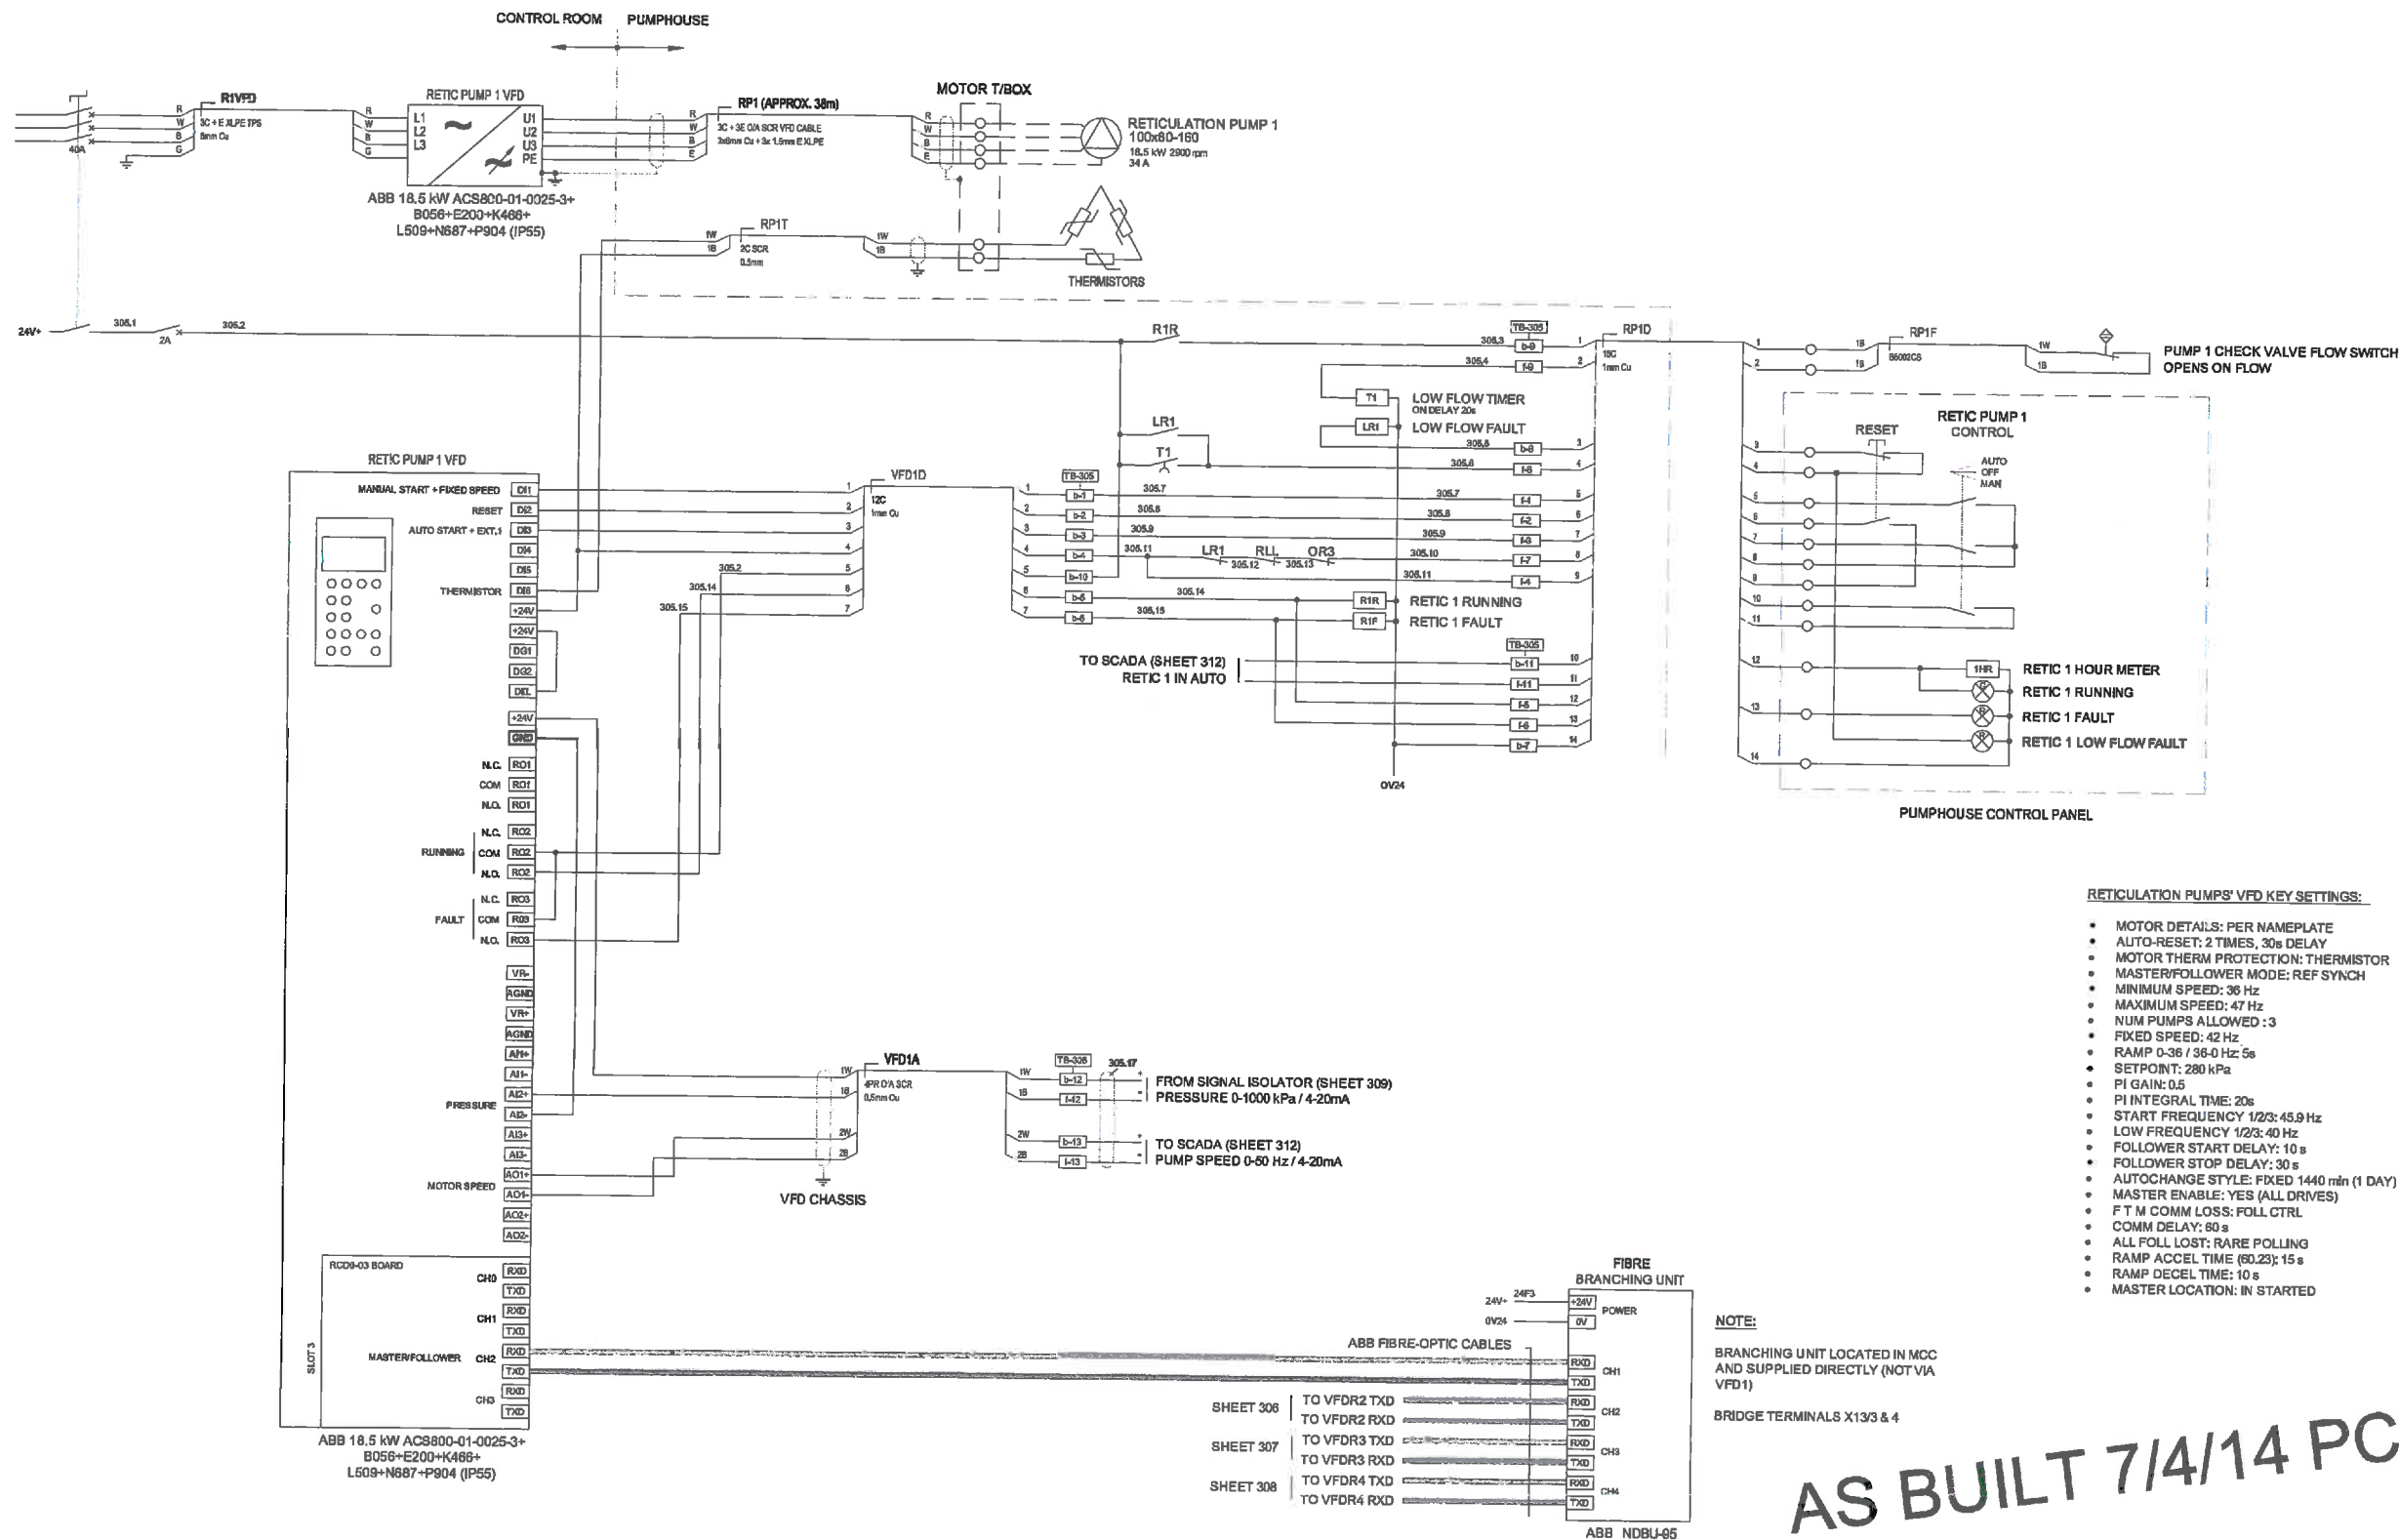


RETICULATION PUMPS' VFD KEY SETTINGS:

- MOTOR DETAILS: PER NAMEPLATE
- AUTO-RESET: 2 TIMES, 30s DELAY
- MOTOR THERM PROTECTION: THERMISTOR
- MASTER/FOLLOWER MODE: REF SYNCH
- MINIMUM SPEED: 36 Hz
- MAXIMUM SPEED: 47 Hz
- NUM PUMPS ALLOWED: 3
- FIXED SPEED: 42 Hz
- RAMP 0-36 / 36-0 Hz: 5s
- SETPOINT: 280 kPa
- PI GAIN: 0.5
- PI INTEGRAL TIME: 20s
- START FREQUENCY 1/23: 45.9 Hz
- LOW FREQUENCY 1/23: 40 Hz
- FOLLOWER START DELAY: 10 s
- FOLLOWER STOP DELAY: 30 s
- AUTOCHANGE STYLE: FIXED 1440 min (1 DAY)
- MASTER ENABLE: YES (ALL DRIVES)
- F T M COMM LOSS: FOLL CTRL
- COMM DELAY: 60 s
- ALL FOLL LOST: RARE POLLING
- RAMP ACCEL TIME (60.23): 15 s
- RAMP DECEL TIME: 10 s
- MASTER LOCATION: IN STARTED

AS BUILT 7/4/14 PCSL

AS BUILT

								AS BUILT		
Revisions		Amendment		Approved		Revision Date				
RAB	CERTIFIED AS RAB		GB		08/14					

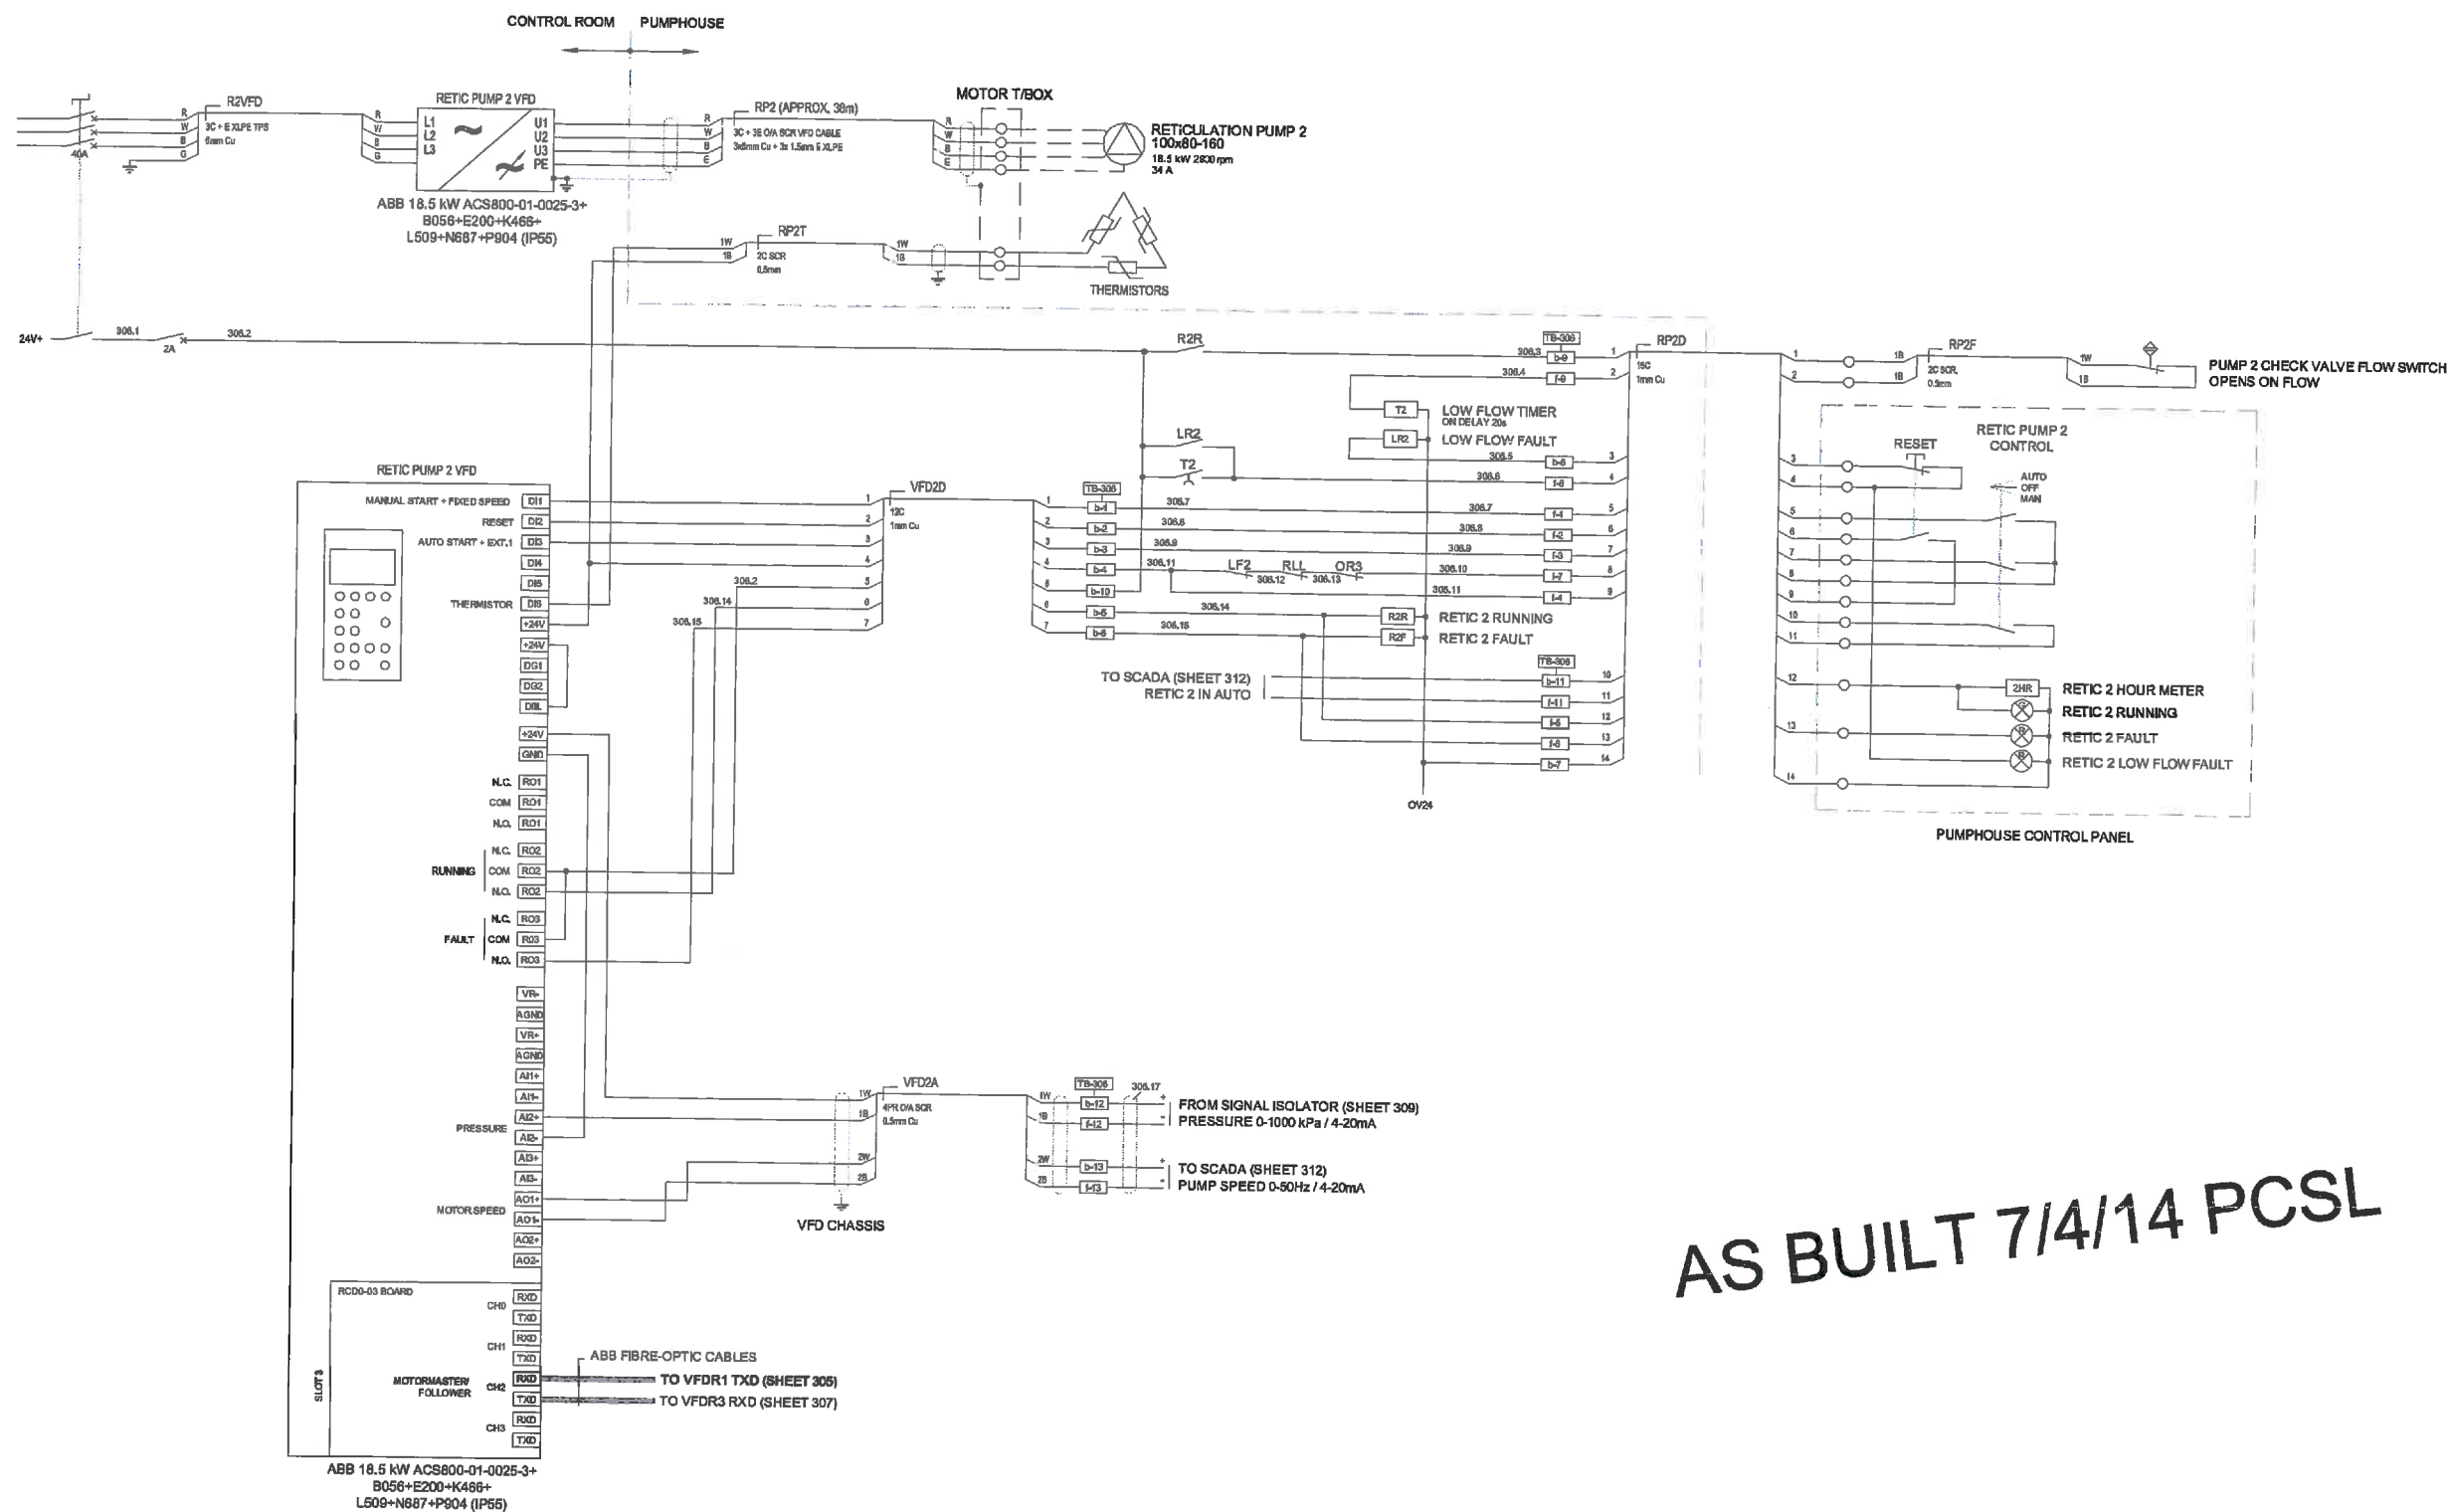

Revision	Amendments	Approved	Rel/On Date
RAB	CERTIFIED ASB	GB	08/14




Christchurch Environmental
+64 3 353 5400

PO Box 1462
Christchurch 8140
New Zealand

Drawn: GB
Designed: GB
Approved: GB
Revision Date: SEP 2013

Project No: 3C1004.51
Scale: NTS

Project	SELWYN DISTRICT COUNCIL DARFIELD WATER SUPPLY UPGRADE CONTRACT 1133
Sheet	ELECTRICAL CONTROLS RETICULATION PUMP 2 CONTROLS
Drawing No.	6/1515/19/7605
Sheet No.	306
Revision	RAB

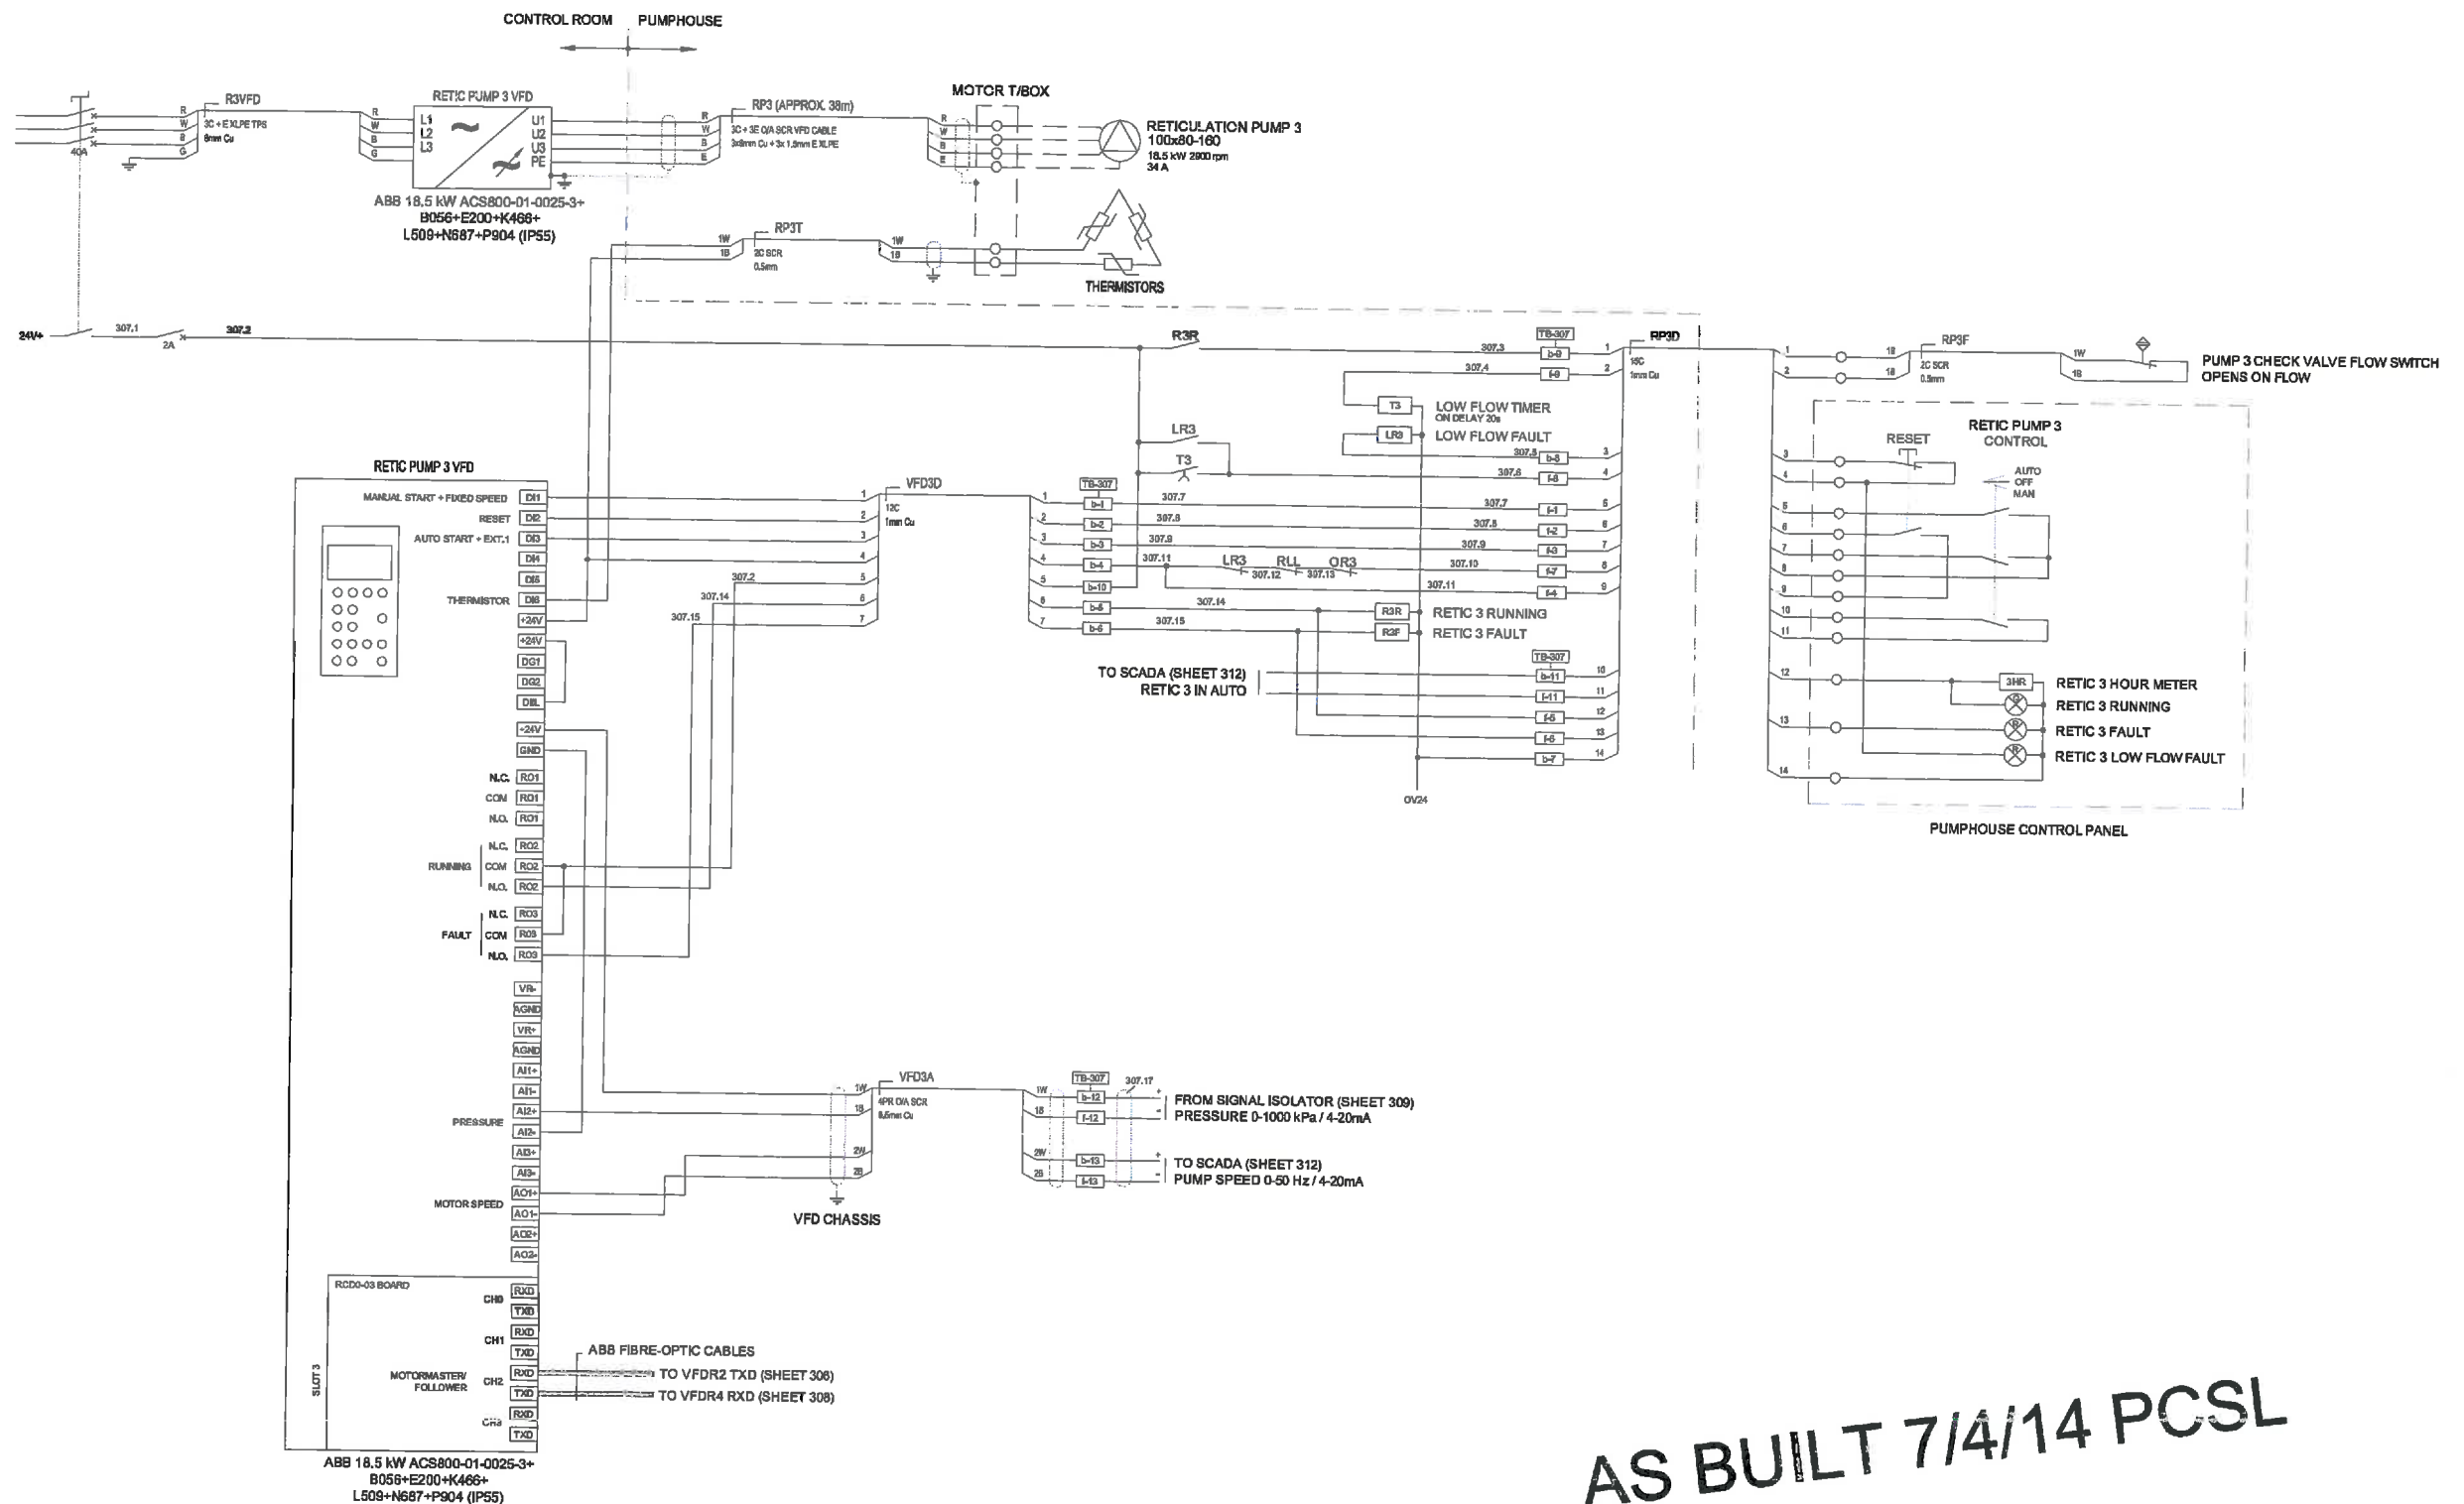

AS BUILT 7/4/14 PCSL

AS BUILT

Revision	Amendment	Approved	Revision Date
RAB	CERTIFIED AS RAB	GB	08/14




SELWYN DISTRICT COUNCIL
DARFIELD WATER SUPPLY UPGRADE
CONTRACT 1133

ELECTRICAL CONTROLS
RETICULATION PUMP 3 CONTROLS

Drawn: GB
Designed: GB
Approved: GB
Revision Date: SEP 2013
Project No: 3C1004.51
Sheet: NTS

Drawing No: 6/1515/19/7605

Sheet No: 307
Revision: RAB

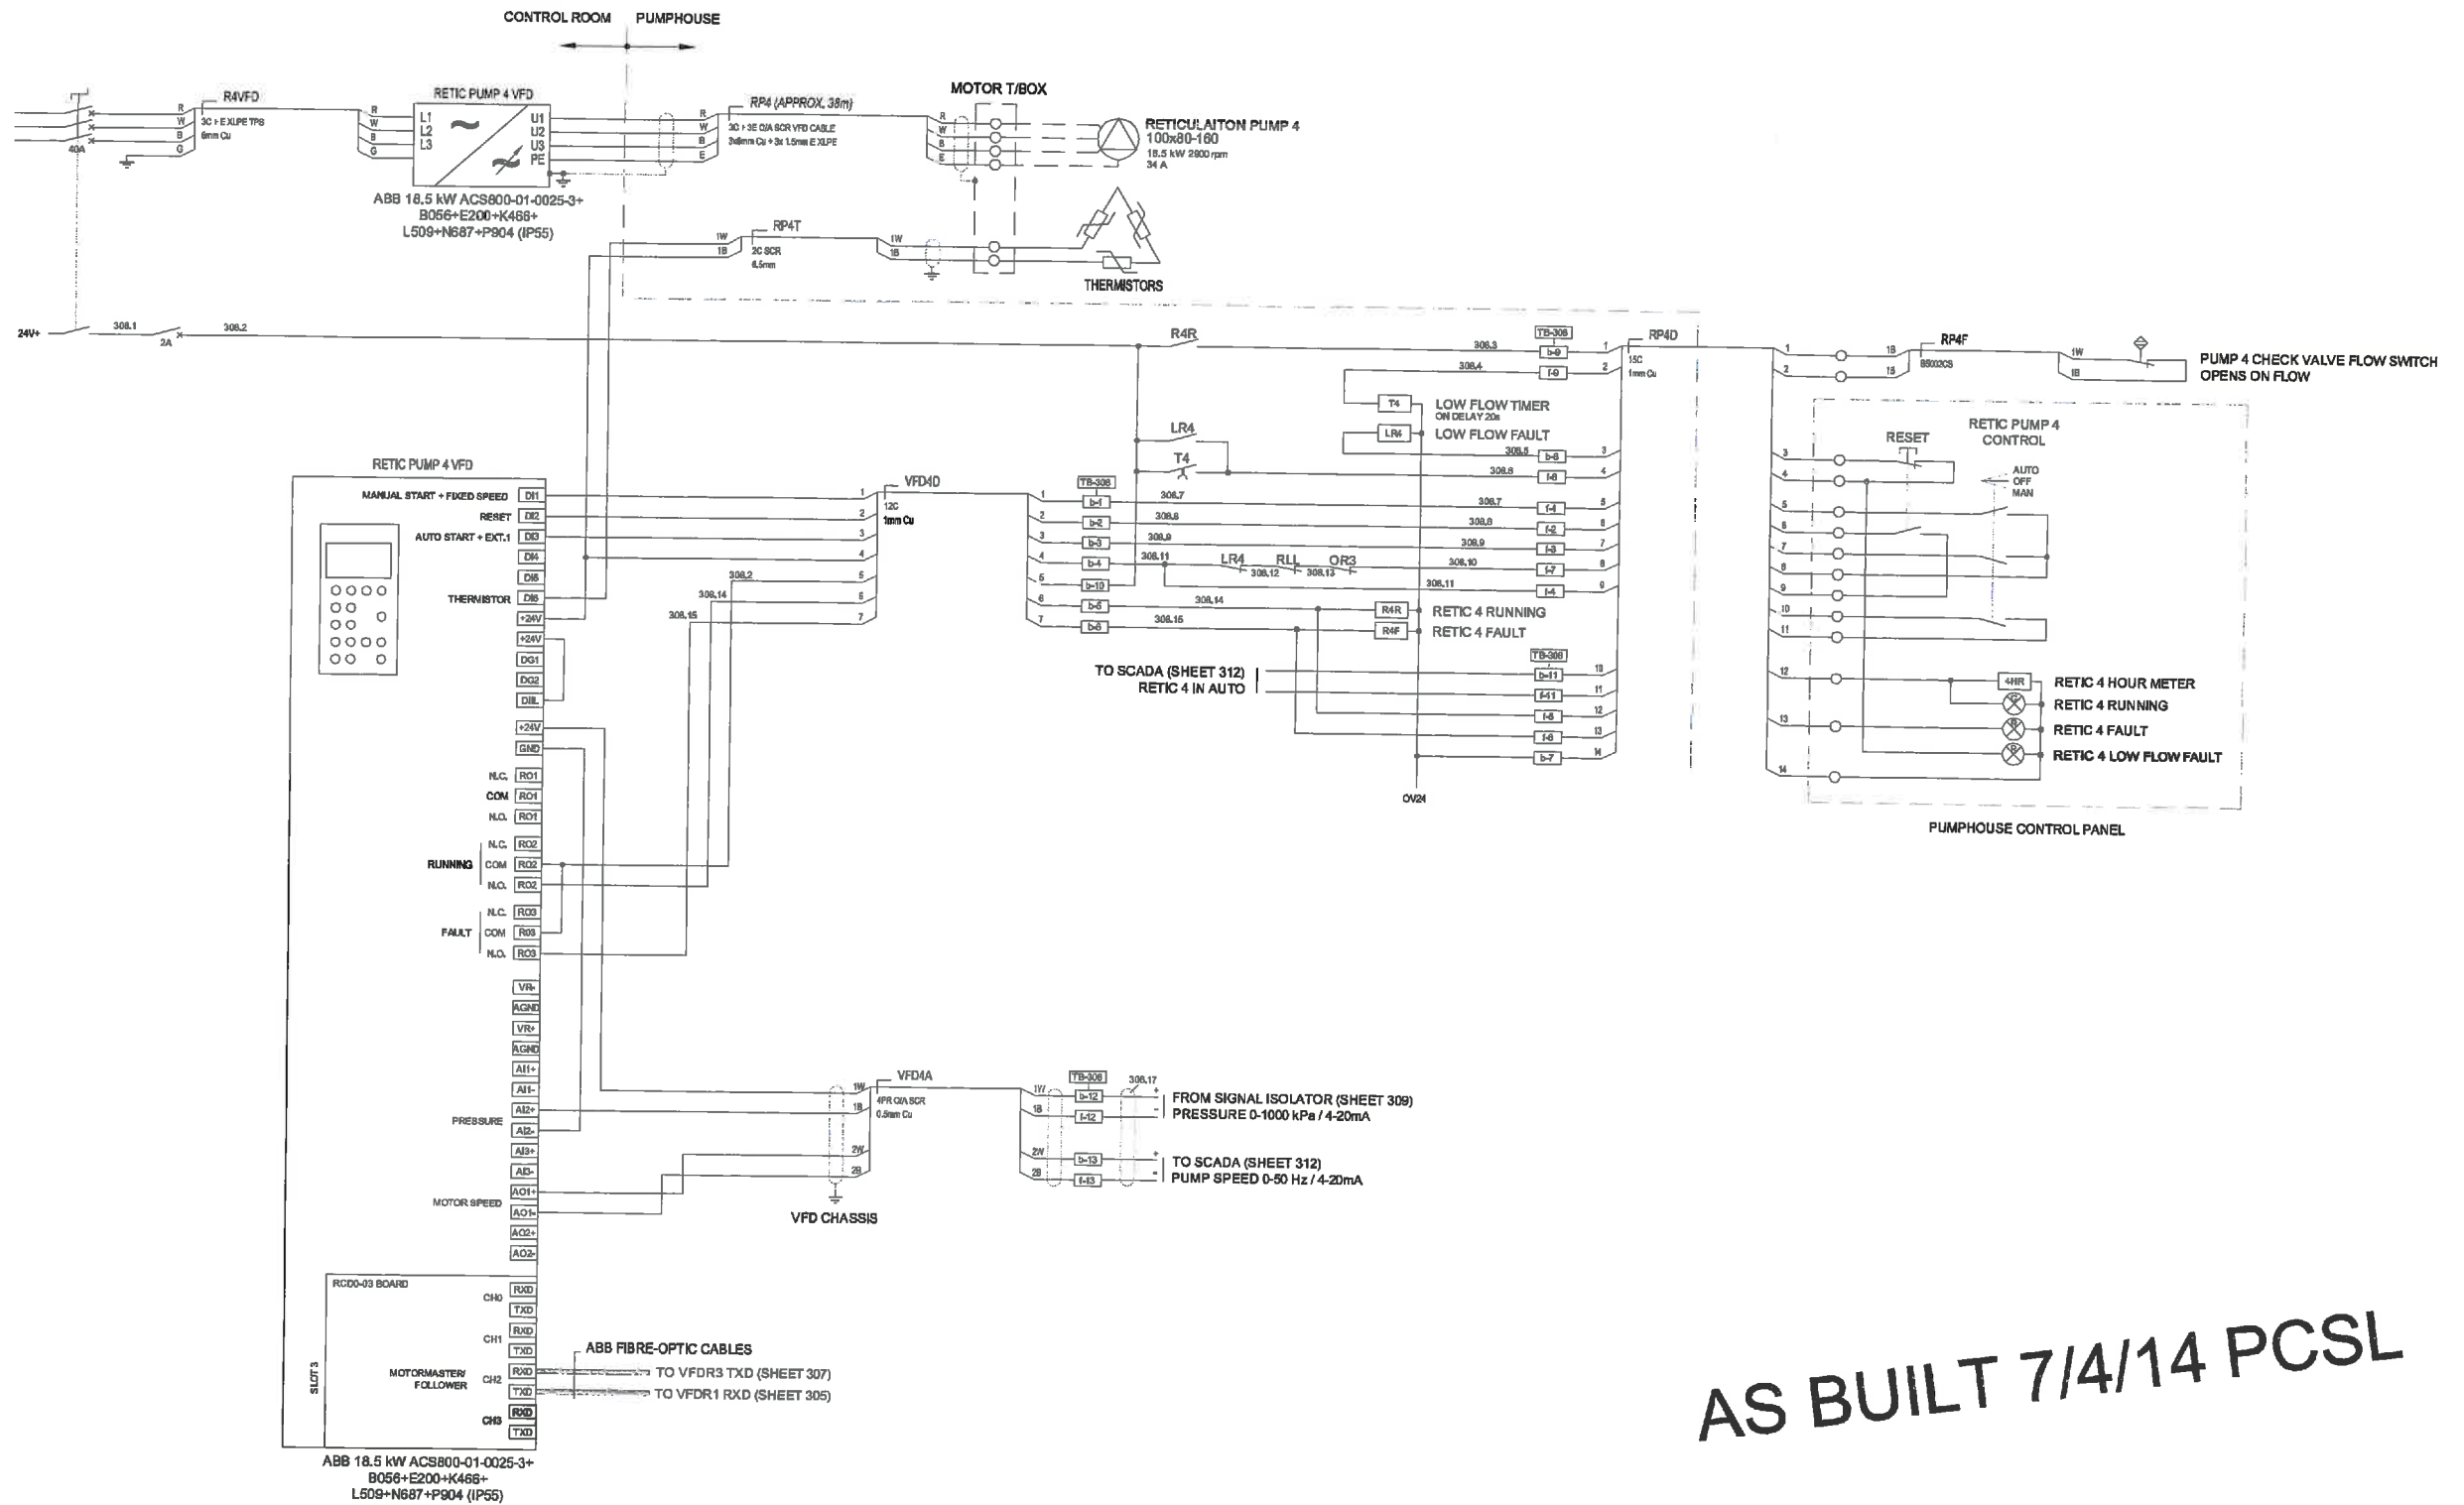


Revision	Description	Approved	Revision Date
RAB	CERTIFIED AS BUILT	GB	06/14



Drawn	Designed	Approved	Revision Date
GB	GB		SEP 2013
Project No.			
3C1004.51			

Project	
SELWYN DISTRICT COUNCIL DARFIELD WATER SUPPLY UPGRADE CONTRACT 1133	
Sheet	
ELECTRICAL CONTROLS RETICULATION PUMP 4 CONTROLS	
Drawn By	
6/1515/19/7605	
Sheet No.	
308	
Revision	
RAB	

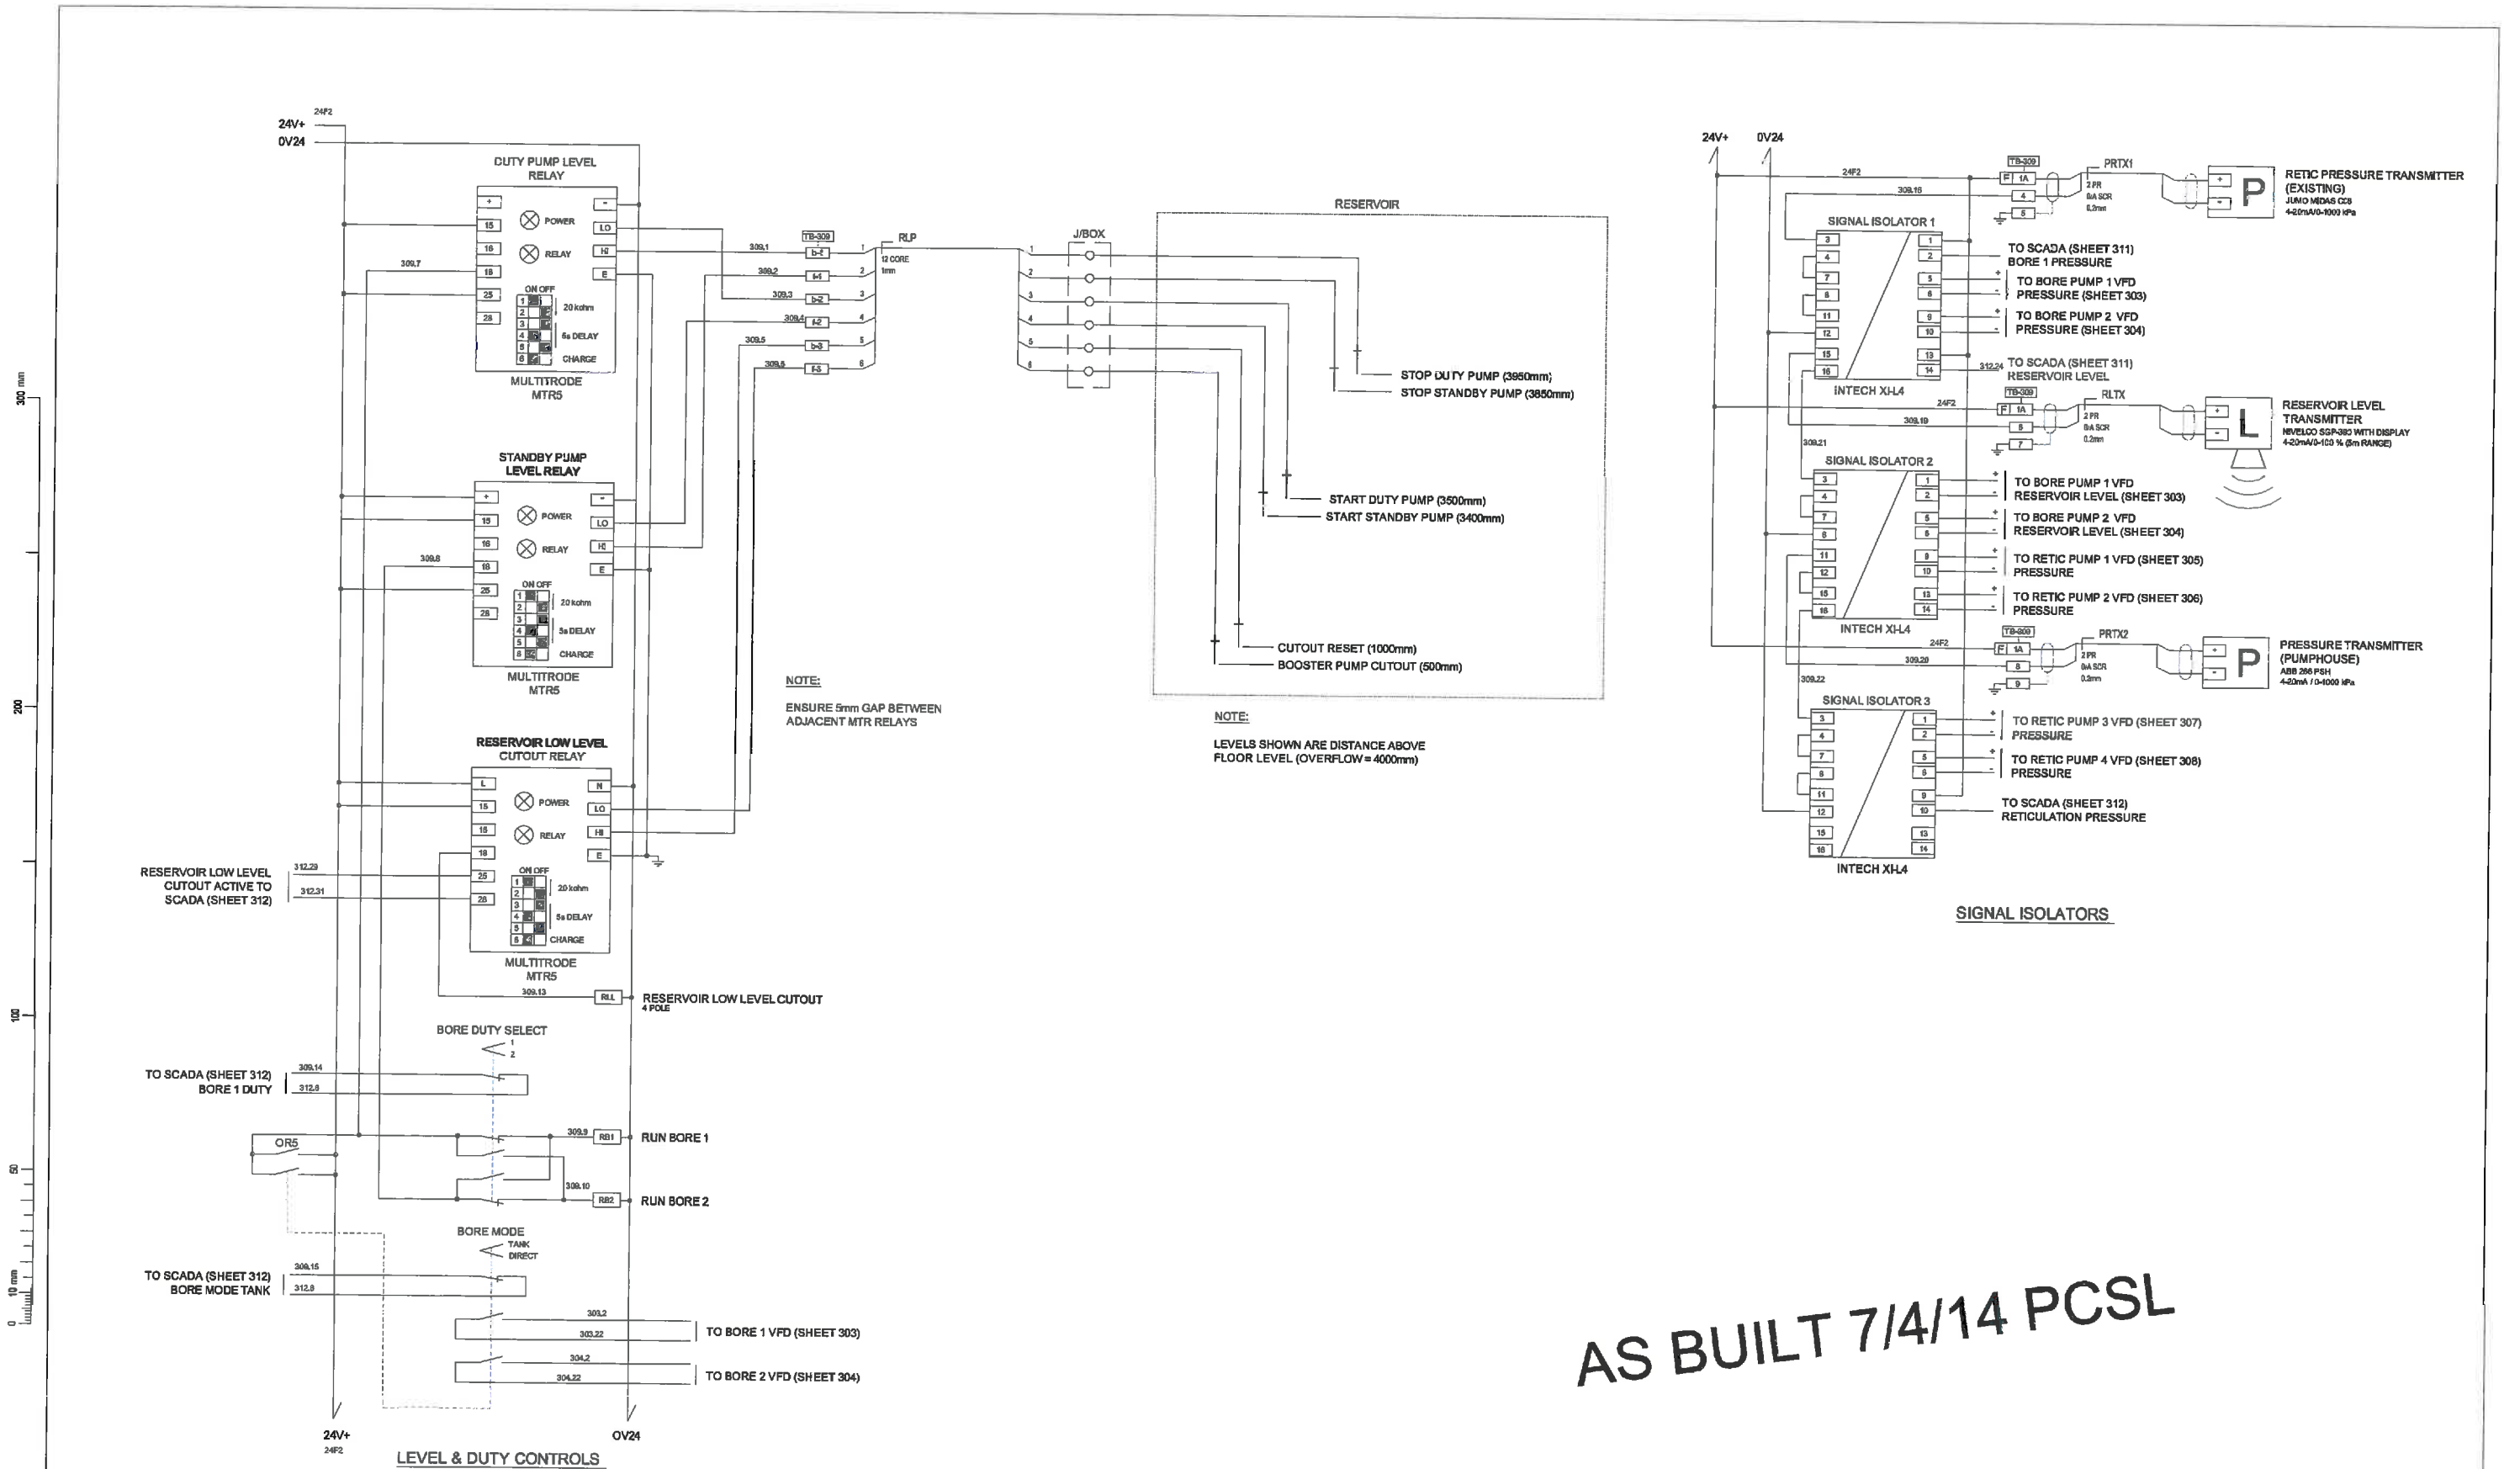

Revision	Amendment	Approved	Revision Date
RAB	CERTIFIED AS/RAB	GB	08/14



Drawn	Designed	Approved	Revision Date
GB	GB		JAN 2014
Project No.	Scale		
3C1004.51	NTS		

Project	Sheet
SELWYN DISTRICT COUNCIL DARFIELD WATER SUPPLY UPGRADE CONTRACT 1133	ELECTRICAL CONTROLS LEVEL & DUTY CONTROLS
6/15/15/19/7605	309
	RAB

AS BUILT



TURBIDIMETER

TURBIDITY METER (EXISTING)

TO SCADA (SHEET 312)
TURBIDIMETER FALT

TO SCADA (SHEET 311)
TURBIDITY 0-50 NTU / 4-20 mA


TO SCADA (SHEET 311)
TURBIDITY SERVICE

FROM SCADA (SHEET 311)
TURBIDITY SERVICE LAMP

EXISTING JBOX

AS BUILT 7/4/14 PCSL

Sheet No.	Revision
310	RAB

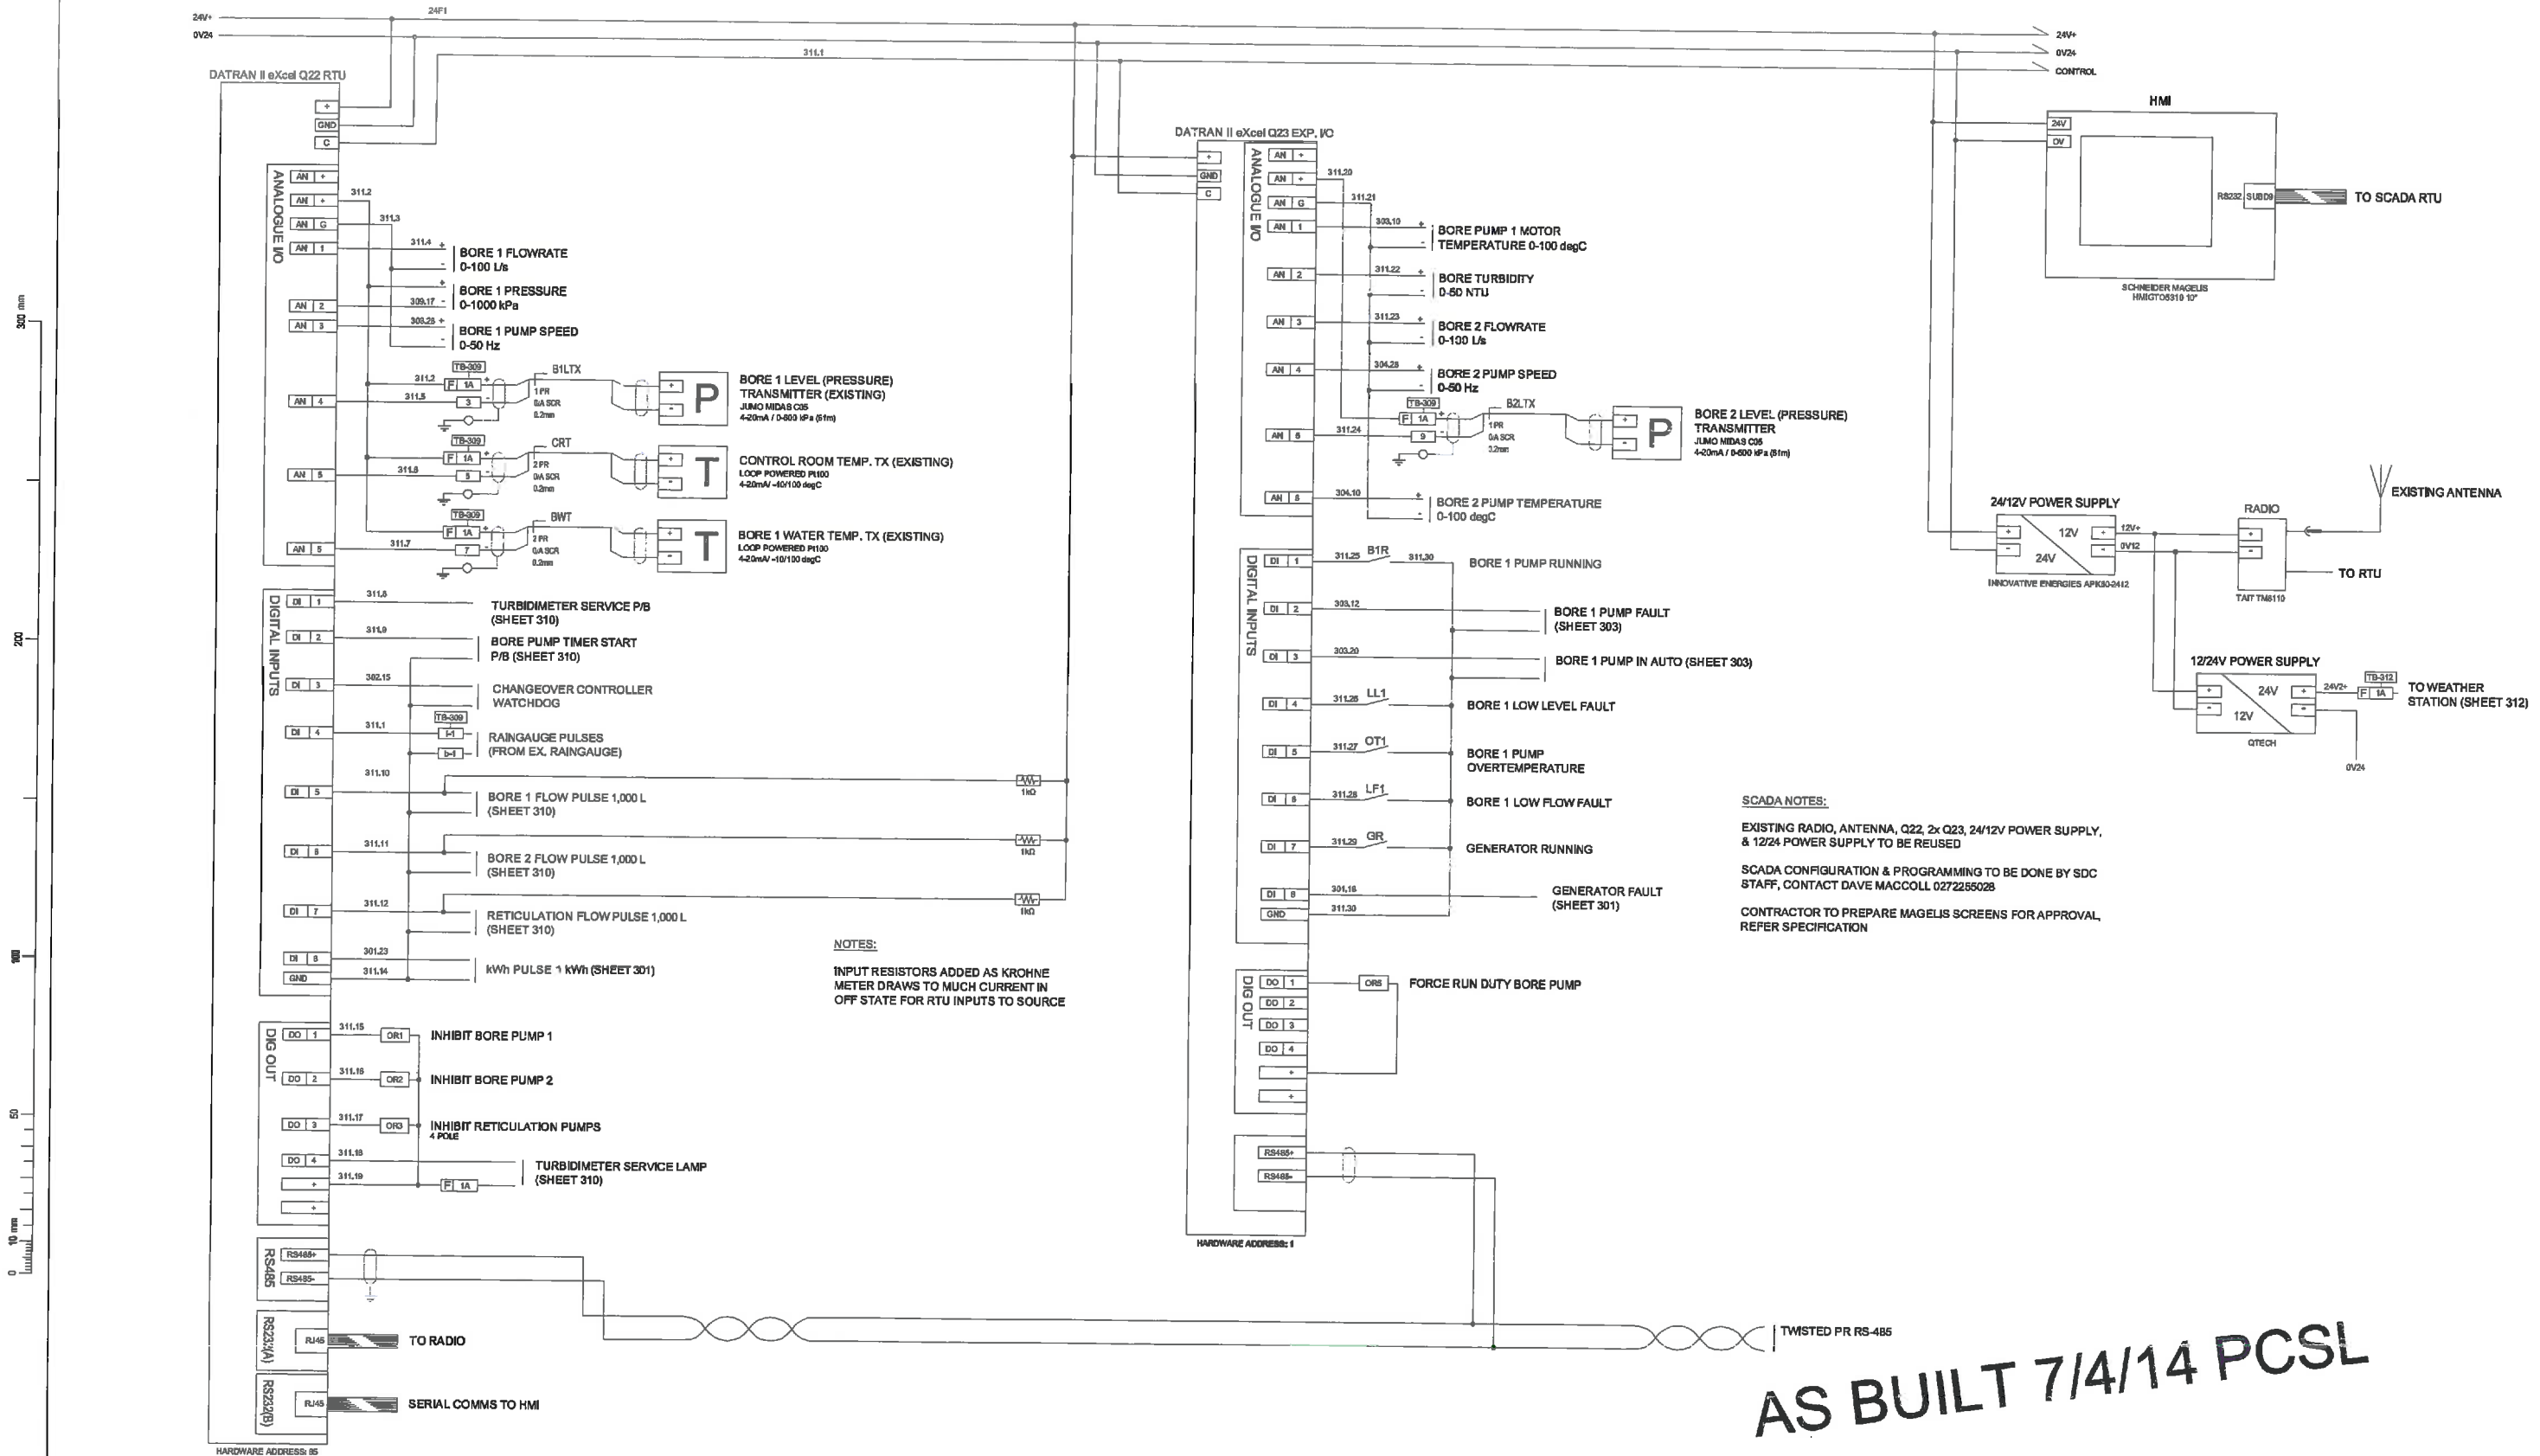

NOTES:

INPUT RESISTORS ADDED AS KROHN METER DRAWS TOO MUCH CURRENT IN OFF STATE FOR RTU INPUTS TO SOURCE

Revision	Approved	Approved	Revision Date
RAB	CERTIFIED AS RAB	GB	08/14



OPUS
Christchurch Environmental
PO Box 1482
Christchurch 8140
New Zealand

SELWYN DISTRICT COUNCIL
DARFIELD WATER SUPPLY UPGRADE
CONTRACT 1133


ELECTRICAL CONTROLS
SCADA CONTROLS 1


Drawn: GB
Checked: GB
Approved: GB
Revision Date: JAN 2014
Project No: 3C1004.51
Scale: NTS

Drawn: 6/1515/19/7605


AS BUILT

Sheet No: 311
Revision: RAB

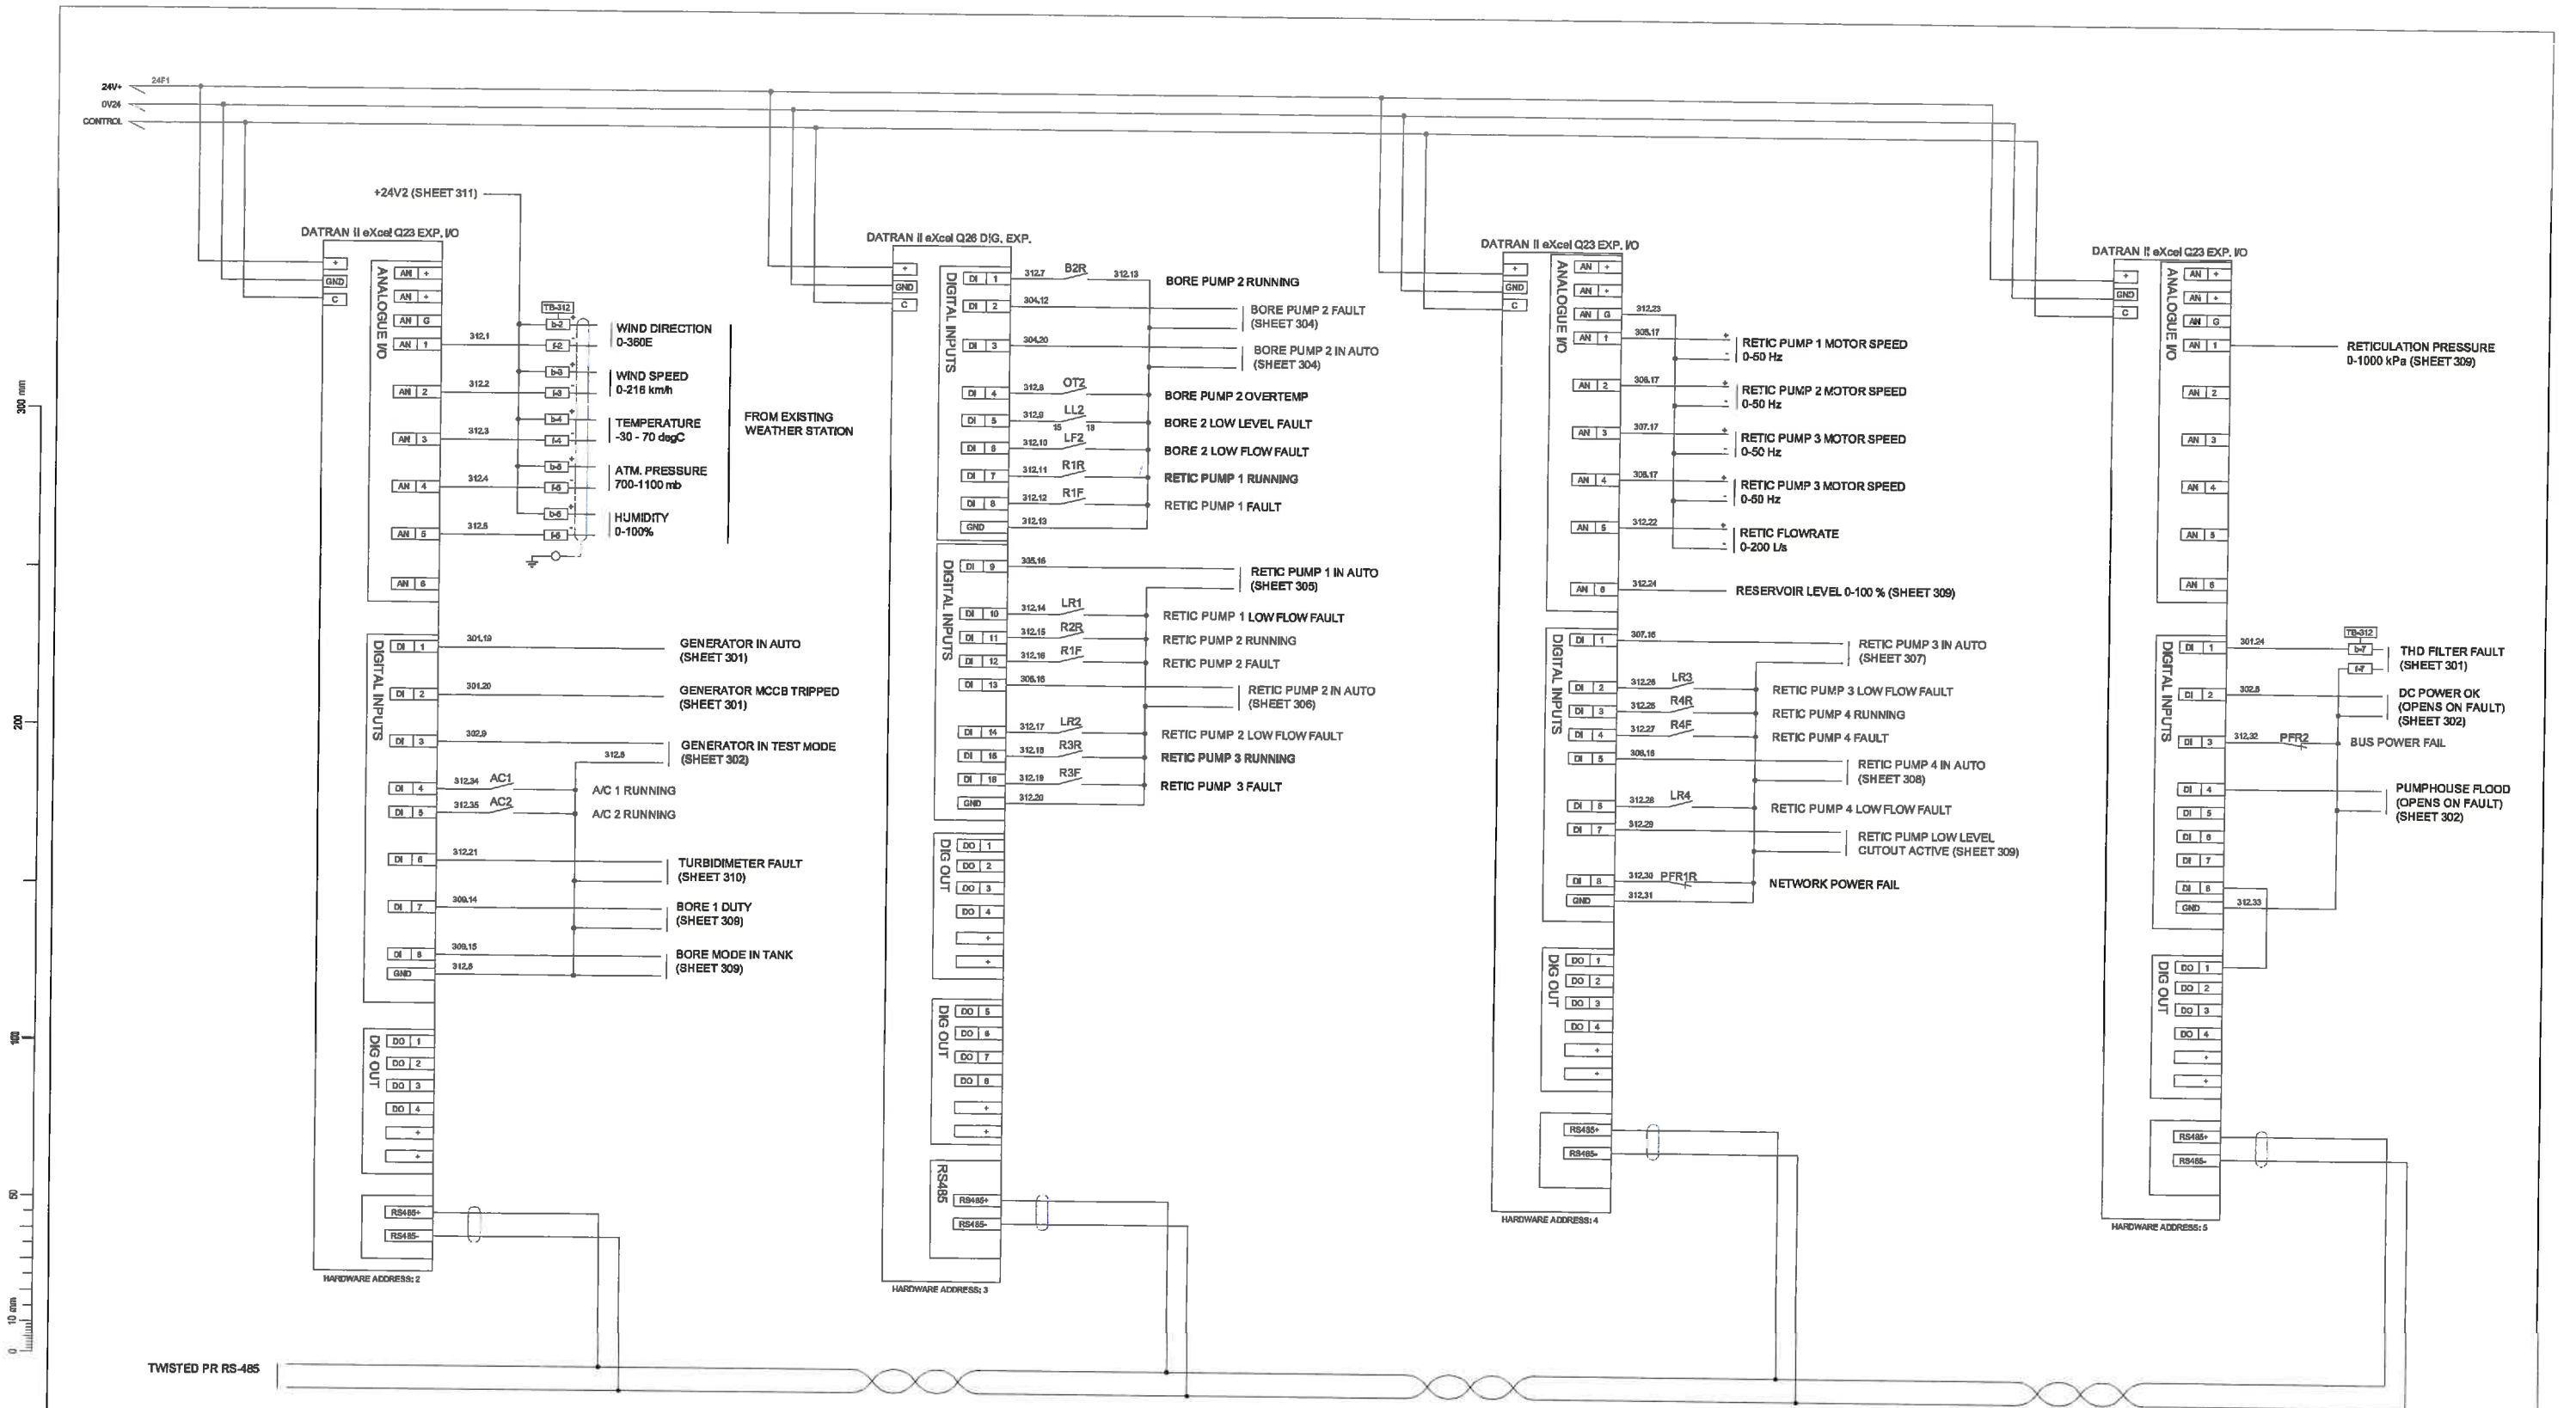

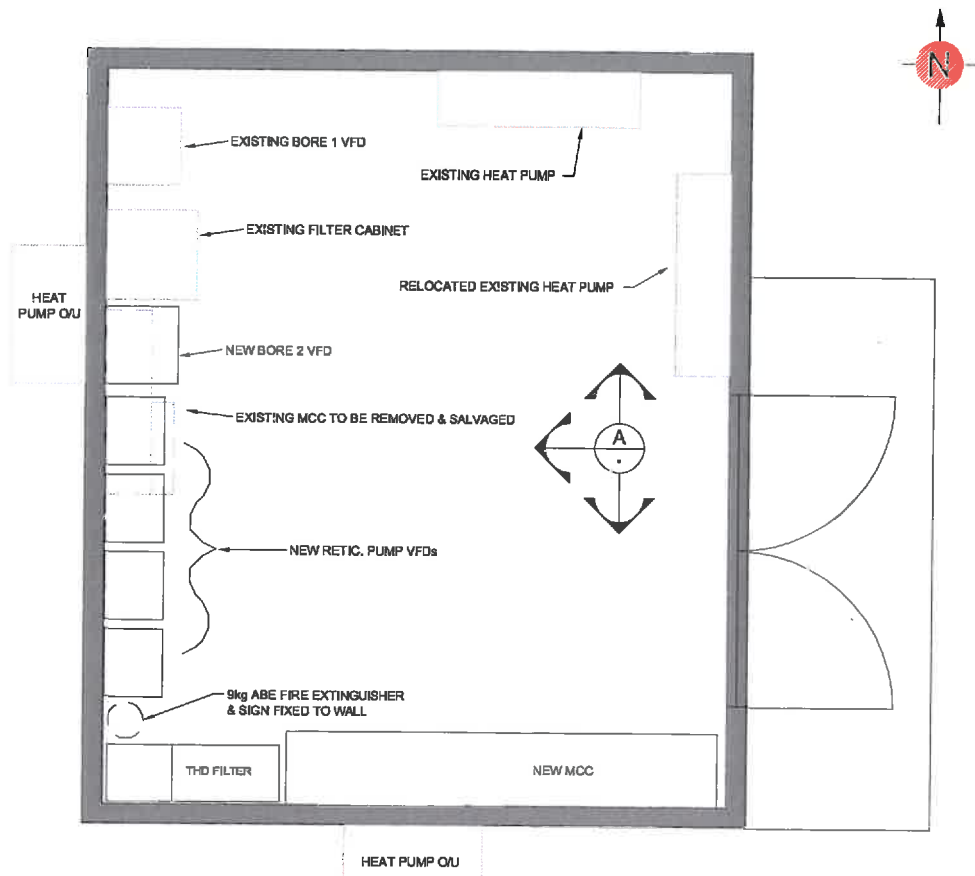

CONTROL ROOM PLAN
Scale: 1:20

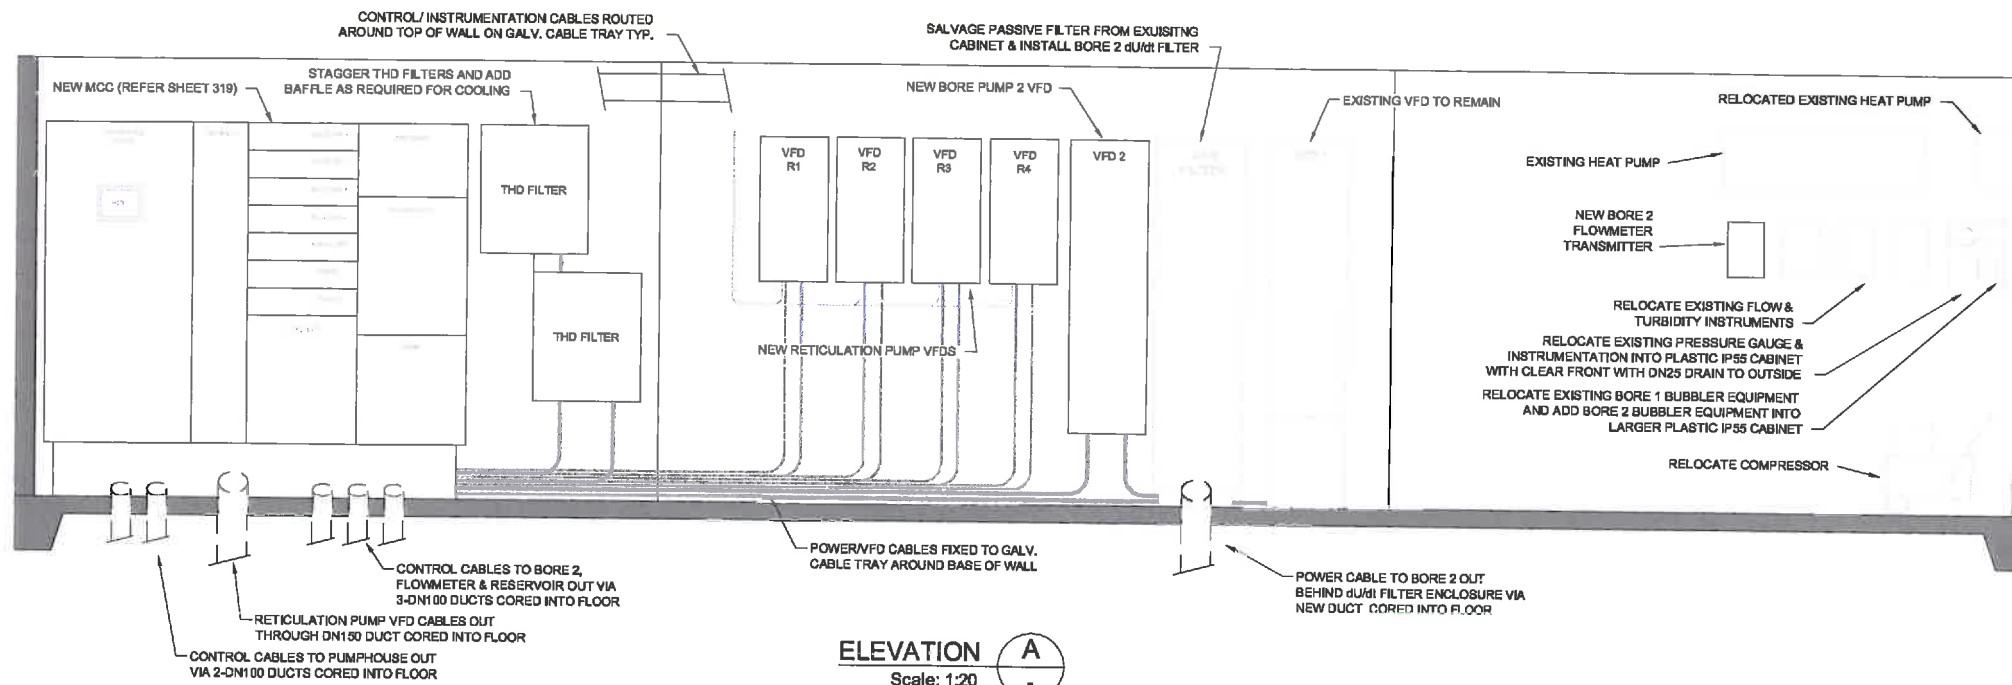

ELEVATION A
Scale: 1:20

AS BUILT
CERTIFIED BY: *[Signature]*
DESIGNATION: *[Signature]*
DATE: 2-17-2014


Revision	Amendment	Approval	Revision Date
RAB	CERTIFIED AS RAB		05/14



Drawn	Designed	Approved	Revision Date
GB	GB		MAY 2014
Project No.	Scale	Drawing No.	
3C1004.51	AS SHOWN (A1)	6/1515/19/7605	


Project	SELWYN DISTRICT COUNCIL DARFIELD WATER SUPPLY UPGRADE CONTRACT 1133
Sheet	CONTROL BUILDING LAYOUT MODIFICATIONS
Sheet No.	300
Revision	RAB

**SUPERSEDED - REFER APPENDIX B: POWER
CONTROLS DRAWINGS**

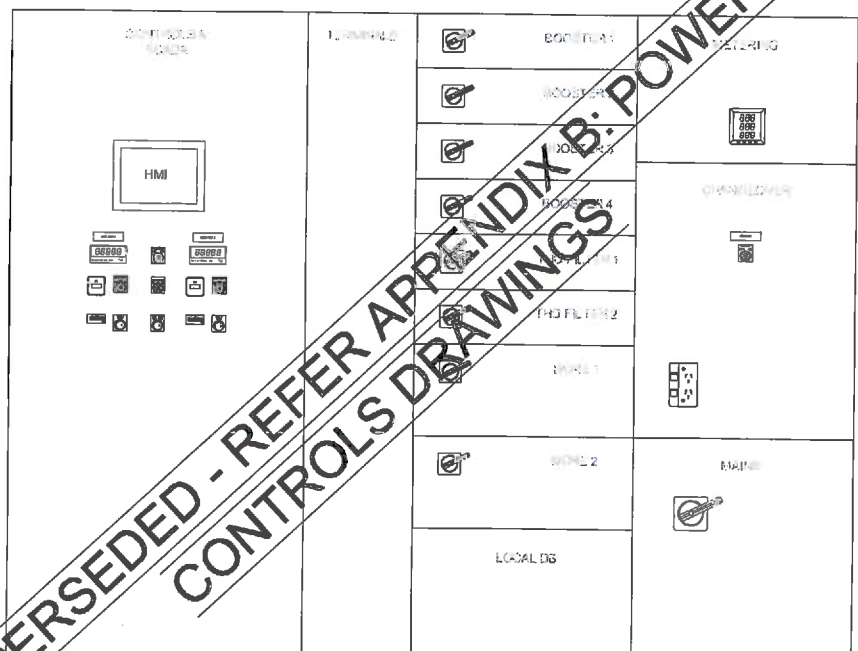


NOTE:
ROOM ACCESS IS LIMITED TO 1700x1800 DOOR
OPENING. PANEL TO BE CONSTRUCTED IN
SECTIONS TO SUIT AND ASSEMBLED ON SITE IF
REQUIRED.
CONTRACTOR TO SUBMIT PANEL DESIGN FOR
APPROVAL PRIOR TO COMMENCING
MANUFACTURE

MSB/MCC ELEVATION
Scale: 1:20

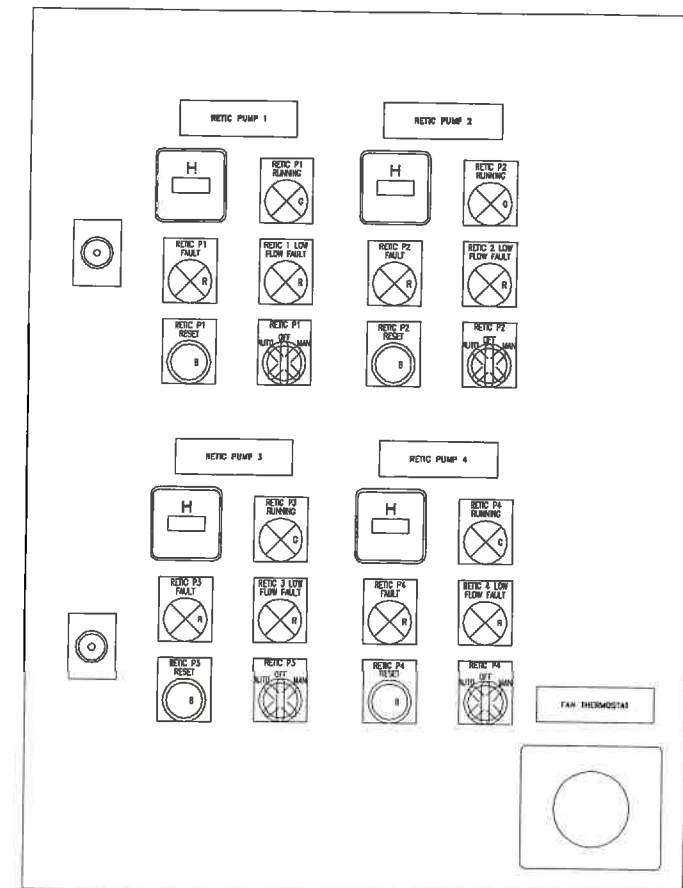

PUMPHOUSE CONTROL PANEL
Scale: 1:2.5

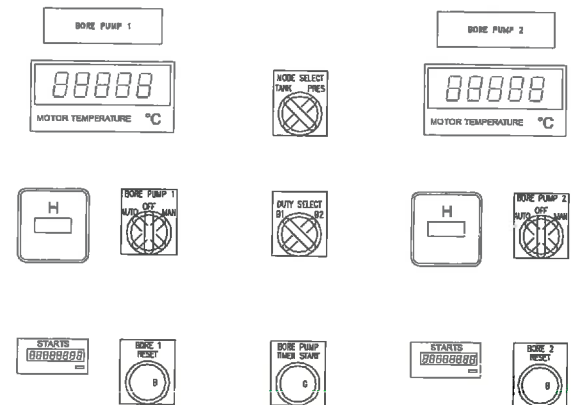

MCC CONTROLS DETAIL
Scale: 1:2.5

AS BUILT
CERTIFIED BY: *[Signature]*
DESIGNATION: *[Signature]*
DATE: *21/12/2014*

Revision	Approved	Approved	Revision Date
RAB	CERTIFIED AS RAB	GB	08/14






OPUS
Christchurch Environmental
PO Box 1482
Christchurch 8140
New Zealand

Drawn: GB
Designed: GB
Approved: GB
SEP 2013

Project No: 3C1004.51
Scale: AS SHOWN (A1)

Project: SELWYN DISTRICT COUNCIL DARFIELD WATER SUPPLY UPGRADE CONTRACT 1133	
Sheet: MSB/MCC & PUMPHOUSE CONTROL PANEL INDICATIVE LAYOUTS	
Design No: 6/1515/19/7605	Sheet No: 319
Rev: 01	Rev: 01

AS BUILT

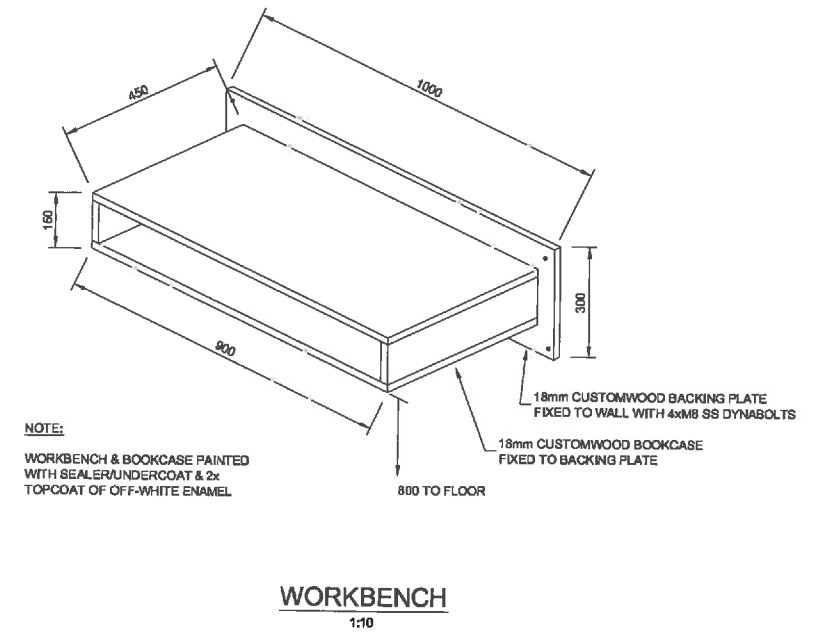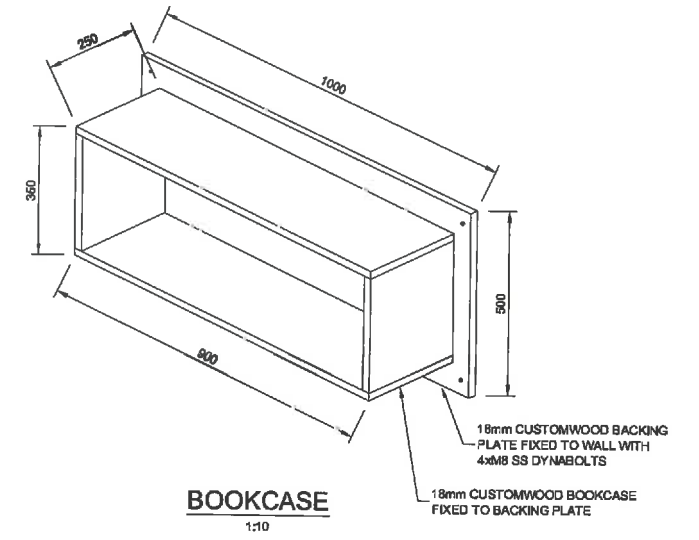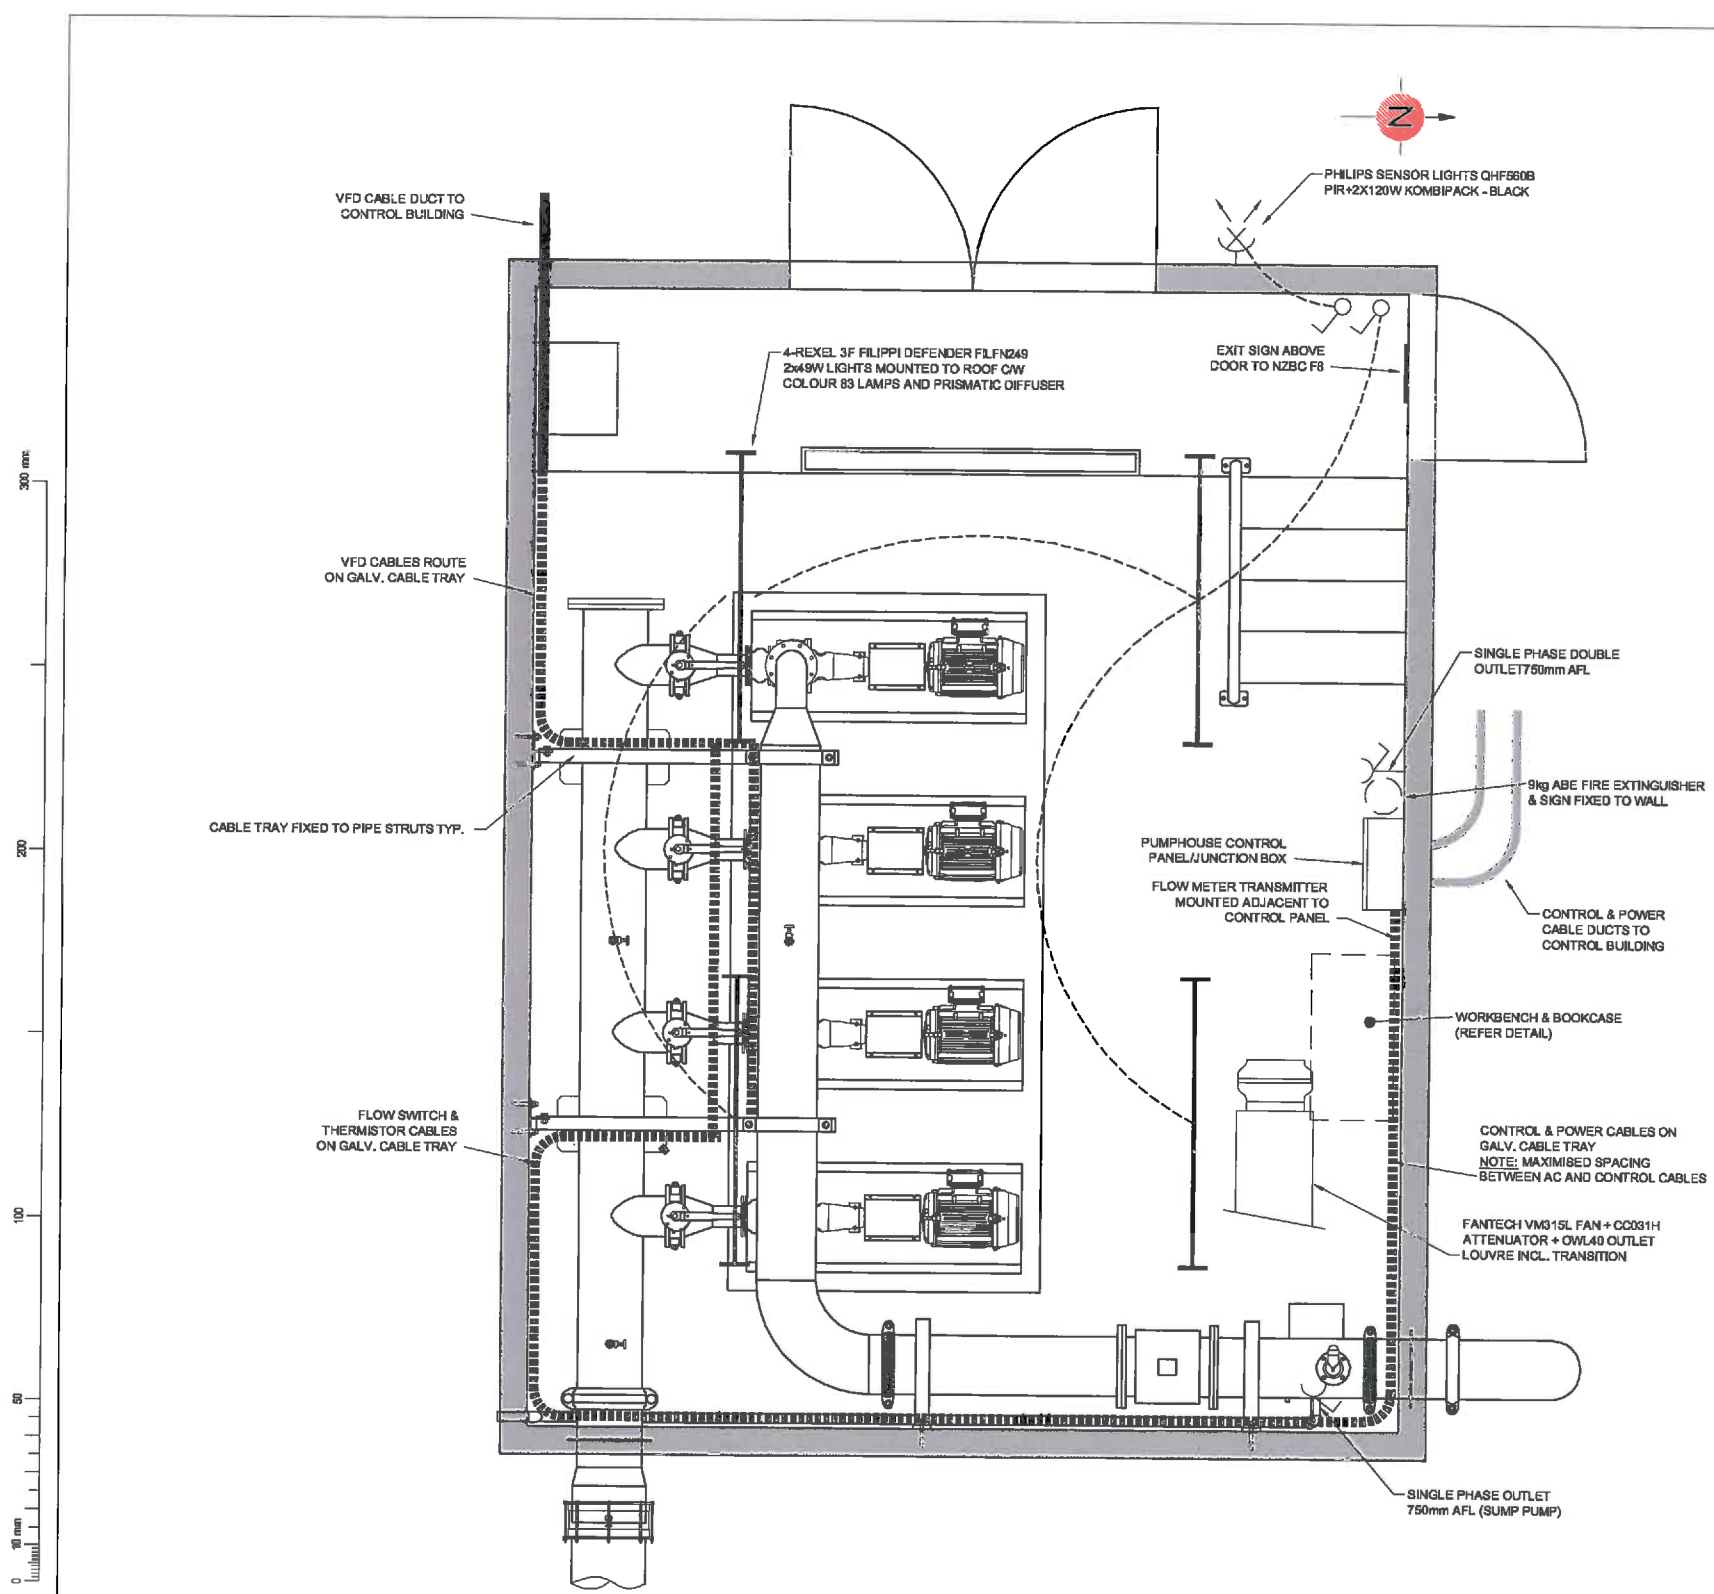

AS BUILT

CERTIFIED BY: *[Signature]*

DESIGNATION: *[Signature]*

DATE: 2/17/2014

Revision	Amendment	Approved	Revision Date
RAB	CERTIFIED AS RAB	GB	08/14



OPUS
Christchurch Environmental
+64 3 383 5400
PO Box 1482
Christchurch 8140
New Zealand

Project	SELWYN DISTRICT COUNCIL DARFIELD WATER SUPPLY UPGRADE CONTRACT 1133		
Sheet	PUMPHOUSE LIGHTING & CABLING DETAILS		
Project No.	3C1004.51	Scale	AS SHOWN (A1)
Drawing No.	6/1515/19/7605	Sheet No.	320
Revision	RAB		

DRAWING SHEET LIST			
Sheet Number	Sheet Name	Current Revision	Current Revision Date
001	CIVIL NOTES	C	24-03-2014
002	STRUCTURAL NOTES - CONCRETE / MASONRY	C	24-03-2014
C001	SITE PLAN	C	24-03-2014
S100	FLOOR PLAN	D	24-03-2014
S101	ROOF PLAN	D	24-03-2014
S200	SECTIONS	D	24-03-2014
S300	DETAILS	C	24-03-2014
S301	DETAILS	C	24-03-2014
S302	DETAILS	D	24-03-2014


CONCRETE STRUCTURES (NZ) LTD

DARFIELD WATER SUPPLY UPGRADE

AS BUILT
CERTIFIED BY: 
DESIGNATION: Civil Manager CSZ
DATE: 21/4/14

Project No. J3182

AS BUILT

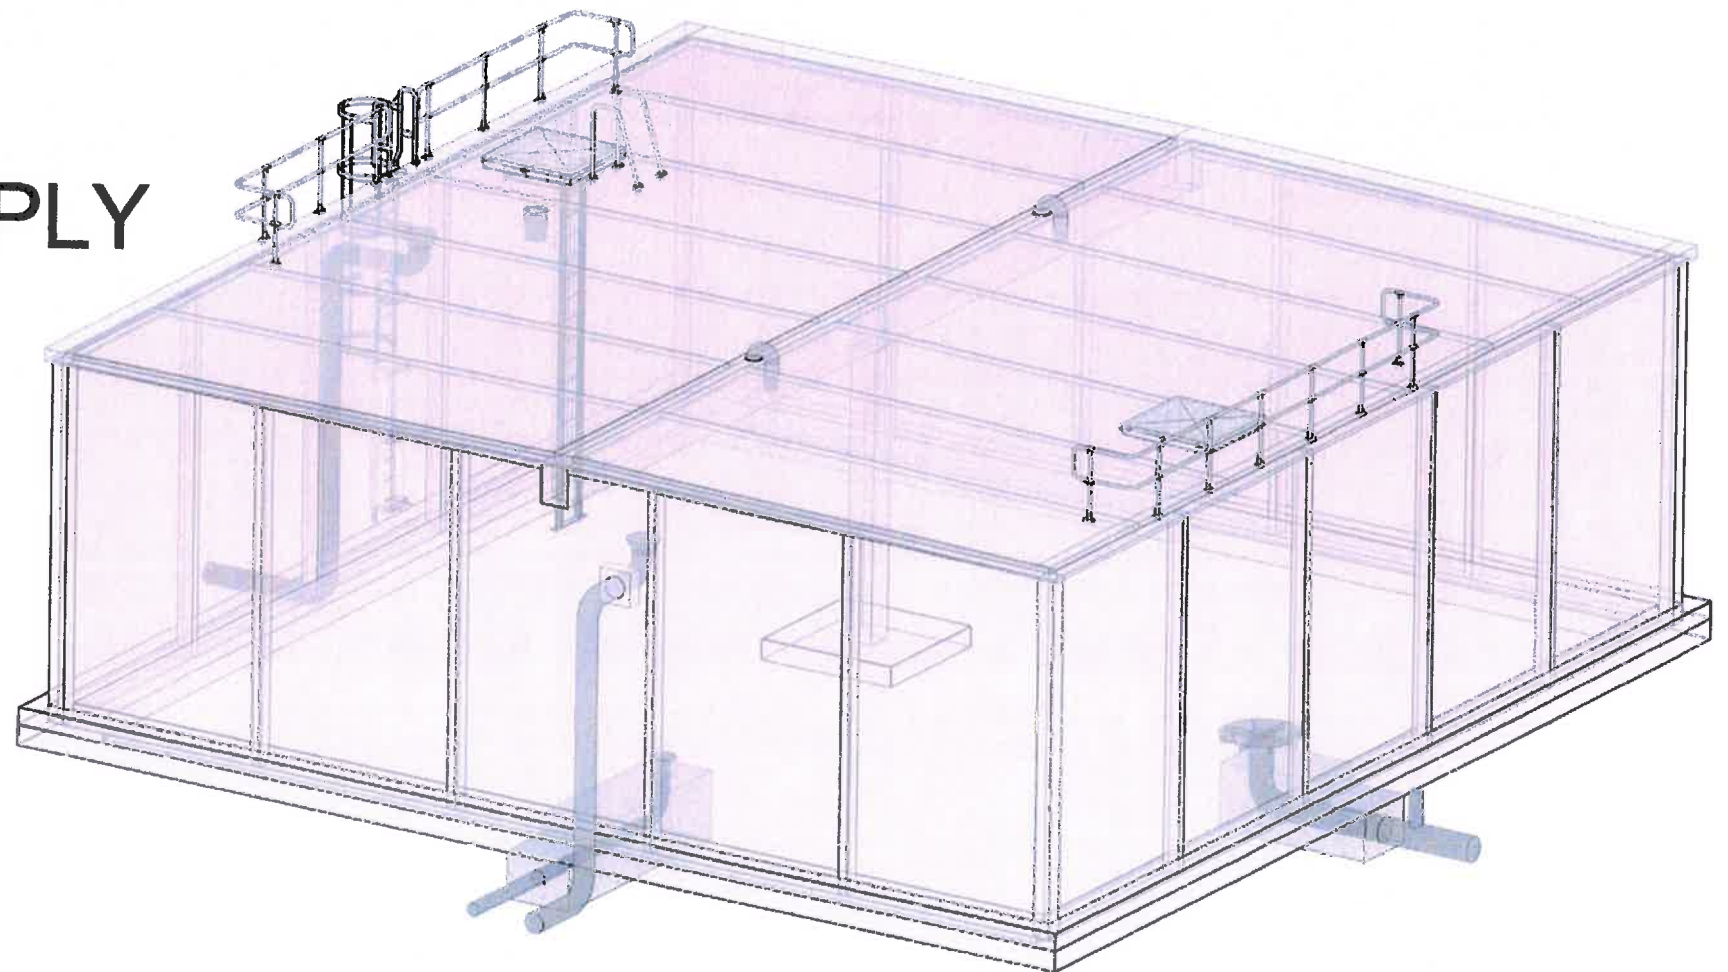

24-03-2014

P 06 876 7646
F 06 876 7645
email info@stratagroup.net.nz

Structural

Fire

Geotechnical

Civil

Strategic Planning

PO Box 758
212 Queen St. East
Hastings, New Zealand

All drawings have been created in electronic format with the intention of printing relevant 'layouts' sheets. It is a condition under which this electronic data is supplied that you are responsible for verifying its correctness and completeness. You are strongly advised to check this electronic data against all relevant documents and by confirming dimensions on site. Our Company cannot be held responsible for the accuracy of the electronic data within your CAD system after translation. You are advised to use the translated drawings only as background data. We accept no responsibility for any loss or damage suffered by your company as a result of use or misuse of this data.

THE CONTRACTOR IS TO BE AWARE OF ALL INSPECTIONS TO BE MADE BY THE ENGINEER, AS A REQUIREMENT OF THE PRODUCER STATEMENT PS-1 CONSTRUCTION REVIEW DOCUMENTATION, & NOTIFY THE ENGINEER WHEN ALL STRUCTURAL ELEMENTS ARE READY TO BE INSPECTED

GENERAL

1. ALL WORK IS TO COMPLY WITH THE NZ BUILDING CODE.
2. BOUNDARY INFORMATION SHOWN SUPPLIED BY _____
3. LEVEL DATUM = HB DATUM.
4. COORDINATES IN TERMS OF HB2000 DATUM.
5. ALL WORK IS TO BE SET OUT BY A REGISTERED SURVEYOR.
6. ALL MEASUREMENTS ARE TO BE CONFIRMED ON SITE. ANY DISCREPANCIES BETWEEN THE SITE MEASURES AND THE DRAWINGS ARE TO BE BROUGHT TO THE ATTENTION OF THE DESIGNER AT THE EARLIEST CONVENIENCE.
7. ALL UNDERGROUND SERVICES SHOWN ON THE DRAWINGS ARE INDICATIVE ONLY. IT IS THE RESPONSIBILITY OF THE CONTRACTOR TO CONTACT THE RELEVANT NETWORK UTILITY PROVIDERS TO HAVE THE SERVICES MARKED ON SITE. ALL CRITICAL SERVICES SHOULD BE PROTECTED BY THE CONTRACTOR PRIOR TO COMMENCING WORK.

STORMWATER

1. ALL UPVC PIPES ARE TO BE STIFFNESS CLASS SN8 UNLESS STATED OTHERWISE ON THE PLANS.
2. ALL CONCRETE PIPES ARE TO BE CLASS X RCRH UNLESS STATED OTHERWISE ON THE PLANS.
3. ALL SINGLE SUMPS TO HAVE 225 DIA RCRH LATERAL.

SANITARY SEWER

1. ALL UPVC PIPES ARE TO BE STIFFNESS CLASS SN8 UNLESS STATED OTHERWISE ON THE PLANS.
2. ALL CONCRETE PIPES ARE TO BE CLASS X RCRH UNLESS STATED OTHERWISE ON THE PLANS.

WATER

1. WATER BORE AND RELATED SERVICES DESIGN BY OTHERS.

LEGEND

1 ABBREVIATIONS USED ON THE PLANS

SW STORMWATER	K+C CONCRETE KERBS AND CHANNEL
SS SANITARY SEWER	AC/ASPHALTIC CONCRETE
W WATER	TOR TOP OF BANK
TW TRADE WASTE	BOB BOTTOM OF BANK
FH FIRE HYDRANT	FOI FIRE OPTIC
SV SERVICE VALVE	TP TANGENT POINT
GV GATE VALVE	CTP COMMON TANGENT POINT
EOS EDGE OF SEAL	CL CENTRELINE

2 LINES AND SYMBOLS USED ON THE PLANS

STORMWATER

EXISTING SW PIPE

SW PIPE TO BE REMOVED

PROPOSED SW PIPE

EXISTING SW MANHOLE

SW MANHOLE TO BE REMOVED

PROPOSED SW MANHOLE

SW RODDING EYE

SW INSPECTION CHAMBER

SW PUMP STATION

SW SUMP / DOUBLE SUMP EXISTING

SW SUMP / DOUBLE SUMP NEW

EXISTING SUBSOIL DRAIN

PROPOSED SUBSOIL DRAIN

OVERLAND FLOW PATH

PRECAST CONCRETE HEADWALL

SANITARY SEWER

EXISTING SS PIPE

SS PIPE TO BE REMOVED

PROPOSED SS PIPE

EXISTING SS MANHOLE

SS MANHOLE TO BE REMOVED

PROPOSED SS MANHOLE

SS RODDING EYE

SS INSPECTION CHAMBER

SS PUMP STATION

WATER

EXISTING WATER PIPE

WATER PIPE TO BE REMOVED

PROPOSED WATER PIPE

EXISTING WATER TORY

WATER TORY TO BE REMOVED

PROPOSED WATER TORY

EXISTING WATER VALVE

WATER VALVE TO BE REMOVED

PROPOSED WATER VALVE

EXISTING FIRE HYDRANT

FIRE HYDRANT TO BE REMOVED

PROPOSED FIRE HYDRANT

WATER PUMP STATION

TRADE WASTE

EXISTING TW PIPE

TW PIPE TO BE REMOVED

PROPOSED TW PIPE

EXISTING TW MANHOLE

TW MANHOLE TO BE REMOVED

PROPOSED TW MANHOLE

TW RODDING EYE

TW INSPECTION CHAMBER

TW PUMP STATION

UTILITIES

POWER

GAS

TELECOMMUNICATIONS

Issue	AS BUILT ISSUE	24.03.2014	05
Issue	ISSUED FOR CONSTRUCTION	21.10.2013	06
Issue	ISSUED FOR PRELIM PEER REVIEW	03.08.2013	08
Issue	ISSUED FOR INFORMATION	18.07.2013	09
Revision	Revision For Issue	Date	By

THE CONTRACTOR IS TO BE AWARE OF ALL INSPECTIONS TO BE MADE BY THE ENGINEER AS A REQUIREMENT OF THE PRODUCER STATEMENT PS4 CONSTRUCTION REVIEW DOCUMENTATION. THE ENGINEER WILL REQUIRE 24 HOURS PRIOR NOTIFICATION WHEN ALL STRUCTURAL ELEMENTS ARE READY TO BE INSPECTED.

stratagroup
CONSULTING ENGINEERS

P 06 876 7846
F 06 876 7845
E-MAIL: info@stratagroup.net.nz

PO BOX 738
212 Queen St. East
Hastings, New Zealand

Structural Fire Geotechnical Civil Strategic Planning

CONCRETE STRUCTURES (NZ) LTD

DARFIELD WATER SUPPLY UPGRADE

CIVIL NOTES

Designed: DB	At Scale
Drawn: DB	At Scale
Checked: DB	At Scale
Date: 02/08/2013	HAU SCALE
Report No: J3182	Sheet: 001
	Revision: C

This drawing and its contents are the property of Strata Group Consulting Engineers Limited. Any unauthorised employment or reproduction in full or part is forbidden.

AS BUILT

CERTIFIED BY: *[Signature]*
DESIGNATION: Civil Manager CSL
DATE: 2/4/14

SITE SPECIFIC TABLE:	
EARTHQUAKE ZONE (NZS3101)	2
WIND ZONE	H (kPa)
SOIL TYPE	D
DESIGN LIFE	80 years
NZS 3101:2006 EXPOSURE CLASSIFICATION (TABLE 3.1) =	B2
CONCRETE ELEMENT:	MPa
FOUNDATION	35
FLOOR	35
PRECAST	45

GENERAL

- STRUCTURAL DRAWINGS SHALL BE READ IN CONJUNCTION WITH THE SPECIFICATION, CIVIL AND ENGINEERING SERVICES DOCUMENTS.
- UNLESS OTHERWISE NOTED, ALL LEVELS AND DIMENSIONS ARE IN MILLIMETRES.
- DIMENSIONS SHALL NOT BE OBTAINED BY SCALING FROM DRAWINGS.
- ALL DISCREPANCIES SHALL BE REFERRED TO THE DESIGN ENGINEER FOR RESOLUTION BEFORE PROCEEDING WITH THE WORK.
- THE STABILITY OF THE STRUCTURE DURING CONSTRUCTION IS THE RESPONSIBILITY OF THE CONTRACTOR.
- ALL MATERIALS AND WORKMANSHIP SHALL BE IN ACCORDANCE WITH THE CURRENT CODES OF PRACTICE EXCEPT WHERE VARIED BY THE SPECIFICATION AND/OR DRAWINGS.
- WHERE PROPRIETARY PRODUCTS ARE SPECIFIED IN THE DOCUMENTS THE CONTRACTOR MAY SUBMIT AN ALTERNATIVE PRODUCT FOR APPROVAL.
- CONTRACTOR TO CHECK LOCATION OF EXISTING SERVICES PRIOR TO ANY EXCAVATION WORK. NOTIFY ENGINEER OF ANY CONFLICTS AND Awaiting APPROVAL BEFORE PROCEEDING.
- D&E INDICATES DRILL & EPOXY WITH EPON 82 (EPON 82 EXTREME FOR SIZES OVER 200) UNLESS NOTED OTHERWISE.

CONCRETE

- MINIMUM CONCRETE STRENGTHS SHALL BE AS SPECIFIED IN SITE SPECIFIC TABLE, UNLESS NOTED OTHERWISE ON DRAWINGS.
- SIZES OF CONCRETE ELEMENTS DO NOT INCLUDE THICKNESS OF APPLIED FINISHES.
- CONSTRUCTION JOINTS WHERE NOT SHOWN ON DRAWINGS SHALL BE LOCATED TO THE APPROVAL OF THE ENGINEER.
- NO PENETRATIONS, CHASES OR EMBEDMENT OF PIPES OTHER THAN THOSE SHOWN ON THE STRUCTURAL DRAWINGS SHALL BE MADE IN OR ON CONCRETE MEMBERS WITHOUT THE PRIOR APPROVAL OF THE ENGINEER.
- CONTRACTOR SHALL SUBMIT SHOP DRAWINGS OF ALL PRECAST UNITS FOR APPROVAL PRIOR TO COMMENCEMENT OF WORK.
- TOLERANCES AND FINISHES TO BE AS PER SPECIFICATION.
- SCHEDULES OF SURFACE FINISHES, NZS3114:1987.

ELEMENT	FINISH
EXPOSED CONCRETE FACES OF ABUTMENTS AND PILES	F5
CONCEALED FOUNDATION SURFACES	F1
TOP SURFACES OF FOUNDATION BEAMS AND PADS	U3
VISIBLE FOUNDATION SURFACES	F5
CONCRETE NOT EXPOSED IN FINISHED STRUCTURE (FORMED)	F1
CONCRETE NOT EXPOSED IN FINISHED STRUCTURE (UNFORMED)	U3
ALL PRECAST SURFACES EXPOSED IN THE FINISHED JOB	F5

*OFF A STEEL FORM

PRECAST WALLS

- SHOULD THE CONTRACTOR WISH TO DO PARTIAL CONSTRUCTION OF FOUNDATION, THE TEMPORARY PROPPING METHODOLOGY TO THE PRECAST WALLS IS TO BE CONFIRMED WITH THE ENGINEER.

REINFORCEMENT

- REINFORCING DESIGNATION AS FOLLOWS:

NOTE: HD / XD BARS ARE TO BE BENT DURING CONSTRUCTION ONCE ONLY.

SYMBOL	TYPE
R	PLAIN BARS GRADE 300 TO AS/NZS 4671 (300 MPa)
HR / XR	PLAIN BARS GRADE 500 TO AS/NZS 4671 (500 MPa)
D	DEFORMED BARS GRADE 300 TO AS/NZS 4671 (300 MPa)
HD / XD	DEFORMED BARS GRADE 500 TO AS/NZS 4671 (500 MPa)
M	MESH TO NZS 3422
RB	DEFORMED REIDBAR GRADE 500 MPa

- CLEAR COVER TO ALL REINFORCEMENT, INCLUDING STIRRUPS, TIES ETC SHALL BE AS FOLLOWS UNLESS NOTED OTHERWISE ON THE DRAWINGS AND SPECIFICATION.

TABLE 3.7 - MINIMUM REQUIRED COVER FOR A SPECIFIED INTENDED LIFE OF 100 YEARS	
EXPOSURE CLASSIFICATION	CEMENT BINDER TYPE
B2	GP, GB OR HE

NOTE: FOR ZONE C THE TOTAL BINDER CONTENT SHALL BE EQUAL TO OR GREATER THAN 350kg/m³ AND WATER TO BINDER RATIO SHALL NOT EXCEED 0.45 THE MINIMUM COVER FOR THE CONCRETE SHALL BE 50mm

3.11.3.3 CASTING AGAINST GROUND: WHERE CONCRETE IS CAST ON OR AGAINST GROUND AND COMPACTED IN ACCORDANCE WITH NZS 3109, THE MINIMUM COVER FOR A SURFACE IN CONTACT WITH THE GROUND SHALL BE 75mm, OR 60mm IF USING A DAMP-PROOF MEMBRANE BETWEEN THE GROUND AND THE CONCRETE TO BE CAST.

- NO REINFORCEMENT SPLICES SHALL BE MADE OTHER THAN THOSE SHOWN ON THE STRUCTURAL DRAWINGS WITHOUT THE PRIOR APPROVAL OF THE ENGINEER. REINFORCEMENT LAPS IN CONCRETE TO COMPLY WITH THE TABLE BELOW. SPLICE LAP LENGTHS FOR DEFORMED BARS (IN MM) NZS3101:2006 A.8.3 (EQN 8.2).

LAPS


STANDARD BAR CRANK
LAP LENGTH (SEE TABLE BELOW)

LAP LENGTHS

BAR TYPE	12 Ø
D BARS	40 Ø
HD BARS	50 Ø

THE DEVELOPMENT OF PLAIN BARS SHALL RELY ON HOOKS.

- EPOXY GROUTING OF REINFORCING BARS INTO CONCRETE: HOLES FOR VERTICAL BARS SHALL BE VERTICAL. HOLES FOR HORIZONTAL STARTERS SHALL SLOPE DOWN AT 15 DEGREES.
- WELDING OF REINFORCEMENT IS NOT PERMITTED.
- TOP AND BOTTOM REINFORCEMENT IN SLABS SHALL BE ADEQUATELY SUPPORTED TO ENSURE ALL REINFORCEMENT STAYS IN PLACE DURING CONCRETE POURING.
- STANDARD HOOKS AND BENDS, NZS3101:8.6.

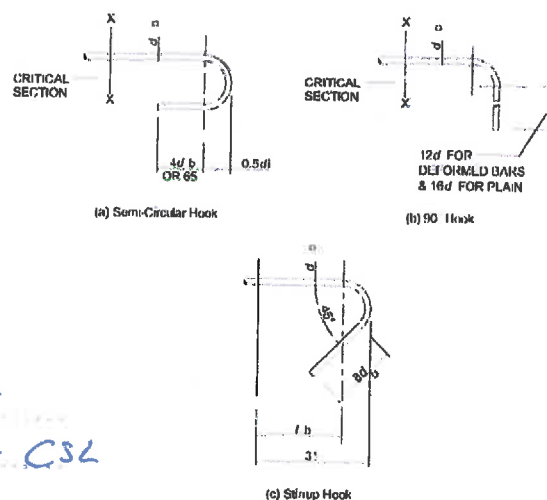

ALL DIMENSIONS ARE FROM OUTSIDE TO OUTSIDE OF BARS EXCEPT RADII WHICH ARE TO INSIDE OF BAR. 'd' DENOTES BAR DIAMETER.

BAR SIZE	MAIN STEEL GRADE 300/500	STIRRUPS AND TIES GRADE 300/500	
		PLAIN ROUND	DEFORMED
6	30	12	24
10	50	20	40
12	60	24	48
16	80	32	64
20	100	40	80
24	144	72	144
32	192	96	192
40	240	120	240

TABLE 8.1 & 8.2 NZS3101:2006

NOTE: FOR STIRRUPS AND TIES, WHERE THE MAIN BAR SIZE IS GREATER THAN THE MINIMUM FORMER PIN DIAMETER, THE MAIN BAR SIZE WILL GOVERN.


- STANDARD BAR CRANK




WHEN MAIN BARS ARE OFFSET, i.e. FOR CRANKED LAPS, THE SLOPE OF THE INCLINE PORTION OF THE BAR SHALL NOT EXCEED 1 IN 6.

- REINFORCING SPIRAL FOR CONCRETE POLES MUST HAVE ONE FULL TURN PLUS WELDED TERMINATION AT EACH END AND WHEN SPLICED.
- MESH REINFORCING REQUIREMENTS IN CONCRETE SLABS LISTED IN MESH TABLE BELOW UNLESS NOTED OTHERWISE ON DRAWINGS.


SLAB THICKNESS:	MESH:
100mm	SE82
125mm	SF72
150mm	SF82

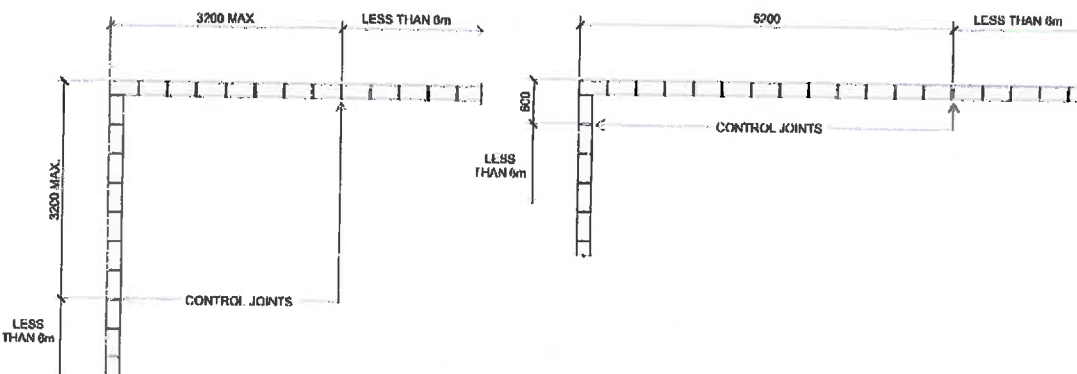

CONCRETE MASONRY - LOCATION OF CONTROL JOINTS FOR SHRINKAGE

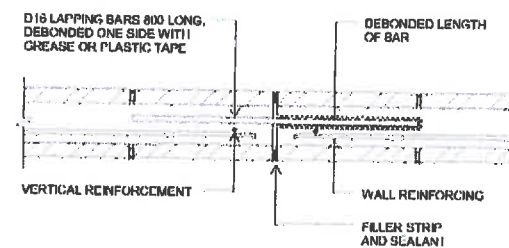

CONCRETE MASONRY - CONTROL JOINT DETAIL

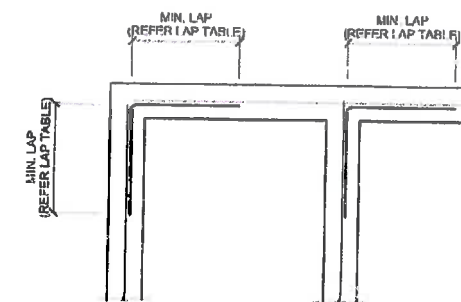

TYPICAL HORIZONTAL REINFORCING LAP DETAIL

Revision	Reason For Issue	Date	By
C	AS BUILT ISSUE	24/01/2014	DS
B	ISSUED FOR CONSTRUCTION	21/08/2013	DS
A	ISSUED FOR PRELIM PEER REVIEW	04/04/2013	DS
	ISSUED FOR INFORMATION	16/07/2012	DS

THE CONTRACTOR IS TO BE AWARE OF ALL INSPECTIONS TO BE MADE BY THE ENGINEER AS A REQUIREMENT OF THE PRODUCER STATEMENT PS4 CONSTRUCTION REVIEW DOCUMENTATION. THE ENGINEER WILL REQUIRE 24 HOURS PRIOR NOTIFICATION WHEN ALL STRUCTURAL ELEMENTS ARE READY TO BE INSPECTED.

stratagroup CONSULTING ENGINEERS	
P 06 876 7644 F 06 876 7645 E-MAIL: info@stratagroup.net.nz	PO BOX 758 212 Queen St. East Hastings, New Zealand
Structural	Fire Geotechnical Civil Strategic Planning

CONCRETE STRUCTURES (NZ) LTD


DARFIELD WATER SUPPLY UPGRADE

STRUCTURAL NOTES - CONCRETE / MASONRY

Designed DS	At Scale
Drawn DS	As Indicated
Checked DS	At Scale
Date OCTOBER 2013	1/42 SCALE
Project No J3182	Sheet 002
	Revision C

This drawing and its contents are the property of Strato Group Consulting Engineers Limited. Any unauthorised employment or reproduction in full or part is forbidden.


AS BUILT
CERTIFIED BY: *[Signature]*
DESIGNATION: Civil Manager CSL
DATE: 2/4/14

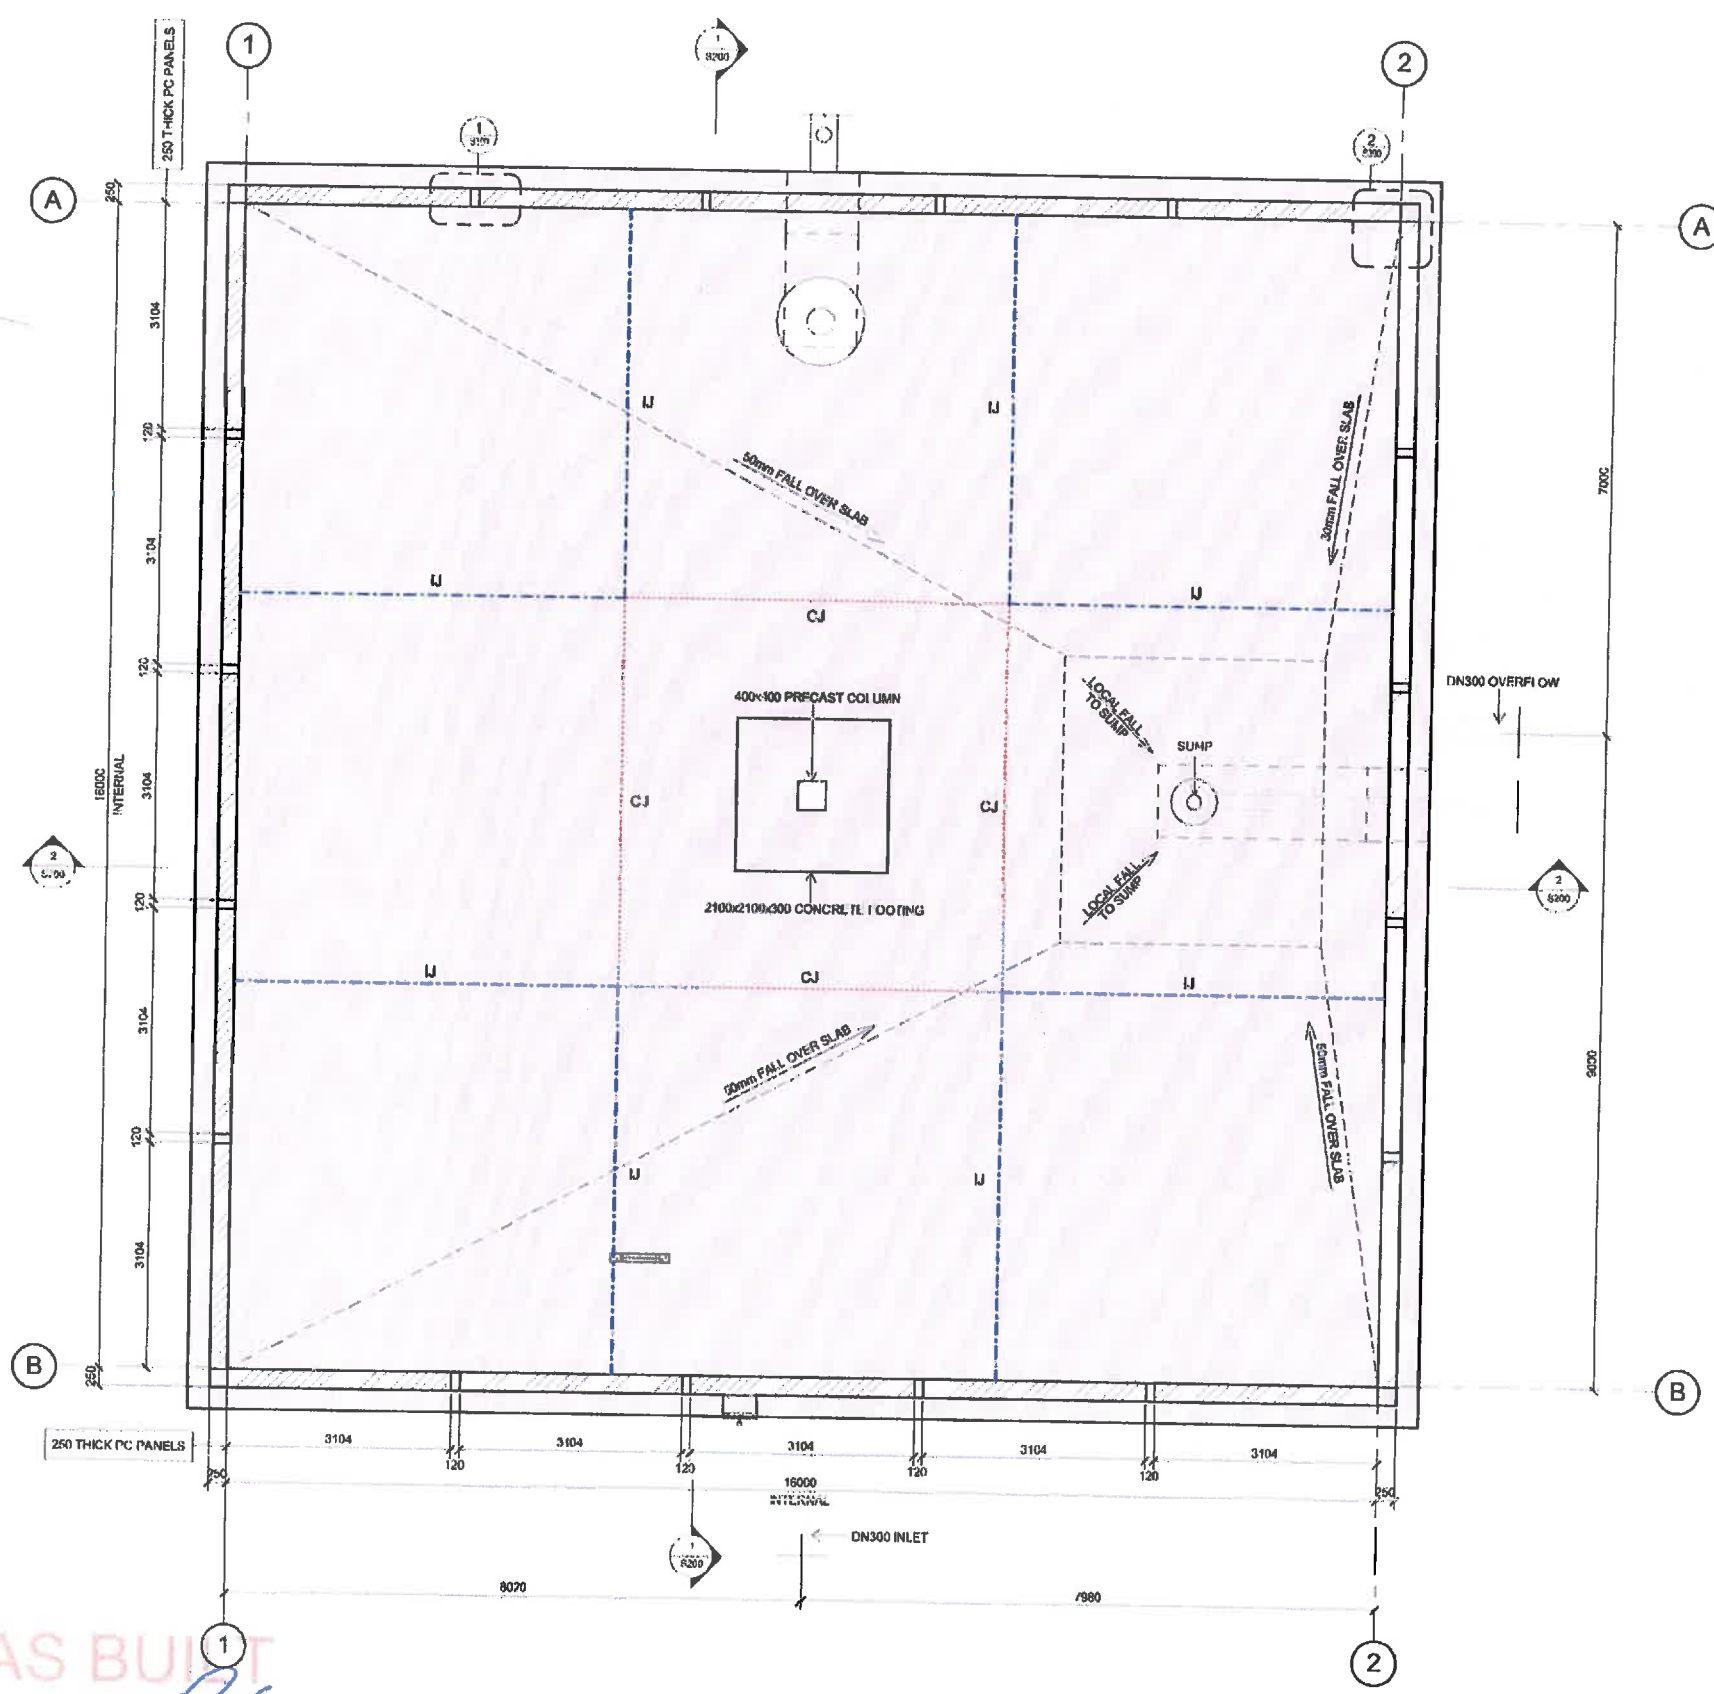


NOTE

USE SIKATOP 107 PAINTED OVER SEAL JOINTS AND WALL JOINTS APPLY AS FOLLOWS

- 50mm WIDE STRIPS (25mm FROM CTR OF EACH JOINT)
- 175mm WIDE STRIPS OVER INSITU WALL JOINTS (120mm JOINT PLUS 2x 25mm EACH SIDE)
- ALONG ANY HAIRLINE CRACKS THAT MAY DEVELOP

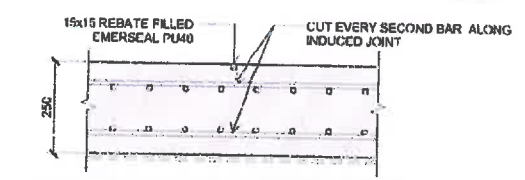

TYPICAL INDUCED JOINT DETAIL (IJ)
1:10

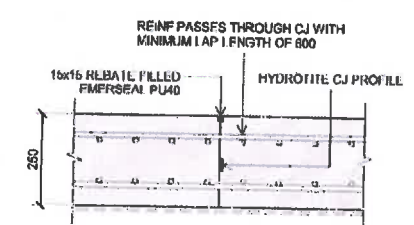

TYPICAL CONSTRUCTION JOINT DETAIL (CJ)
1:10

Rev	Description	Date	By
0	AS BUILT ISSUE	24-09-2014	DB
1	SIKATOP NOT IN ADOPTED	14-01-2014	DB
2	ISSUED FOR CONSTRUCTION	21-06-2013	DB
3	ISSUED FOR PRELIM PEER REVIEW	01-06-2013	DB
4	ISSUED FOR INFORMATION	16-07-2013	DB

THE CONTRACTOR IS TO BE AWARE OF ALL INSPECTIONS TO BE MADE BY THE ENGINEER AS A REQUIREMENT OF THE PRODUCER STATEMENT P34 CONSTRUCTION REVIEW DOCUMENTATION. THE ENGINEER WILL REQUIRE 24 HOURS PRIOR NOTIFICATION WHEN ALL STRUCTURAL ELEMENTS ARE READY TO BE INSPECTED.

stratagroup
CONSULTING ENGINEERS

P 06 876 7846
F 06 876 7845
E-MAIL: info@stratagroup.net.nz

PO BOX 788
212 Queen St. East
Hastings, New Zealand

Structural Fire Geotechnical Civil Strategic Planning

CONCRETE STRUCTURES (NZ) LTD

DARFIELD WATER SUPPLY UPGRADE

FLOOR PLAN

Designed	DB	At Scale
Drawn	DB	As Indicated
Checked	DB	At Scale
Date	OCTOBER 2013	1/4" SCALE
Project No	J3182	Sheet
		S100
		D

This drawing and its contents are the property of Strata Group Consulting Engineers Limited. Any unauthorized employment or reproduction in full or part is forbidden.

AS BUILT


CERTIFIED BY: *[Signature]*
DESIGNATION: Civil Manager CSL
DATE: 2/4/14

FLOOR PLAN
1:60

NOTE:
PRESTRESSED ROOF SLAB UNITS TO BE
90 THICK x 2300 WIDE REINFORCED WITH
3 12.70 SUPERSTRANDS 38mm FROM
UNDERSIDE PRESTRESSED TO 130kN
AFTER LOSSES

NOTE

- USL SIKATOP 107 PAINTED OVER SEAL JOINTS AND
WALL JOINTS APPLY AS FOLLOWS
- 50mm WIDE STRIPS (25mm FROM CTR OF EACH JOINT)
 - 15mm WIDE STRIPS OVER INSITU WALL JOINTS (120mm JOINT PLUS 2x 35mm EACH SIDE)
 - ALONG ANY HAIRLINE CRACKS THAT MAY DEVELOP

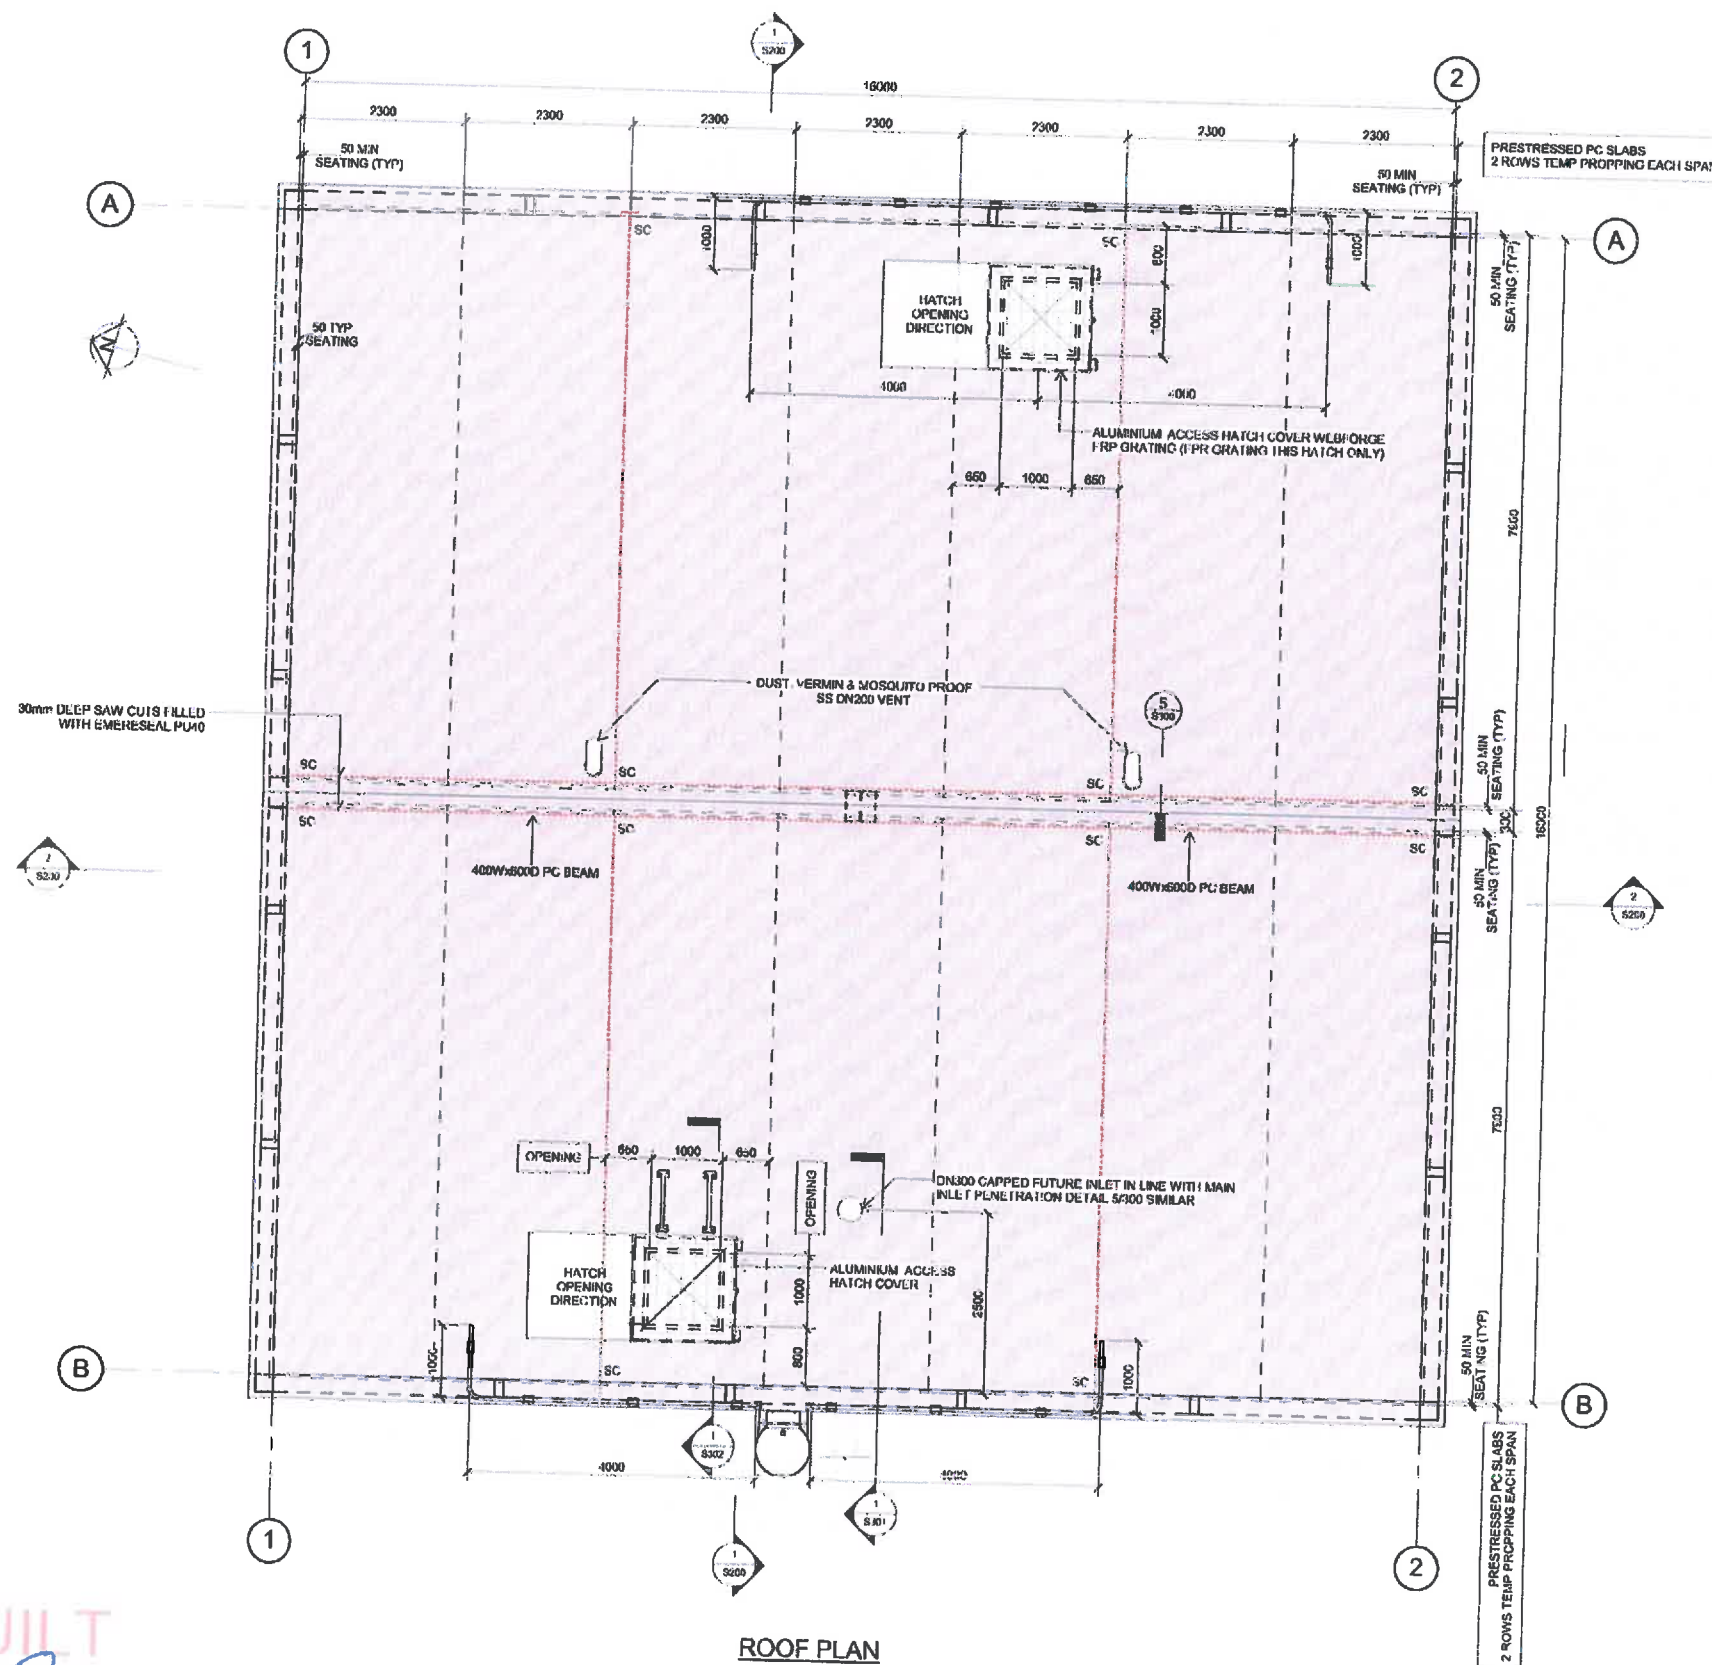

ROOF PLAN
1:50

AS BUILT

CERTIFIED BY:
DESIGNATION:
DATE:

[Signature]
Civil Manager CSL
2/4/14

Revision	Description	By	Check	Date
0	AS BUILT ISSUE	24-05-2014	DS	
1	SIKATOP NOTE'S ADDED	14-01-2014	DS	
2	ISSUED FOR CONSTRUCTION	21-08-2013	DS	
3	ISSUED FOR PRELIM PCR REVIEW	04-08-2013	DS	
4	ISSUED FOR INFORMATION	16-08-2013	DS	

THE CONTRACTOR IS TO BE AWARE OF ALL INSPECTIONS
TO BE MADE BY THE ENGINEER AS A REQUIREMENT OF
THE PRODUCER STATEMENT PS4 CONSTRUCTION REVIEW
DOCUMENTATION. THE ENGINEER WILL REQUIRE 24 HOURS
PRIOR NOTIFICATION WHEN ALL STRUCTURAL ELEMENTS
ARE READY TO BE INSPECTED.

stratagroup
CONSULTING ENGINEERS
P 06 876 7645
F 06 876 7645
E-MAIL: info@stratagroup.net.nz
PO BOX 758
212 Queen St East
Hawthorne, New Zealand
Structural Fire Geotechnical Civil Strategic Planning



Client
CONCRETE STRUCTURES (NZ) LTD

Project
DARFIELD WATER SUPPLY UPGRADE

To
ROOF PLAN

Designed DS	At Scale
Drawn DS	As Noted
Checked DS	As Noted
Date 02/08/2013	1/4" SCALE
Project No J3182	Sheet S101
	Revision D

This drawing and its contents are the property of
Strata Group Consulting Engineers Limited.
Any unauthorised employment or
reproduction in full or part is forbidden

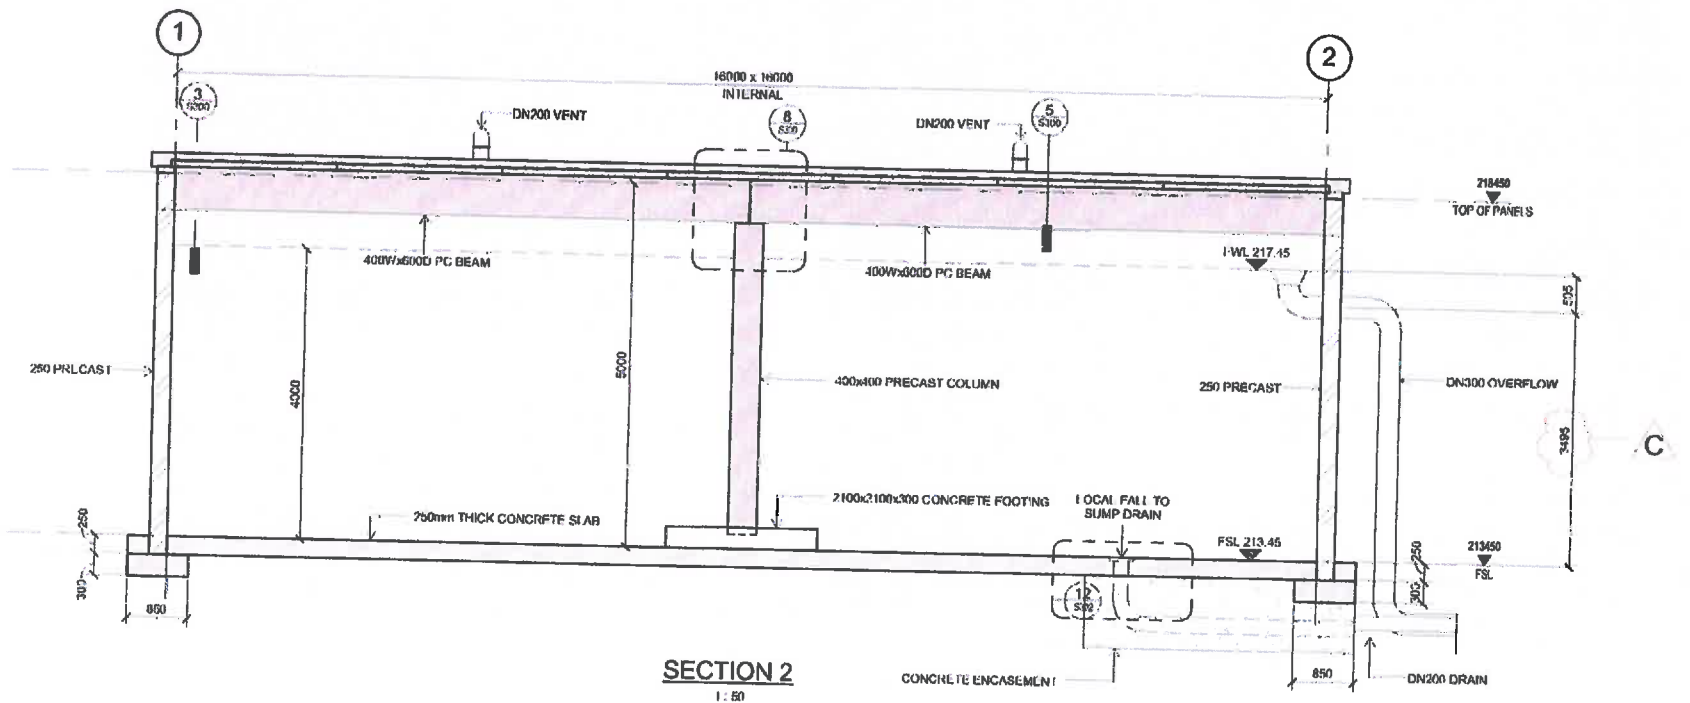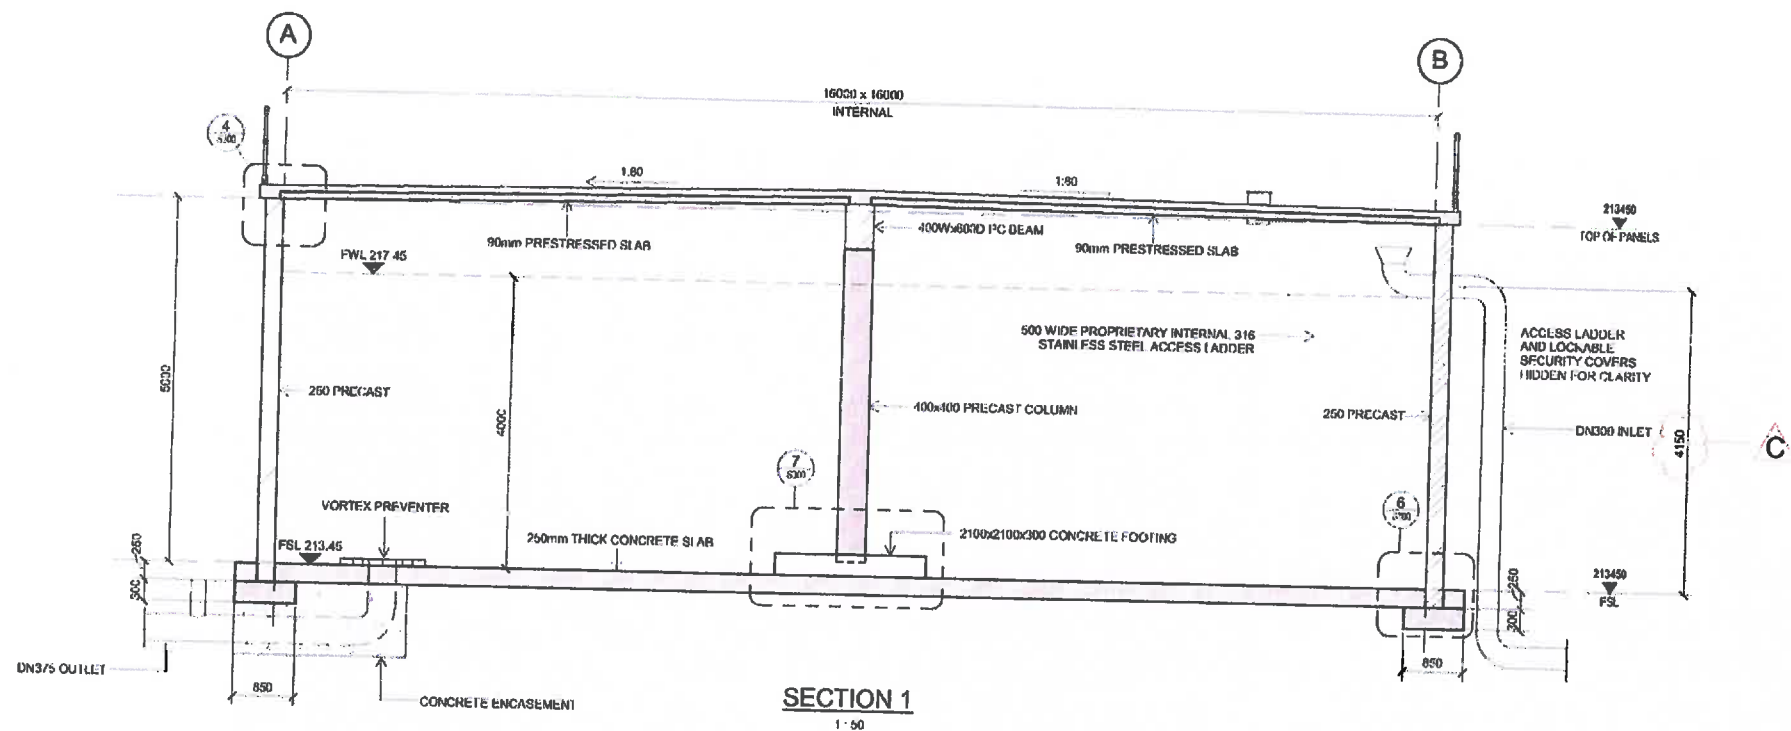

AS BUILT

CERTIFIED BY:
DESIGNATION:
DATE:

[Signature]
Civil Manager CSL
2/4/14

D	AS BUILT ISSUE	21.01.2011	DS		
C	DIMENSIONS ADDED FOR PANEL PENETRATIONS	27.10.2012	DS		
B	ISSUED FOR CONSTRUCTION	21.10.2012	DS		
A	ISSUED FOR PRELIM PEER REVIEW	03.09.2012	DS		
1	ISSUED FOR REVISION	16.07.2013	DS		
Revised	Revised For Issue	Drawn	By		

THE CONTRACTOR IS TO BE AWARE OF ALL INSPECTIONS TO BE MADE BY THE ENGINEER AS A REQUIREMENT OF THE PRODUCER STATEMENT PS4 CONSTRUCTION REVIEW DOCUMENTATION. THE ENGINEER WILL REQUIRE 24 HOURS PRIOR NOTIFICATION WHEN ALL STRUCTURAL ELEMENTS ARE READY TO BE INSPECTED.

stratagroup
CONSULTING ENGINEERS

P 06 876 7646
F 06 876 7045
E-MAIL: info@stratagroup.net.nz
PO BOX 758
212 Queens St. East
Hastings, New Zealand

Structural Fire Geotechnical Civil Strategic Planning


CONCRETE STRUCTURES (NZ) LTD

DARFIELD WATER SUPPLY UPGRADE


SECTIONS

Drawn	DS	At Scale	1:50
Checked	DS	At Scale	HALF SCALE
Date	02/06/2013	Project No	J3182
		Sheet	S200
		Revision	D


This drawing and its contents are the property of Stratagroup Consulting Engineers Limited. Any unauthorised employment or reproduction in full or part is forbidden.

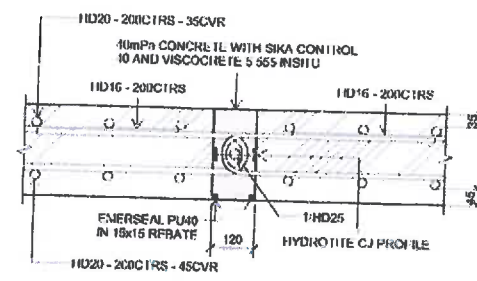


1 TYPICAL PC PANEL BUTT JOINT DETAIL
S100 1:10

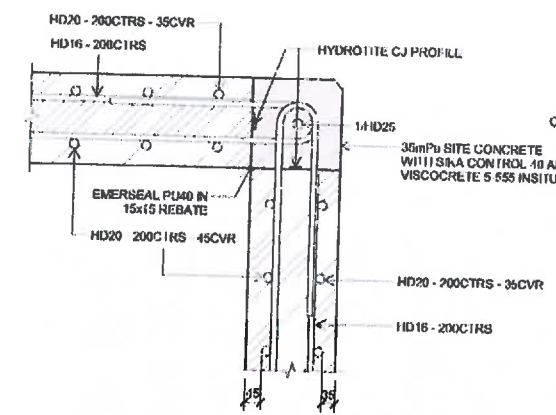


2 TYPICAL PC PANEL CORNER JOINT DETAIL
S100 1:10

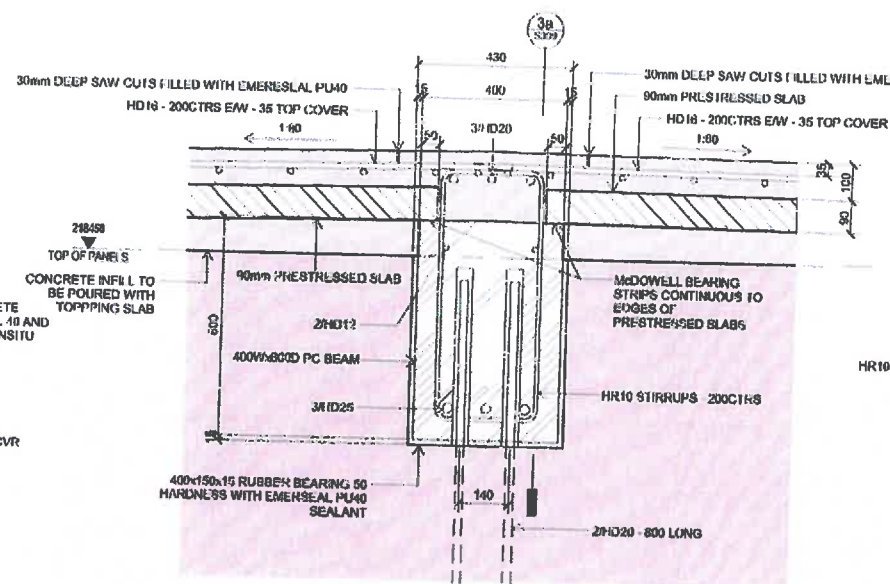


3 PRECAST BEAM TO PC PANEL DETAIL
S200 1:10

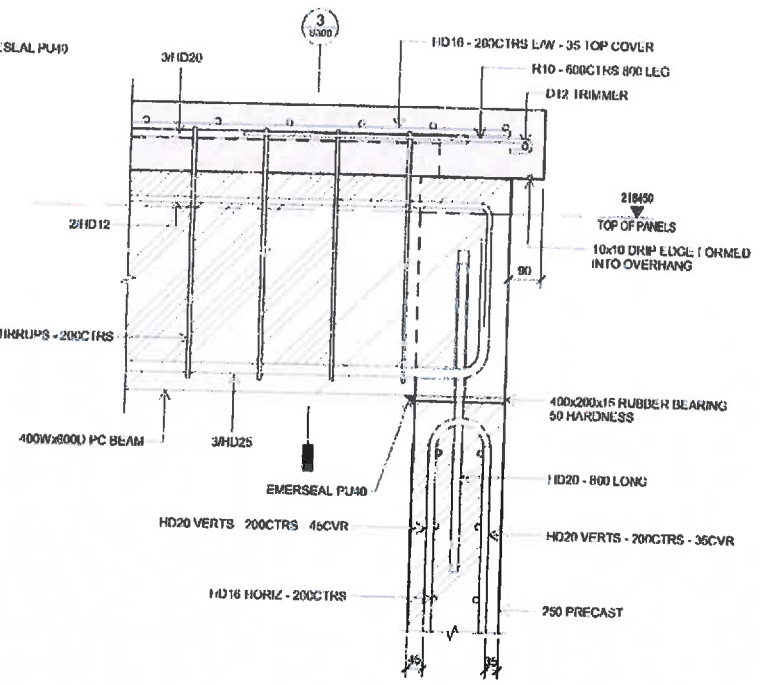


3a PRECAST BEAM TO PC PANEL SECTION
S300 1:10

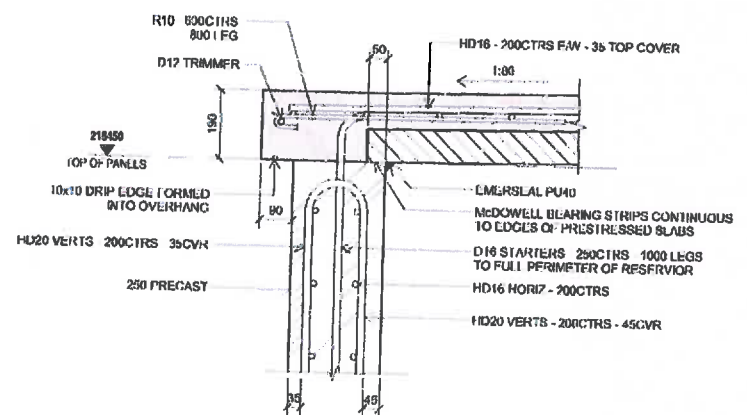


4 ROOF EDGE DETAIL
S200 1:10

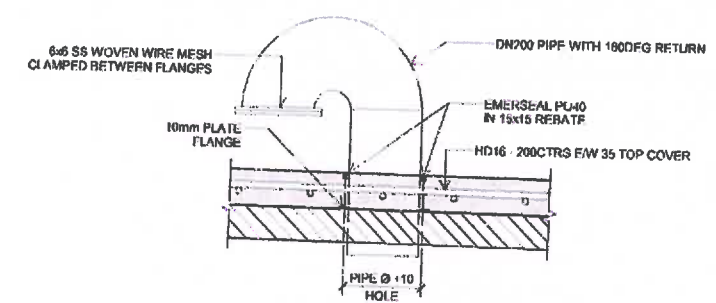


5 VENT DETAIL
S101 1:10

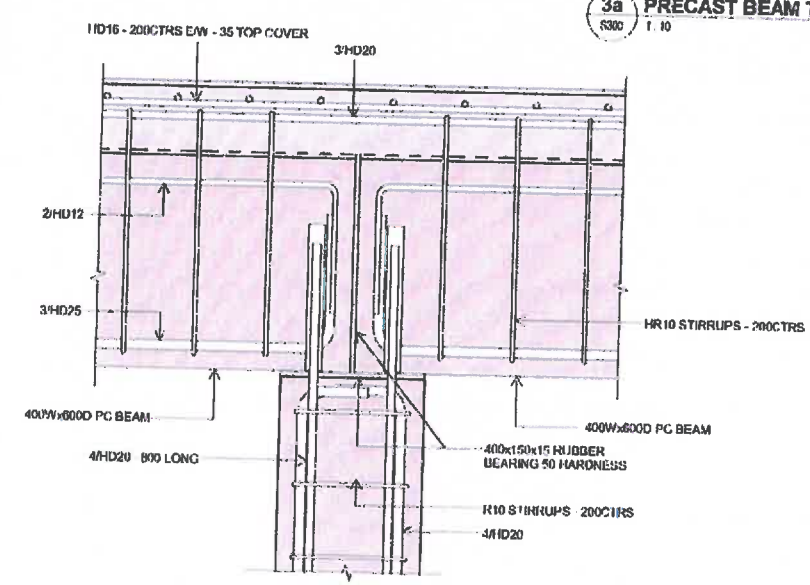

8 PRECAST BEAM TO PC COLUMN DETAIL
S200 1:10

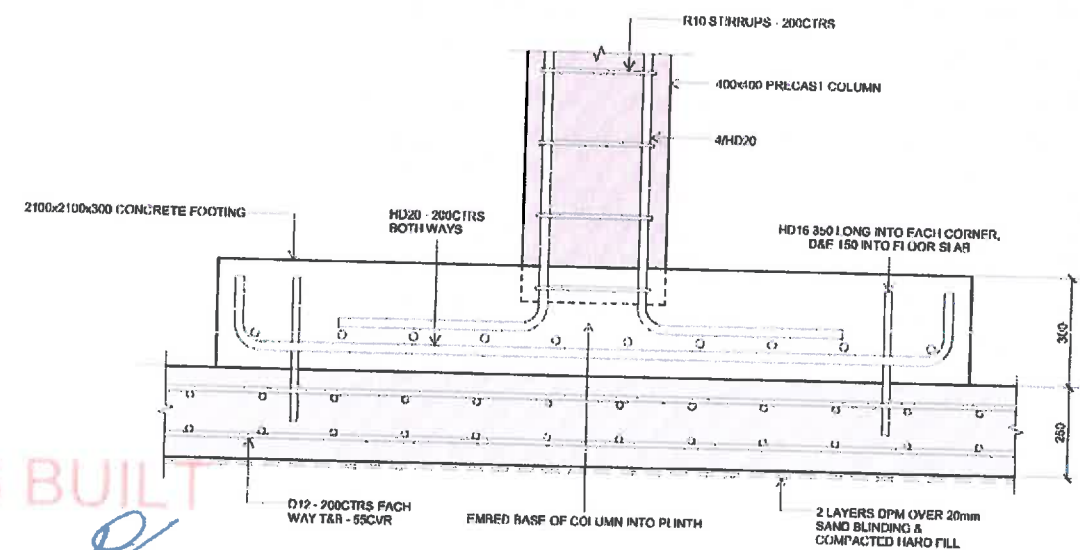

7 PRECAST COLUMN BASE DETAIL
S100 1:10

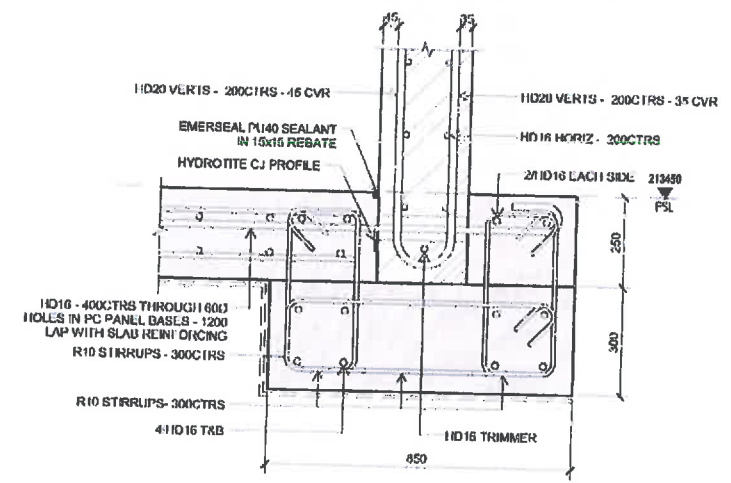

6 TYPICAL GROUND BEAM DETAIL
S200 1:10

C	AS BUILT ISSUE	24-05-2014	DS
S	ISSUED FOR CONSTRUCTION	21-10-2017	DS
A	ISSUED FOR PRELIMINARY REVIEW	03-03-2013	DS
Revision	Reason for issue	Issue	By

THE CONTRACTOR IS TO BE AWARE OF ALL INSPECTIONS TO BE MADE BY THE ENGINEER AS A REQUIREMENT OF THE PRODUCER STATEMENT P34 CONSTRUCTION REVIEW DOCUMENTATION. THE ENGINEER WILL REQUIRE 24 HOURS PRIOR NOTIFICATION WHEN ALL STRUCTURAL ELEMENTS ARE READY TO BE INSPECTED

stratagroup
CONSULTING ENGINEERS

P 06 876 7648
F 06 876 7645
E-MAIL: info@stratagroup.net.nz

P O BOX 758
212 Queens St. East
Hastings, New Zealand

Structural Fire Geotechnical Civil Strategic Planning

Client
CONCRETE STRUCTURES (NZ) LTD

Project
DARFIELD WATER SUPPLY UPGRADE

Drawn DS
Checked DS
Date OCTOBER 2013


Project No
J3182

Sheet
S300


Revision
C

This drawing and its contents are the property of Stratagroup Consulting Engineers Limited. Any unauthorised employment or reproduction in full or part is forbidden.

AS BUILT
CERTIFIED BY: *DK*
DESIGNATION: *Civil Manager*
DATE: *21.4.14*

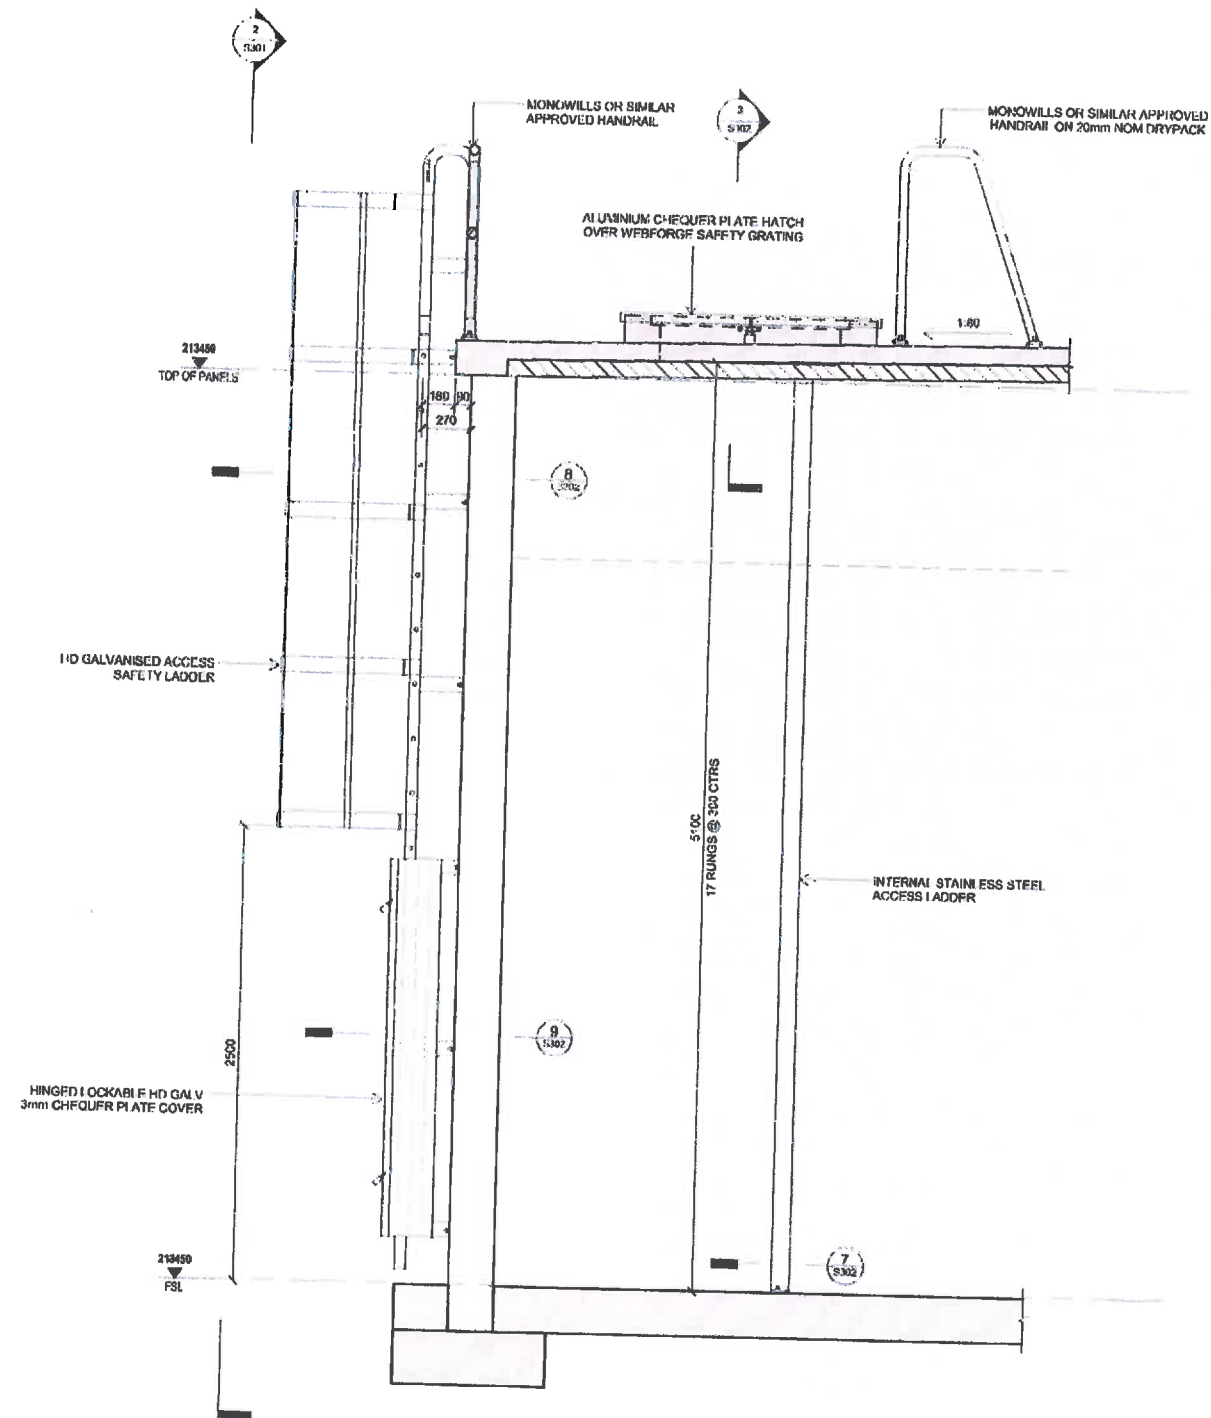

1 INTERNAL LADDER ACCESS SECTION
S101 1:20

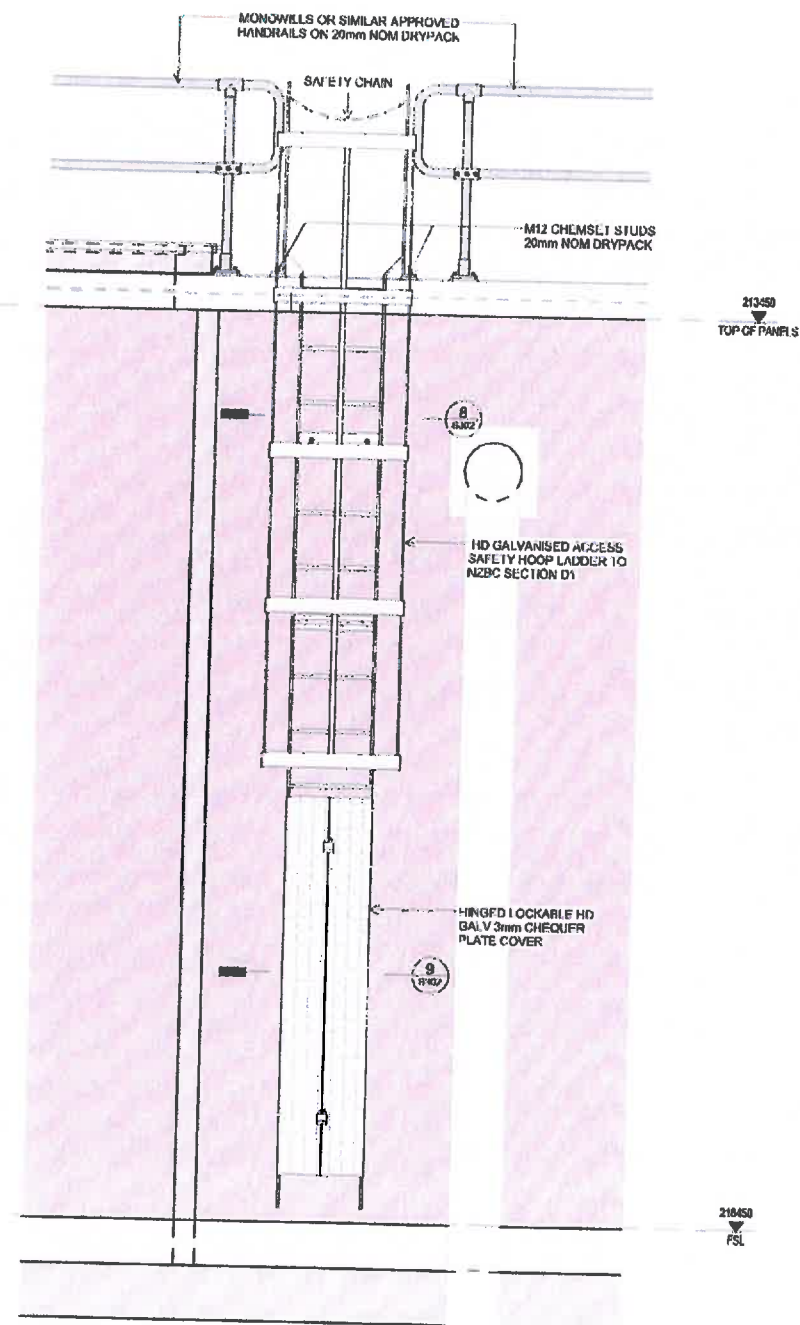

2 EXTERNAL LADDER ACCESS SECTION
S101 1:20

AS BUILT

CERTIFIED BY: *Dh*
DESIGNATION: Civil Manager CSL
DATE: 21/4/14

C	AS BUILT 10/12/14	21/03/2014	Da
D	ISSUED FOR CONSTRUCTION	21/03/2014	Da
A	ISSUED FOR PRELIMINARY REVIEW	03/06/2013	Da
Revised	Revised For 10/12/14	03/06/2013	Da

THE CONTRACTOR IS TO BE AWARE OF ALL INSPECTIONS TO BE MADE BY THE ENGINEER AS A REQUIREMENT OF THE PRODUCER STATEMENT P34 CONSTRUCTION REVIEW DOCUMENTATION. THE ENGINEER WILL REQUIRE 24 HOURS PRIOR NOTIFICATION WHEN ALL STRUCTURAL ELEMENTS ARE READY TO BE INSPECTED.

stratagroup
CONSULTING ENGINEERS
PO BOX 755
212 Queen St East
Auckland, New Zealand
E-MAIL: info@stratagroup.co.nz
Structural Fire Geotechnical Civil Strategic Planning

CONCRETE STRUCTURES (NZ) LTD

DARFIELD WATER SUPPLY UPGRADE

DETAILS

Design	CS	As Scale	1:20
Drawn	CS	As Scale	1:20
Checked	CS	As Scale	1:20
Date	OCTOBER 2013	Project No	J8132
		Sheet	S801
		Revision	C

This drawing and its contents are the property of Stratagroup Consulting Engineers Limited. Any unauthorised employment or reproduction in full or part is forbidden.

1. ALL DIMENSIONS MUST BE CONFIRMED ON SITE PRIOR TO FABRICATION FOR METALWORK ITEMS SUCH AS LADDERS, HATCHES AND SECURITY COVER.
2. LADDERS AND HANDRAILS SHALL COMPLY WITH THE NZ BUILDING CODE COMPLIANCE DOCUMENT D1 - ACCESS ROUTES
3. ALL SS GRADES TO BE 316
4. ALL ALUMINIUM GRADES TO BE CORROSION RESISTANT MARINE GRADE



CERTIFIED BY: 
DESIGNATION: Civil Manager CSI
DATE: 2/4/14

D	AS BUILT ISSUE	04-30-2014	05
C	SLAB PENETRATION DETAIL REVISED TO SPLIT PUDDLE FLANGE	10-11-2013	02
D	ISSUED FOR CONSTRUCTION	21-10-2013	05
A	ISSUED FOR PRELIMINARY REVIEW	03-04-2013	05
Revision	Not in for base	Date	By

THE CONTRACTOR IS TO BE AWARE OF ALL INSPECTIONS TO BE MADE BY THE ENGINEER AS A REQUIREMENT OF THE PRODUCER STATEMENT PS4 CONSTRUCTION REVIEW DOCUMENTATION, THE ENGINEER WILL REQUIRE 24 HOURS PRIOR NOTIFICATION WHEN ALL STRUCTURAL ELEMENTS ARE READY TO BE INSPECTED.

stratagroup
CONSULTING ENGINEERS

P 06 876 7646
F 06 876 7645
E-MAIL: info@stratagroup.net.nz

PO BOX 736
212 Queen St. East
Hastings, New Zealand

Structural Fire Geotechnical CMI Strategic Planning

**CONCRETE STRUCTURES (NZ)
LTD**

DARFIELD WATER SUPPLY UPGRADE

DETAILS

Designed DB	At Scale	
Drawn DS	As Impaired	
Checked DB	At Scale	
Date OCTOBER, 1971	HALF SCALE	
Project No	Sheet	Reprint
J3182	S302	D

This drawing and its contents are the property of
Straits Group Consulting Engineers Limited.
Any unauthorized employment or
reproduction in full or part is forbidden

APPENDIX A

LEVEL TRANSMITTER STILLING TUBE INSTALLATION - SKETCH

Calculation Sheet

Project/Task/File No: **LEVEL TRANSMITTER - STILLING TUBE**

Sheet No **1** of **2**

Project/Description:

Office:

Computed: **20141119**

Checked: **111**

LEVEL TRANSMITTER FITTED TO THE TOP
OF STILLING TUBE - SEE BELOW

STILLING TUBE CLAMP - SEE DETAIL A

EX. INTERNAL
LOADS IN RESERVOIR

STILLING TUBE CLAMP TO BE MAX 300
FROM BASE OF RESERVOIR SEE DETAIL A

STILLING TUBE TO BE MIN 100MM
FROM BASE OF RESERVOIR

AS BUILT

CERTIFIED BY: *[Signature]*

DESIGNATION: *Senior Electrical Engineer*

Date: **2/7/2014**

ELEVATION - NTS

LEVEL TRANSMITTER FITTED TO SAME LEVEL
AS EXISTING.

LEVEL TRANSMITTER SCREWED INTO TOP
OF END CAP AND FIRED WITH NUT AND
WASHER.

FIX END CAP TO TOP OF TUBE WITH SCREWS
NOT GLUED.


DRILL 10mm Ø HOLE THROUGH TOP OF
END CAP AND TUBE.

DN100 PN9 PVC-U PIPE WITH LENGTH TO
SUIT.

PIPE SUPPORT CLAMP - SEE DETAIL A

ELEVATION - NTS

NOTE: ALL MATERIALS AND FITTINGS TO BE DISINFECTED PRIOR
TO INSTALLATION

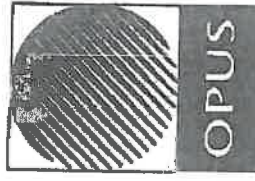

Calculation Sheet

Project/Task/File No: STILLING TUBE FIXING DETAILS


Sheet No 2 of 2

Project/Description:


Office:

Computed: 24 / 4 / 14

Checked: 1 / 1

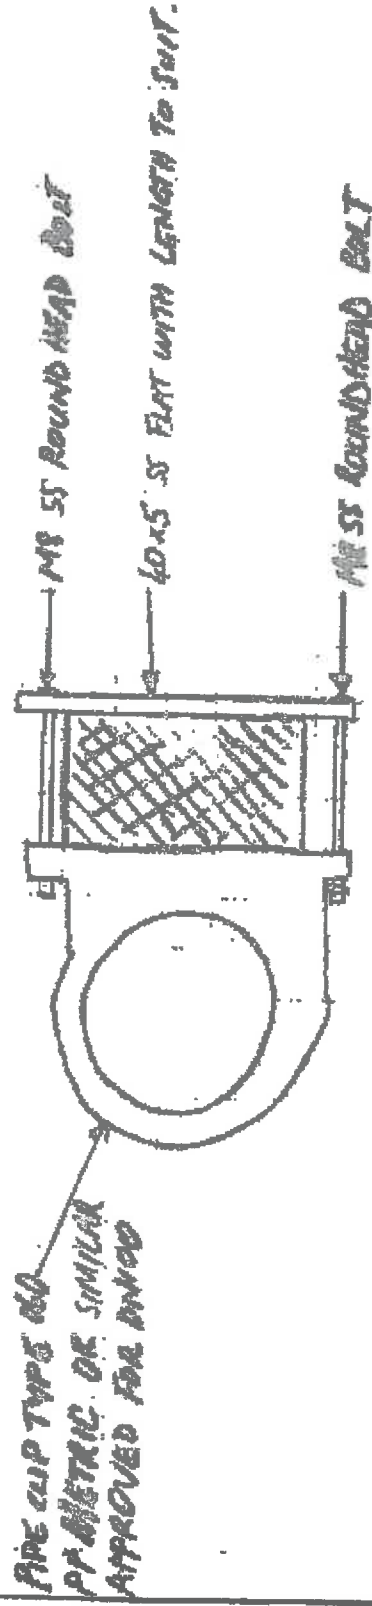


DETAIL A - PLAN

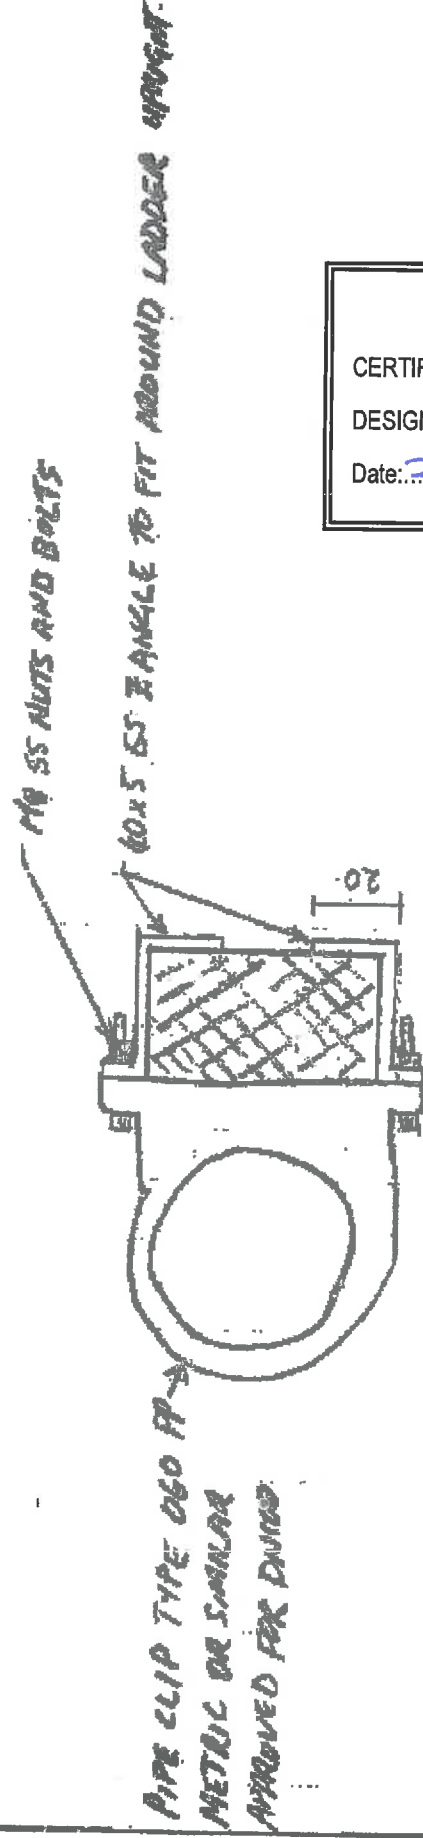


DETAIL B - PLAN

AS BUILT	
CERTIFIED BY:	<i>[Signature]</i>
DESIGNATION:	<i>Senior Ulster Consultant</i>
Date:	<i>21/2014</i>

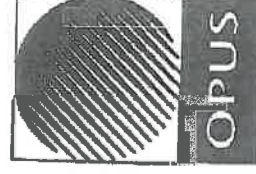

APPENDIX B

POWER CONTROLS

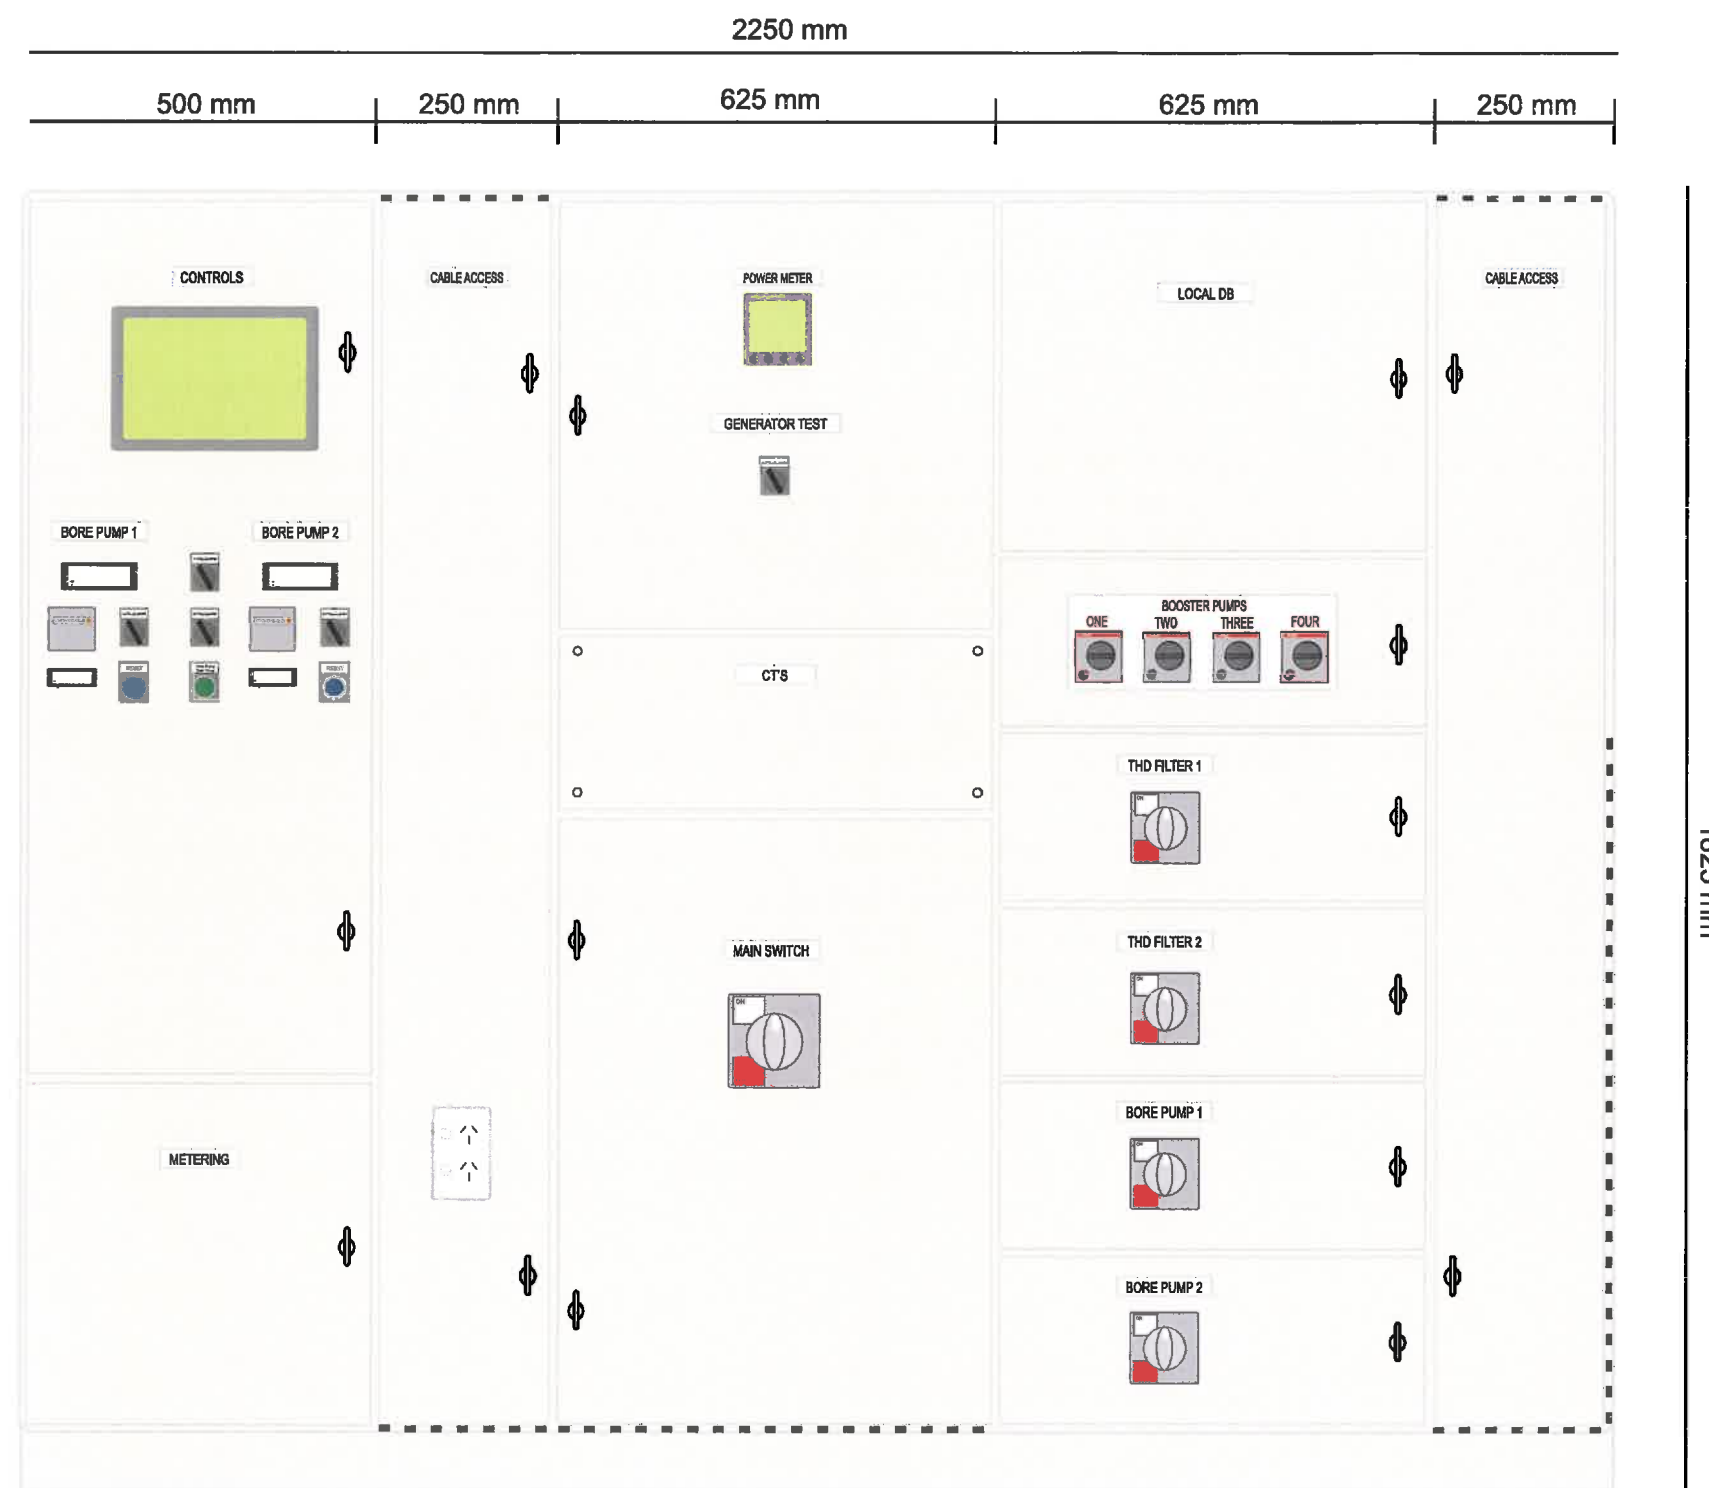

EQUIPMENT LIST:

- 1) Power Analyser - Schneider PM5350
- 2) Bore Pump Start Counter - Omron H7EC
- 3) Bore Pump Temp Display - Shimaden SD16-808-1400
- 4) Hour Meter- Vemer HMS 1080
- 5) HMI - Schneider Magelis HMIGTO5310 10

Depth - 350 mm
IP 54
Switchgear - ABB

DOORS CLOSED

- - - - - = Gland Plates

22 ROTHERHAM STREET
PO BOX 2034
STOKE NELSON
NEW ZEALAND
PH - +643 547 8301
FX - +643 547 8312
sales@powercontrol.co.nz

POWER CONTROL
SOLUTIONS LTD
Switchgear Manufacturers

	Date	Notes
A	20.11.13	Raise control cabinet. Show gland plates. Add booster pump external isolators.
B	21.11.13	Relocate socket outlet. Space out booster pump switches (motor CB's mounted forward through door)
C	23.06.14	Layout details and component information added.
D		
E		

Drawn by - LEP

Checked by - QDP

Drawing No. - PCS-99107 - 01


Scale - DNS

Client / Project

RCR Infrastructure - Darfield WTP Project

Drawing Title

Main Switchboard - General Arrangement Drawing - Doors Closed

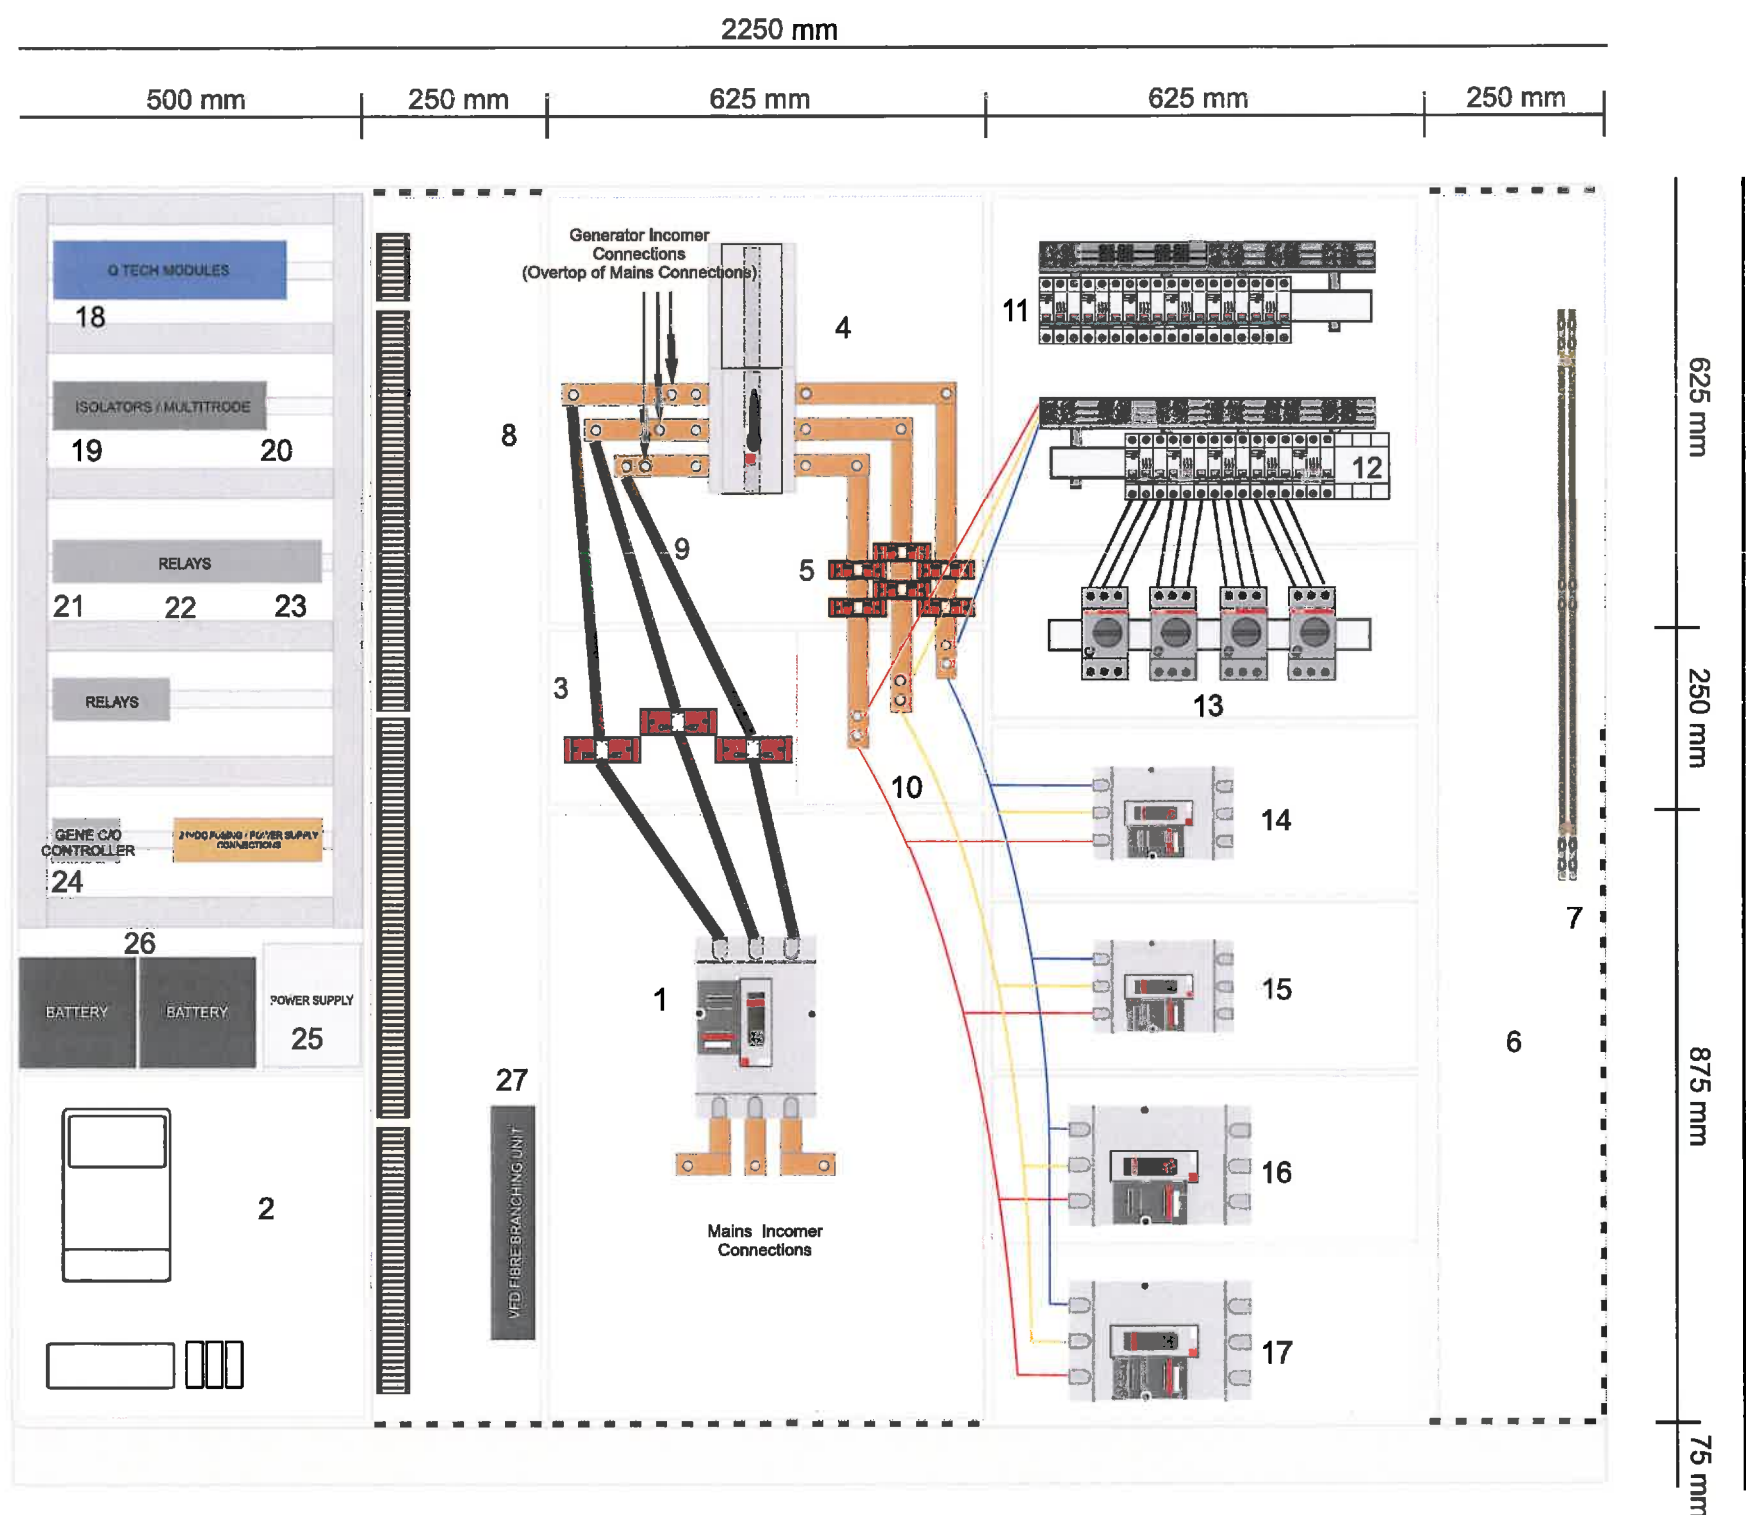

- DETAIL AND EQUIPMENT LIST:**
- 1) Mains Incomer MCCB - ABB 400 Amp T5N400
 - 2)Tarriff Metering Equipment
 - 3) Tarriff Metering Ct's
 - 4) ABB Motorised Changeover Switch - OTM400E3CM
 - 5) THD Filter (400/5) and Power Analyser (400/1) Ct's
 - 6) Power Circuit Cable Access
 - 7) Earth and Neutral Connection Point
 - 8) Control Circuit Cable Access and Terminal Strip
 - 9) 400 Amp Flexible Power Tails
 - 10) MCCB / Distribution Feed Flexible Tails
 - 11) ABB MCB Distribution - S200 Compact Range
 - 12) Surge Protection Unit - PRD40 3P
 - 13) Booster Pump Isolators - ABB OT63F3
 - 14) THD Filter 1 Supply MCCB - ABB XT1N 160
 - 15) THD Filter 2 Supply MCCB - ABB XT1N 160
 - 16) Bore Pump 1 Supply MCCB - ABB T4N 320
 - 17) Bore Pump 2 Supply MCCB - ABB T4N 320
 - 18) Q Tech Datran Equipment
 - 19) Isolators - Intech XI-L
 - 20) Multitrode Relays - MTR5
 - 21) Phase Fail Relays - Omron K8AB
 - 22) Control Relay - Contaclip/PRD
 - 23) Timing Relay - Omron H3DS-ML
 - 24) Generator Changeover Controller (Existing)
 - 25) 24VDC 10A Power Supply (925.025.71)
 - 26) Batteries (2 x 12VDC 25A/Hr)
 - 27) VFD Fibre Branching Unit

Depth - 350 mm
IP 54
Switchgear - ABB

DOORS OPEN

- - - - - = Gland Plates

22 ROTHERHAM STREET
PO BOX 2034
STOKE NELSON
NEW ZEALAND
PH - +643 547 8301
FX - +643 547 8312
sales@powercontrol.co.nz



	Date	Notes
A	20.11.13	Raise control cabinet. Show gland plates. Add booster pump external isolators.
B	21.11.13	Controls gear tray layout. Ducta covers removed.
C	23.08.14	Layout details and component information added.
D		
E		

Drawn by - LEP	Checked by - QDP	Drawing No. - PCS-99107 - 02	Scale - DNS
Client / Project	RCR Infrastructure - Darfield WTP Project		
Drawing Title	Main Switchboard - General Arrangement Drawing - Doors Open		

Appendix D – Landscaping Plans

N

Existing fence, gates and planting to remain

Removal of existing planting

Removal of grass and topsoil, replacement with loose chip as per existing compound area

Darfield



Pittosporum 'Mountain Green' or similar planted at 1m centers, within 1m wide cultivated and mulched garden border. Irrigation dripper line to planting. Existing fence line extended to surround extended compound area

Environment Canterbury Regional Council; Hurunui District Council; Waimakariri District Council; Timaru District Council; Waimata District Council; Mackenzie District Council; Otago Regional Council; LINZ; NIWA, <http://creativecommons.org/licenses/by/3.0/nz/>


Selwyn
DISTRICT COUNCIL

0 5 10 15 20
Metres

Date: 29/07/2020
Cadastral Information derived from Land Information New Zealand's Digital Cadastral Database (DCDB)
CROWN COPYRIGHT RESERVED
Approved for internal reproduction by Selwyn District Council
Digital Licence No.133562-01

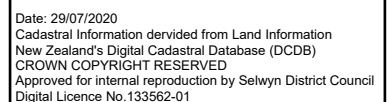

Darfield (WTP) SH73 Landscaping

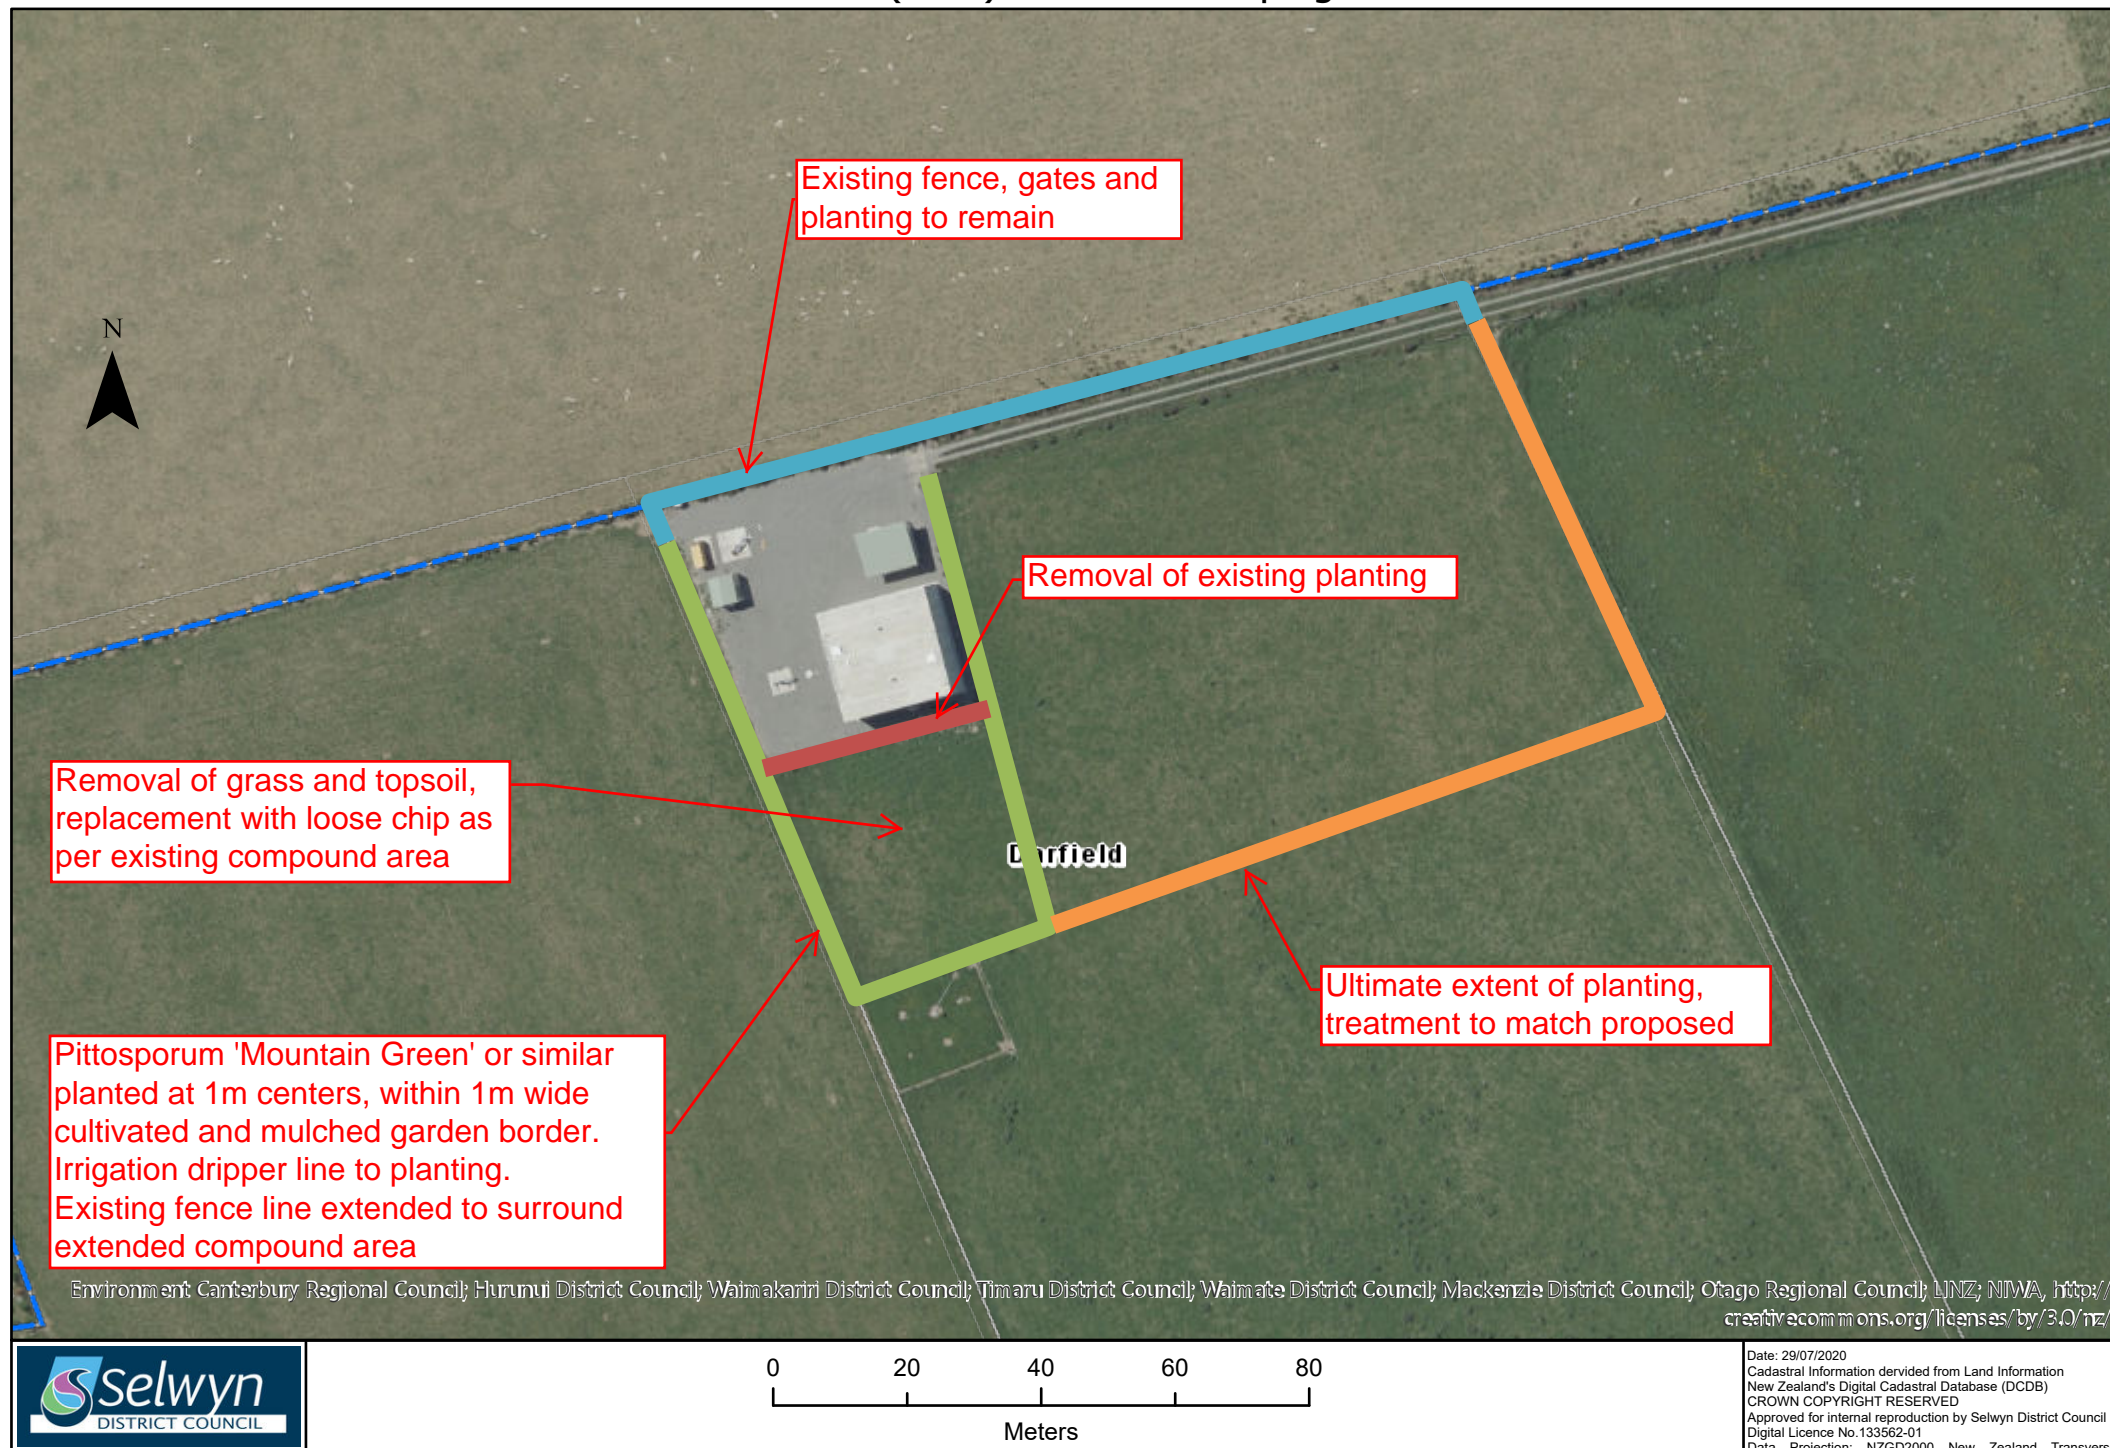

Appendix E – Objectives and Policies of the Canterbury Regional Policy Statement

Objective 5.2.1 Location, design and function of development (Entire Region)

Development is located and designed so that it functions in a way that:

1. achieves consolidated, well designed and sustainable growth in and around existing urban areas as the primary focus for accommodating the region's growth; and
2. enables people and communities, including future generations, to provide for their social, economic and cultural well-being and health and safety; and which:
 - a) maintains, and where appropriate, enhances the overall quality of the natural environment of the Canterbury region, including its coastal environment, outstanding natural features and landscapes, and natural values;
 - b) provides sufficient housing choice to meet the region's housing needs;
 - c) encourages sustainable economic development by enabling business activities in appropriate locations;
 - d) minimises energy use and/or improves energy efficiency;
 - e) enables rural activities that support the rural environment including primary production;
 - f) is compatible with, and will result in the continued safe, efficient and effective use of regionally significant infrastructure;
 - g) avoids adverse effects on significant natural and physical resources including regionally significant infrastructure, and where avoidance is impracticable, remedies or mitigates those effects on those resources and infrastructure;
 - h) facilitates the establishment of papakāinga and marae; and
 - i) avoids conflicts between incompatible activities.

5.2.2 Integration of land-use and regionally significant infrastructure (Wider Region)

In relation to the integration of land use and regionally significant infrastructure:

1. To recognise the benefits of enabling people and communities to provide for their social, economic and cultural well-being and health and safety and to provide for infrastructure that is regionally significant to the extent that it promotes sustainable management in accordance with the RMA.
2. To achieve patterns and sequencing of land-use with regionally significant infrastructure in the wider region so that:
 - a) development does not result in adverse effects on the operation, use and development of regionally significant infrastructure.
 - b) adverse effects resulting from the development or operation of regionally significant infrastructure are avoided, remedied or mitigated as fully as practicable.
 - c) there is increased sustainability, efficiency and liveability.

5.3.2 Development conditions (Wider Region)

To enable development including regionally significant infrastructure which:

1. ensure that adverse effects are avoided, remedied or mitigated, including where these would compromise or foreclose :
 - a) existing or consented regionally significant infrastructure;
 - b) options for accommodating the consolidated growth and development of existing urban areas;
 - c) the productivity of the region's soil resources, without regard to the need to make appropriate use of soil which is valued for existing or foreseeable future primary production, or through further fragmentation of rural land;
 - d) the protection of sources of water for community supplies;
 - e) significant natural and physical resources;
2. avoid or mitigate:
 - a) natural and other hazards, or land uses that would likely result in increases in the frequency and/or severity of hazards;
 - b) reverse sensitivity effects and conflicts between incompatible activities, including identified mineral extraction areas; and
3. integrate with:
 - a) the efficient and effective provision, maintenance or upgrade of infrastructure; and
 - b) transport networks, connections and modes so as to provide for the sustainable and efficient movement of people, goods and services, and a logical, permeable and safe transport system.

5.3.5 Servicing development for potable water, and sewage and stormwater disposal (Wider Region)

Within the wider region, ensure development is appropriately and efficiently served for the collection, treatment, disposal or re-use of sewage and stormwater, and the provision of potable water, by:

1. avoiding development which will not be served in a timely manner to avoid or mitigate adverse effects on the environment and human health; and
2. requiring these services to be designed, built, managed or upgraded to maximise their on-going effectiveness.

5.3.6 Sewerage, stormwater and potable water infrastructure (Wider Region)

Within the wider region:

1. Avoid development which constrains the on-going ability of the existing sewerage, stormwater and potable water supply infrastructure to be developed and used.
2. Enable sewerage, stormwater and potable water infrastructure to be developed and used, provided that, as a result of its location and design:
 - a) the adverse effects on significant natural and physical resources are avoided, or where this is not practicable, mitigated; and
 - b) other adverse effects on the environment are appropriately controlled.
3. Discourage sewerage, stormwater and potable water supply infrastructure which will promote development in locations which do not meet Policy 5.3.1.

5.3.9 Regionally significant infrastructure (Wider Region)

In relation to regionally significant infrastructure (including transport hubs):

1. avoid development which constrains the ability of this infrastructure to be developed and used without time or other operational constraints that may arise from adverse effects relating to reverse sensitivity or safety;
2. provide for the continuation of existing infrastructure, including its maintenance and operation, without prejudice to any future decision that may be required for the ongoing operation or expansion of that infrastructure; and
3. provide for the expansion of existing infrastructure and development of new infrastructure, while:
 - a) recognising the logistical, technical or operational constraints of this infrastructure and any need to locate activities where a natural or physical resource base exists;
 - b) avoiding any adverse effects on significant natural and physical resources and cultural values and where this is not practicable, remedying or mitigating them, and appropriately controlling other adverse effects on the environment; and
 - c) when determining any proposal within a sensitive environment (including any environment the subject of section 6 of the RMA), requiring that alternative sites, routes, methods and design of all components and associated structures are considered so that the proposal satisfies sections 5(2)(a) – (c) as fully as is practicable.

GHD

Level 3

138 Victoria Street



T: 64 3 378 0900 F: E: chcmail@ghd.com

© GHD 2020

This document is and shall remain the property of GHD. The document may only be used for the purpose for which it was commissioned and in accordance with the Terms of Engagement for the commission. Unauthorised use of this document in any form whatsoever is prohibited.

Darfield Water Treatment Facility – Notice of Requirement

Document Status

Revision	Author	Reviewer		Approved for Issue		
		Name	Signature	Name	Signature	Date
A	S White	A Callaghan		A Bresler		24/08/2020

www.ghd.com

